

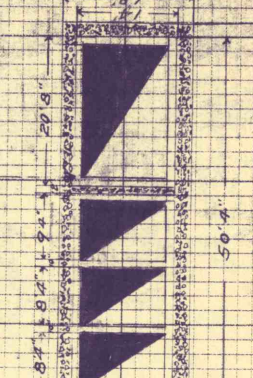



LOOMIS SHAFTS
 HANOVER TOWNSHIP
 LUZERNE CO. PENN.
 Engg. Office: D.P.M.S.M.D. Scale 1"=20'

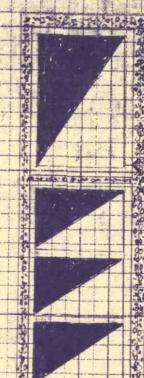

SECTION NO. 2 SHAFT
 LOOKING EAST

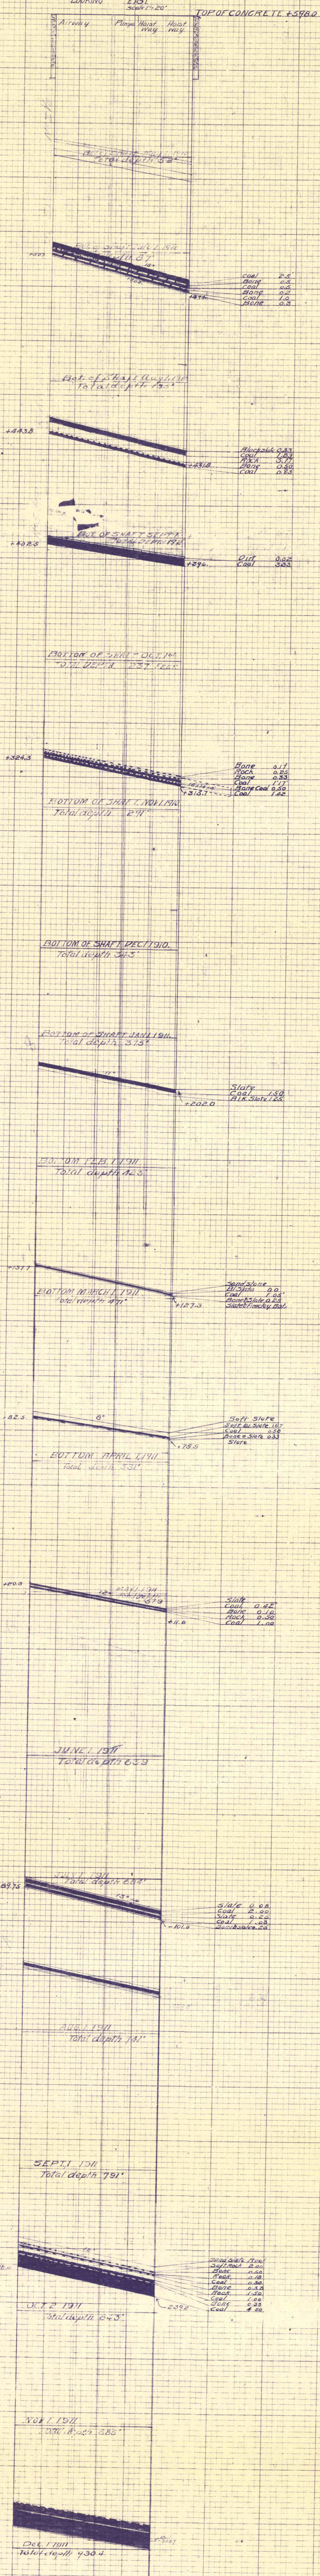

SECTION OF NO. 1 SHAFT
 LOOKING EAST

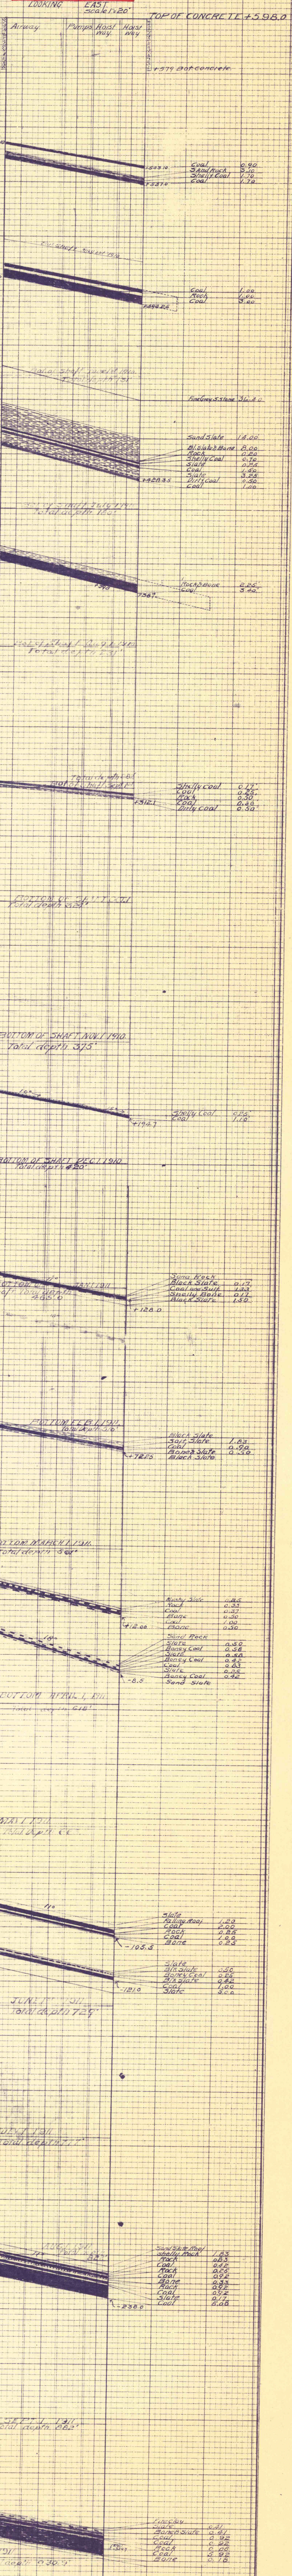



