




**AUCHINCLOSS NO 1**  
ELEV +720.73

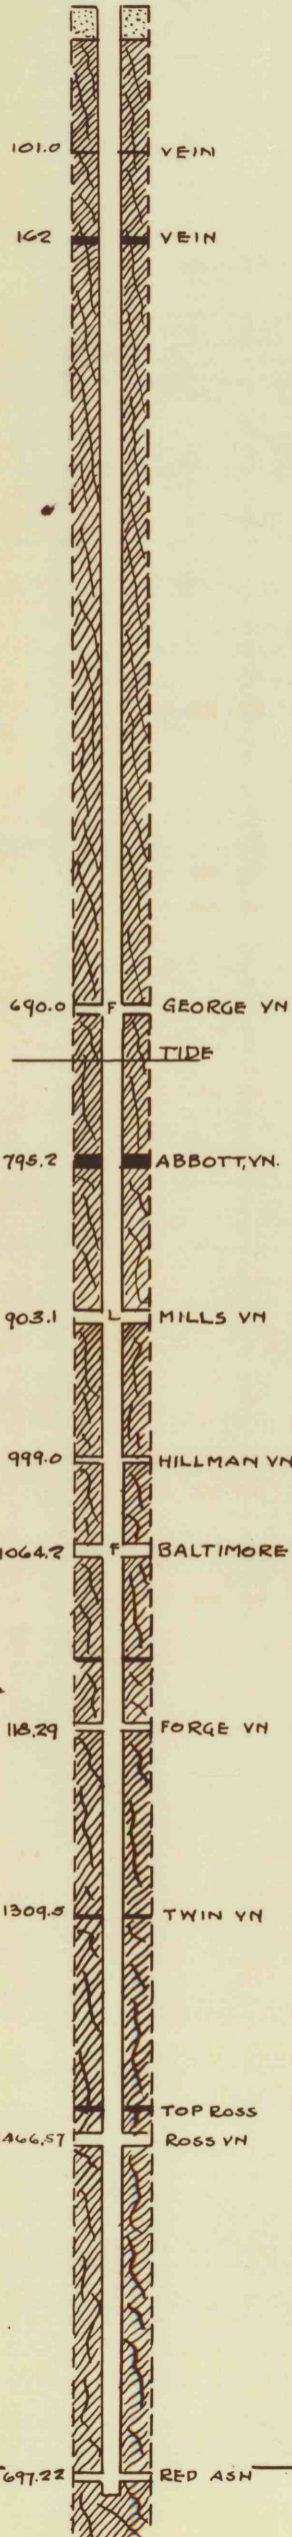


**AUCHINCLOSS NO 2**  
ELEV +721.51

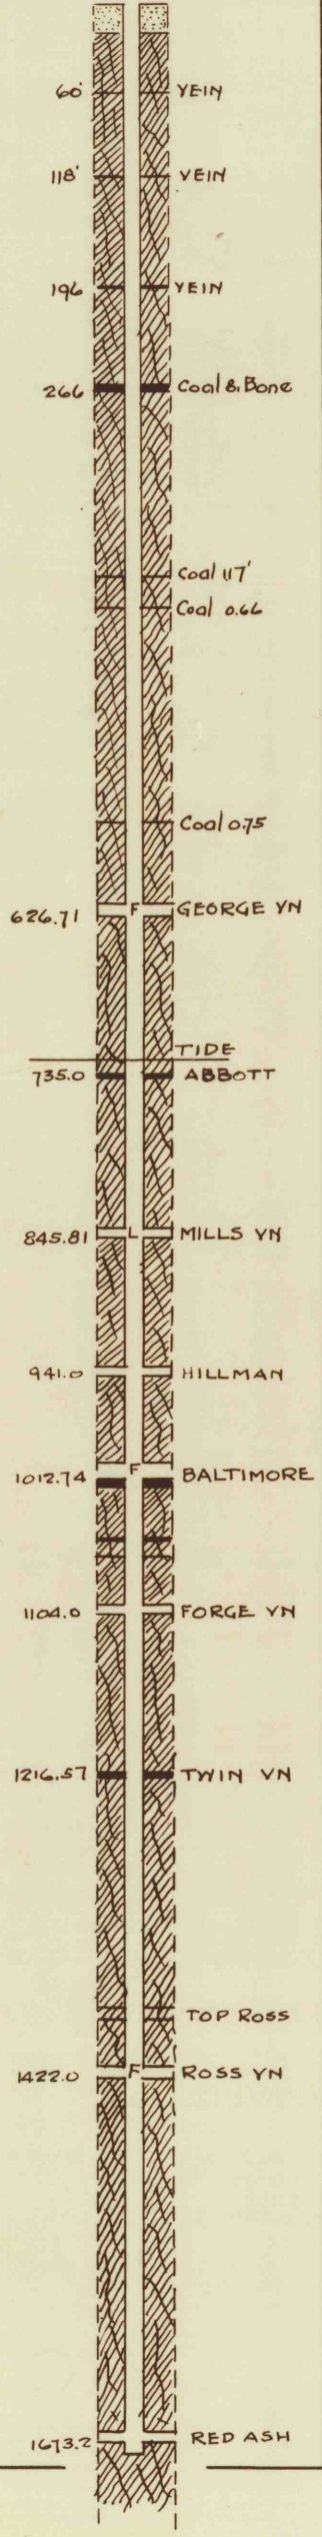


**BLISS NO 1**  
ELEV +744.82

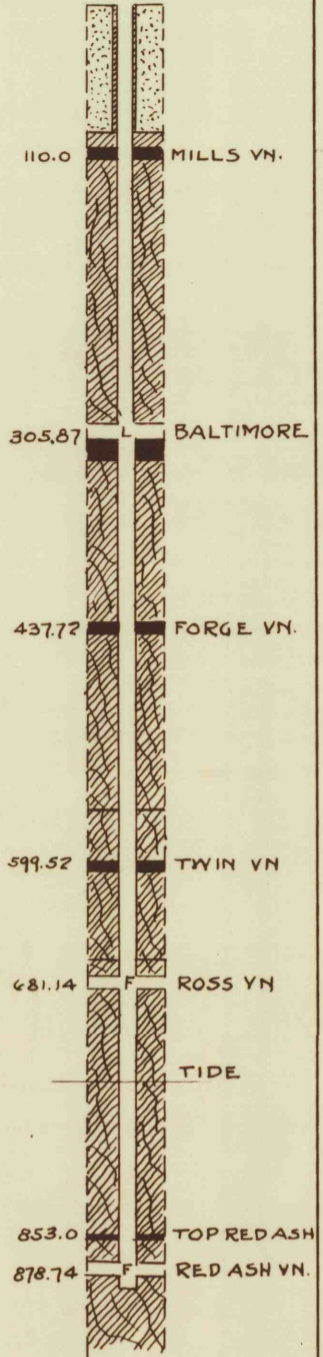


**BLISS NO 2**  
ELEV +742.7

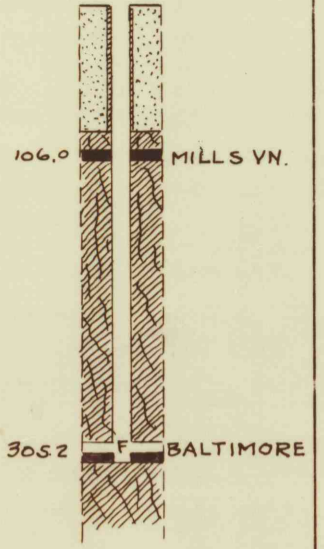

**TRUESDALE NO 1**  
ELEV +723.45

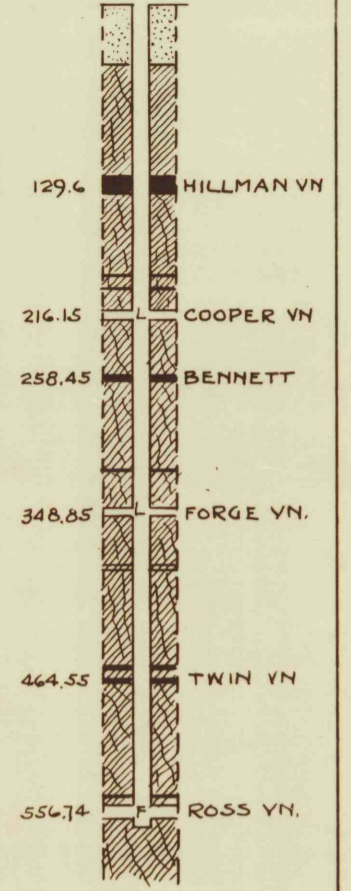

**TRUESDALE NO 2**  
ELEV +722.5

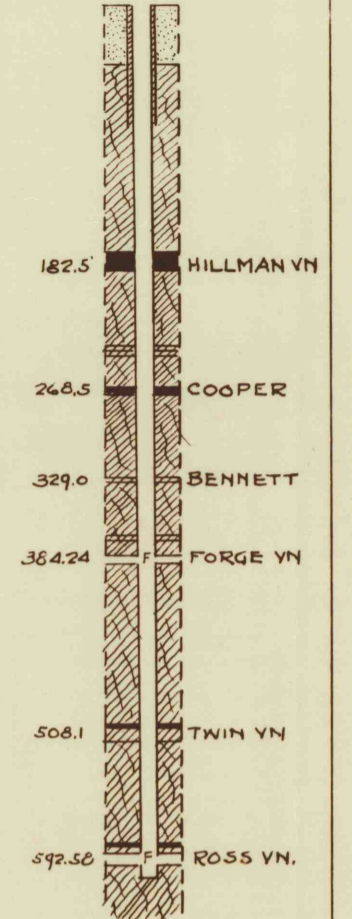

**ASKAM**  
ELEV +620.64

