


NO 15 TRACING NO 14

BOTTOM ROSS

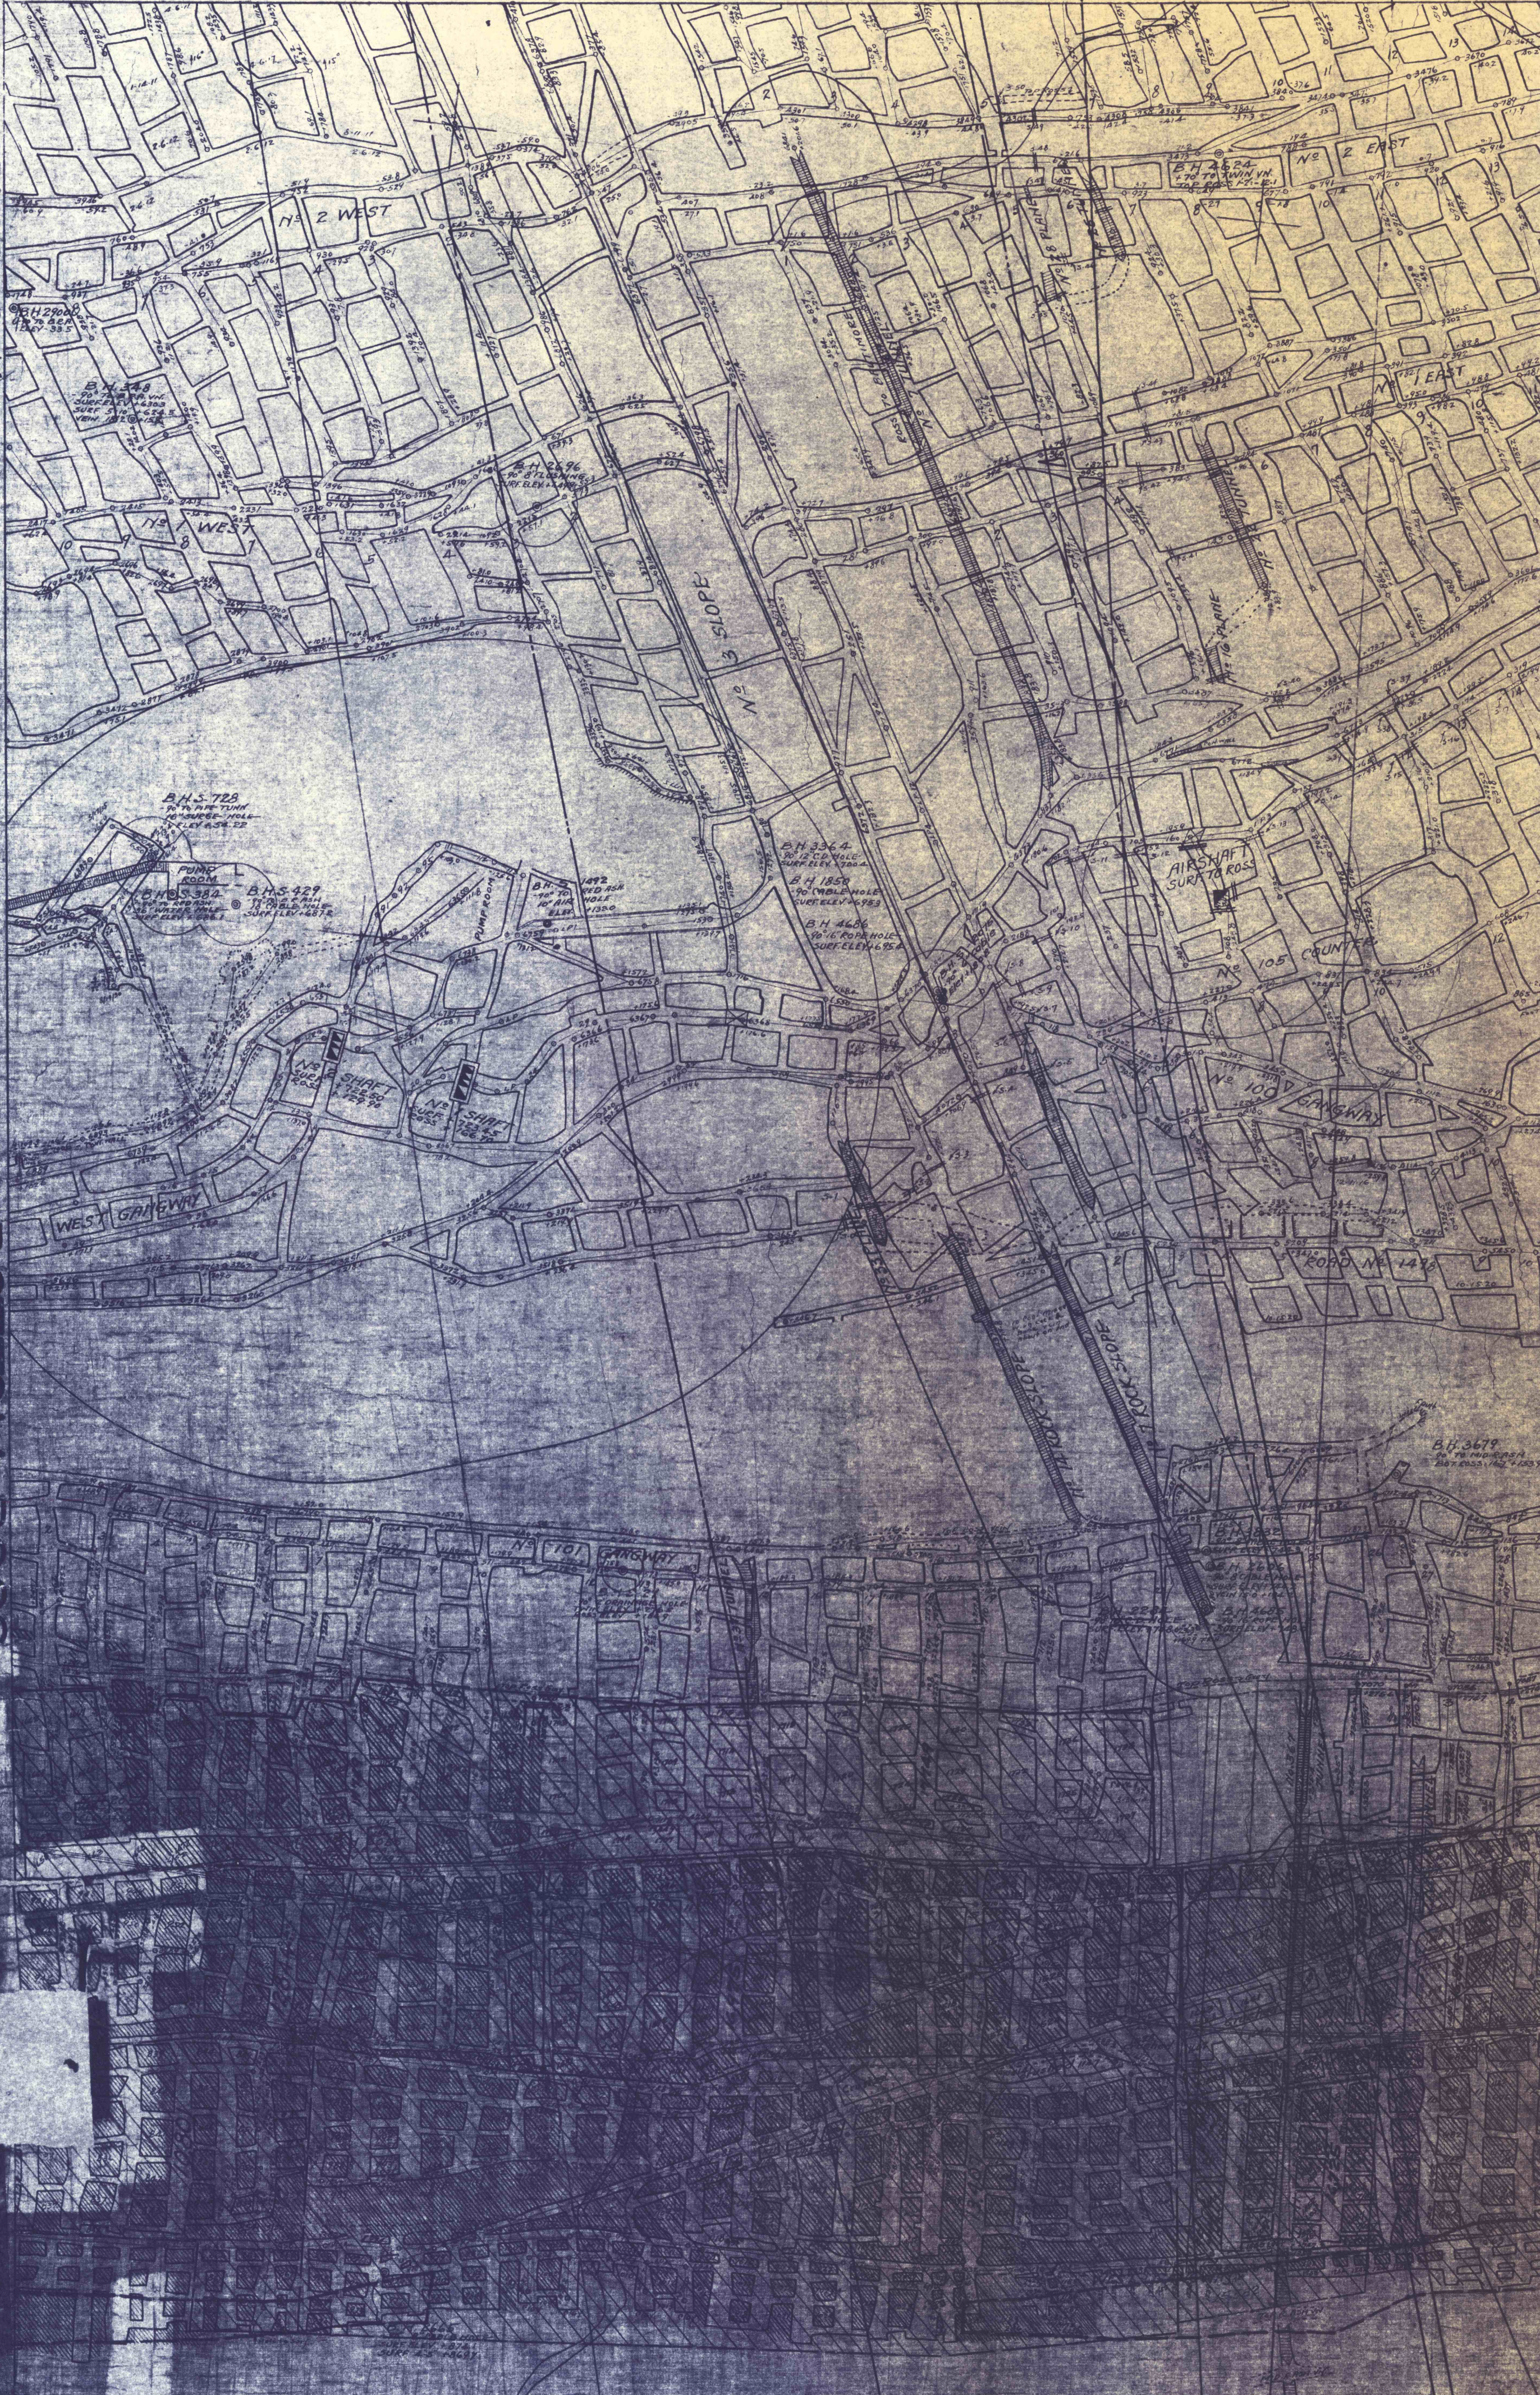

WASHINGTON

LEE No 2

THOMAS  
BEAVER

Bottom Ross