PUMP HOUSE

Slope

1" = 50

55-55

Contour Interval 5f t.
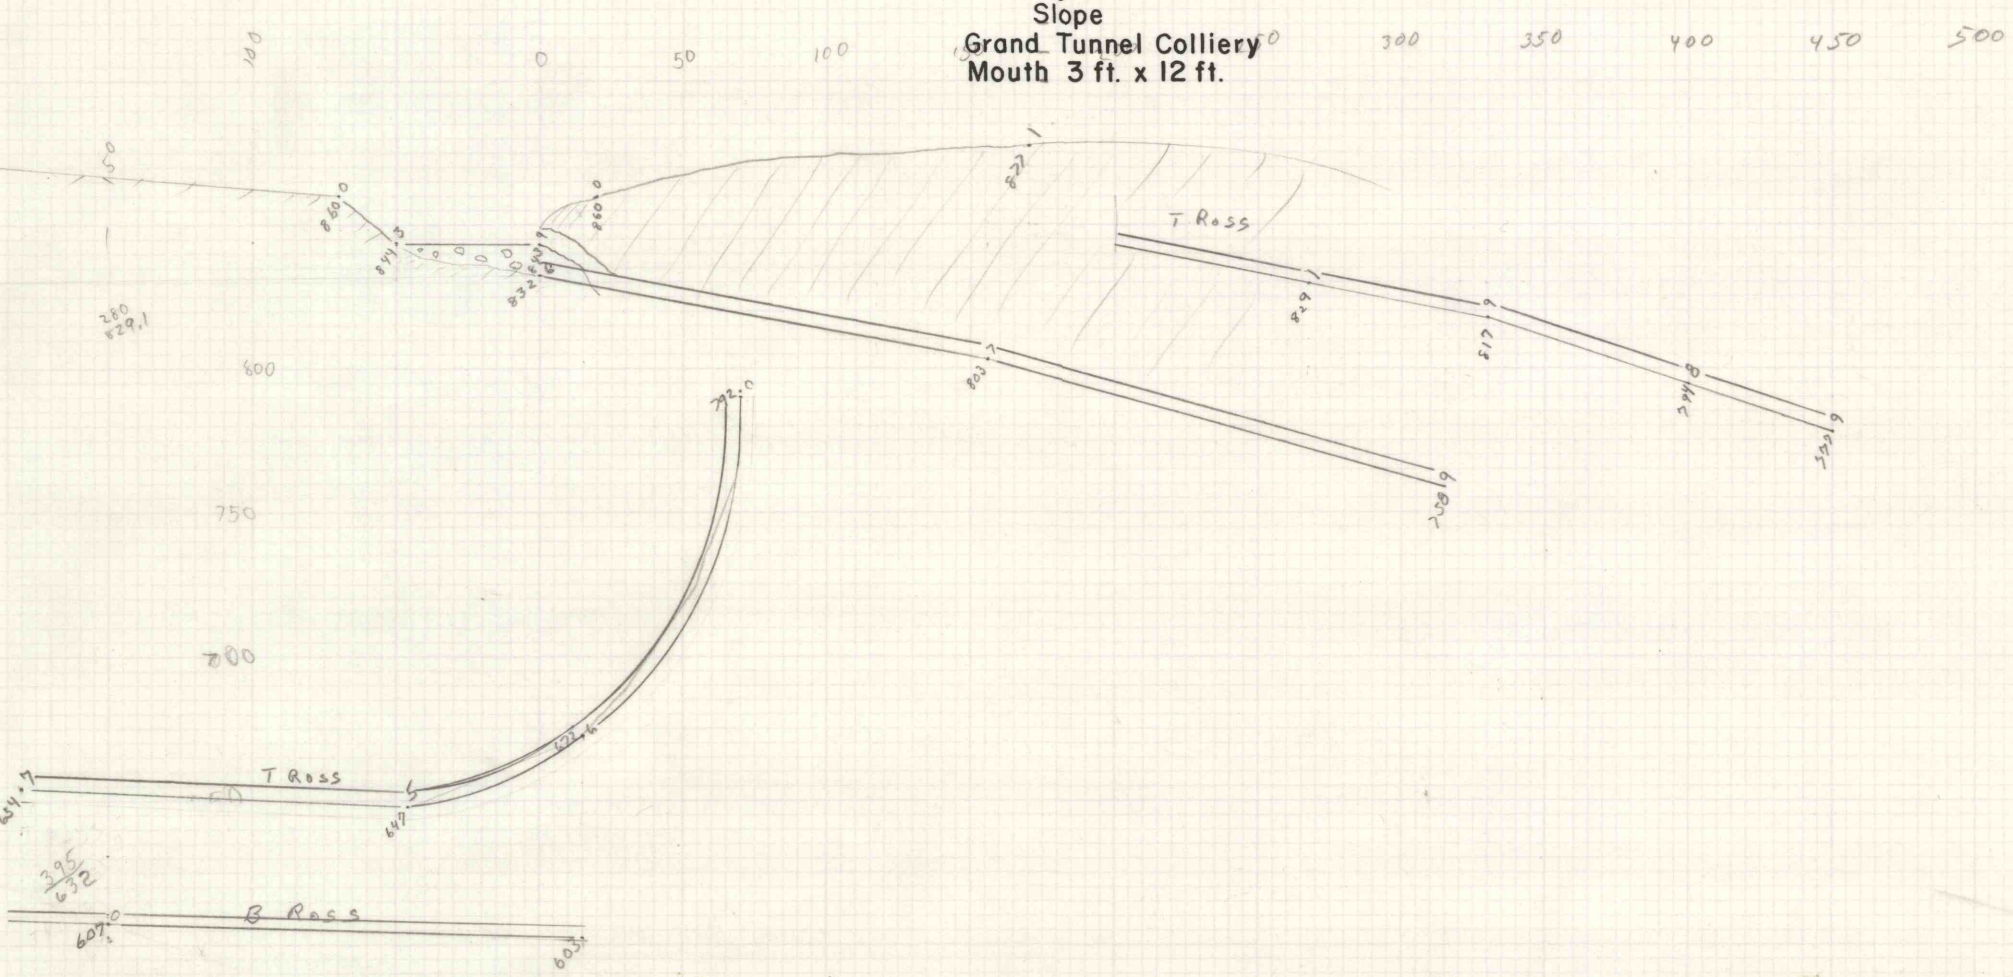
Project
Slope
Grand Tunnel Colliery
Mouth 3 ft. x 12 ft.