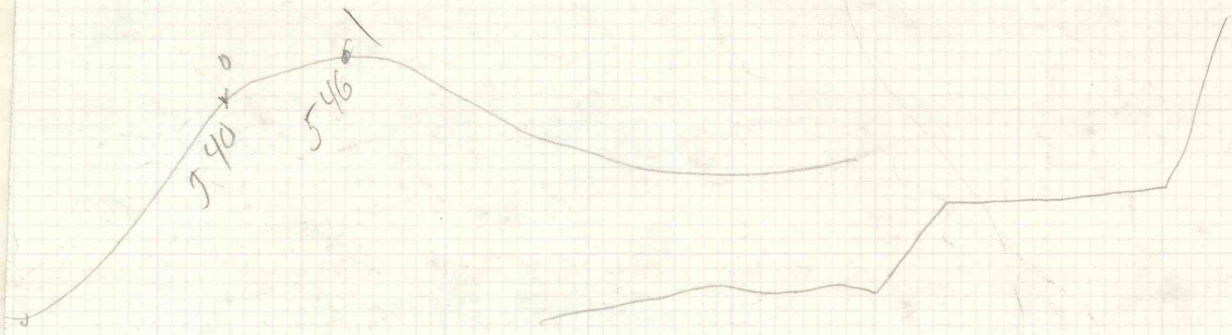

TITLE

CROSS SECTIONS, SURFACE, LOCATION & VICINITY MAPS

DWG. NO.

2 of 4

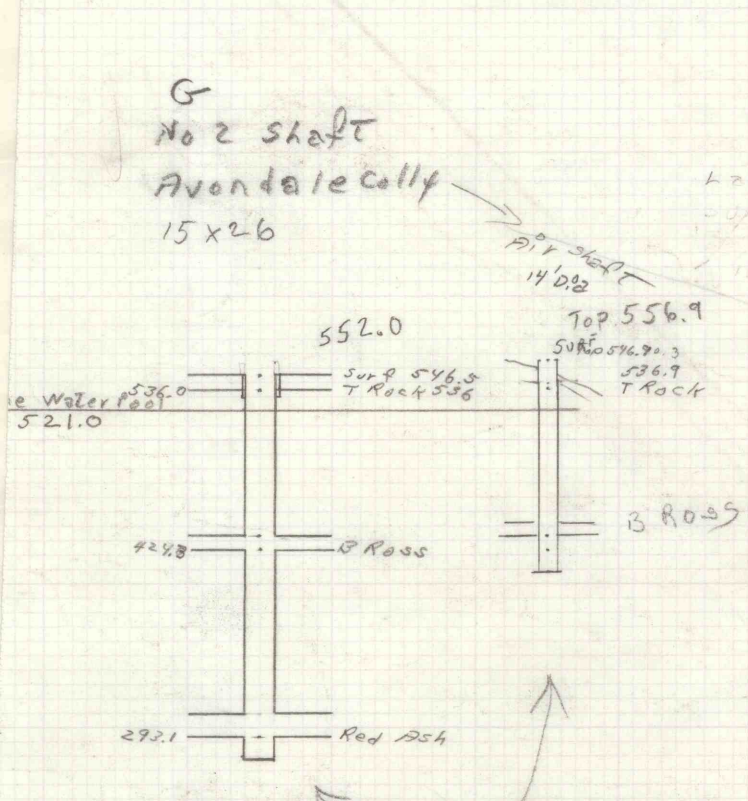

546.5
293.1
253 4
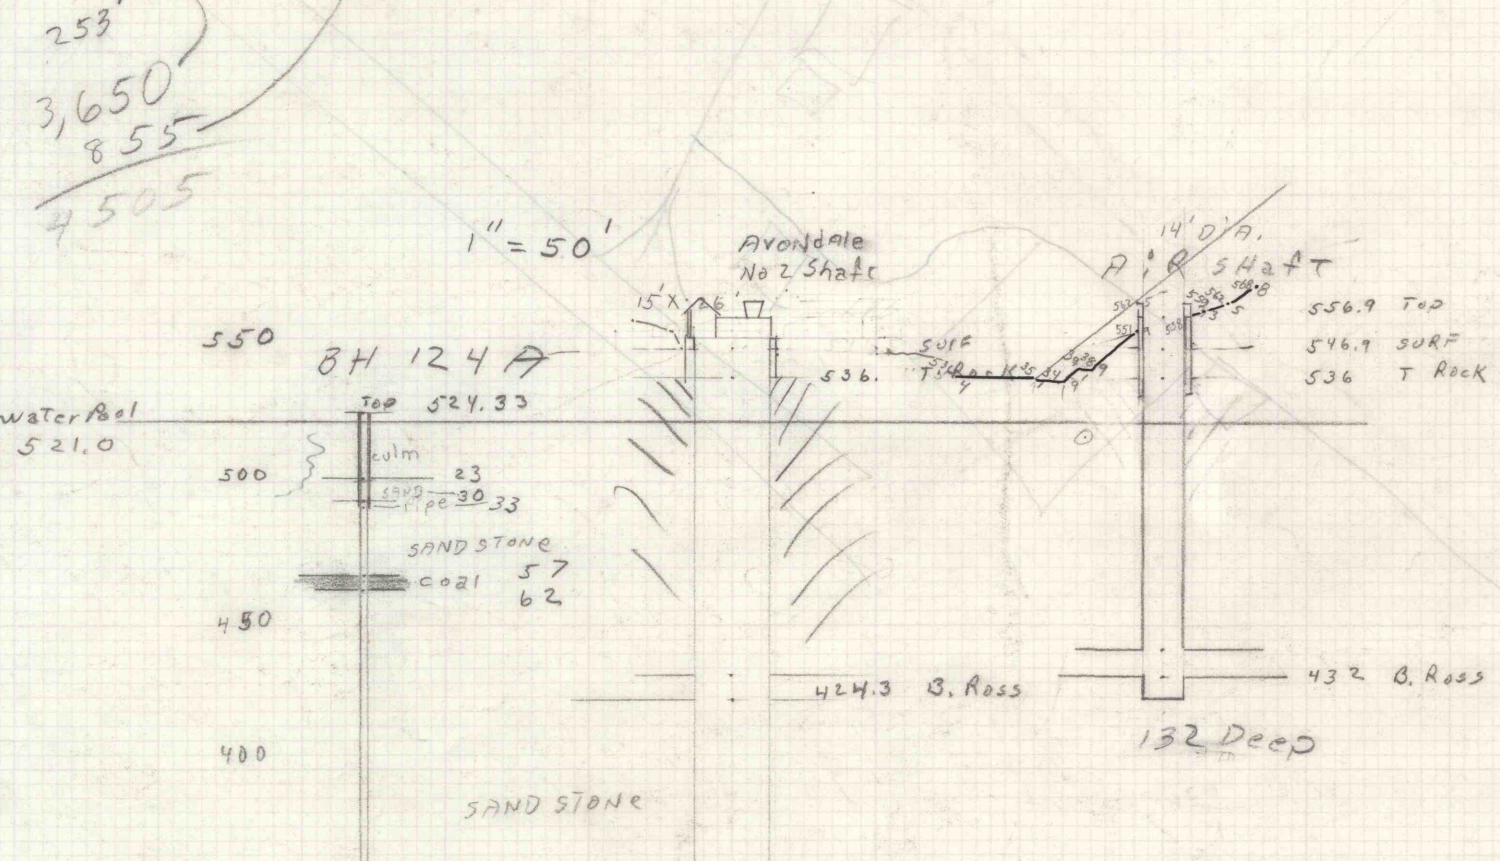
546.9