No. 7 Stanton Shaft
12' x 22'

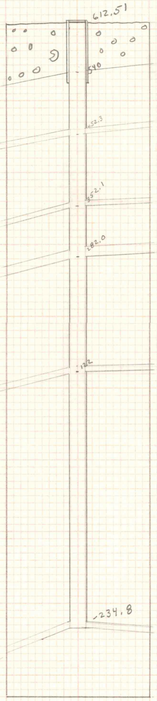


Surface
Top Rock
Abbott
Kidney
Hillman
Stanton
Baltimore