


ISI 024-1003 - 1-2

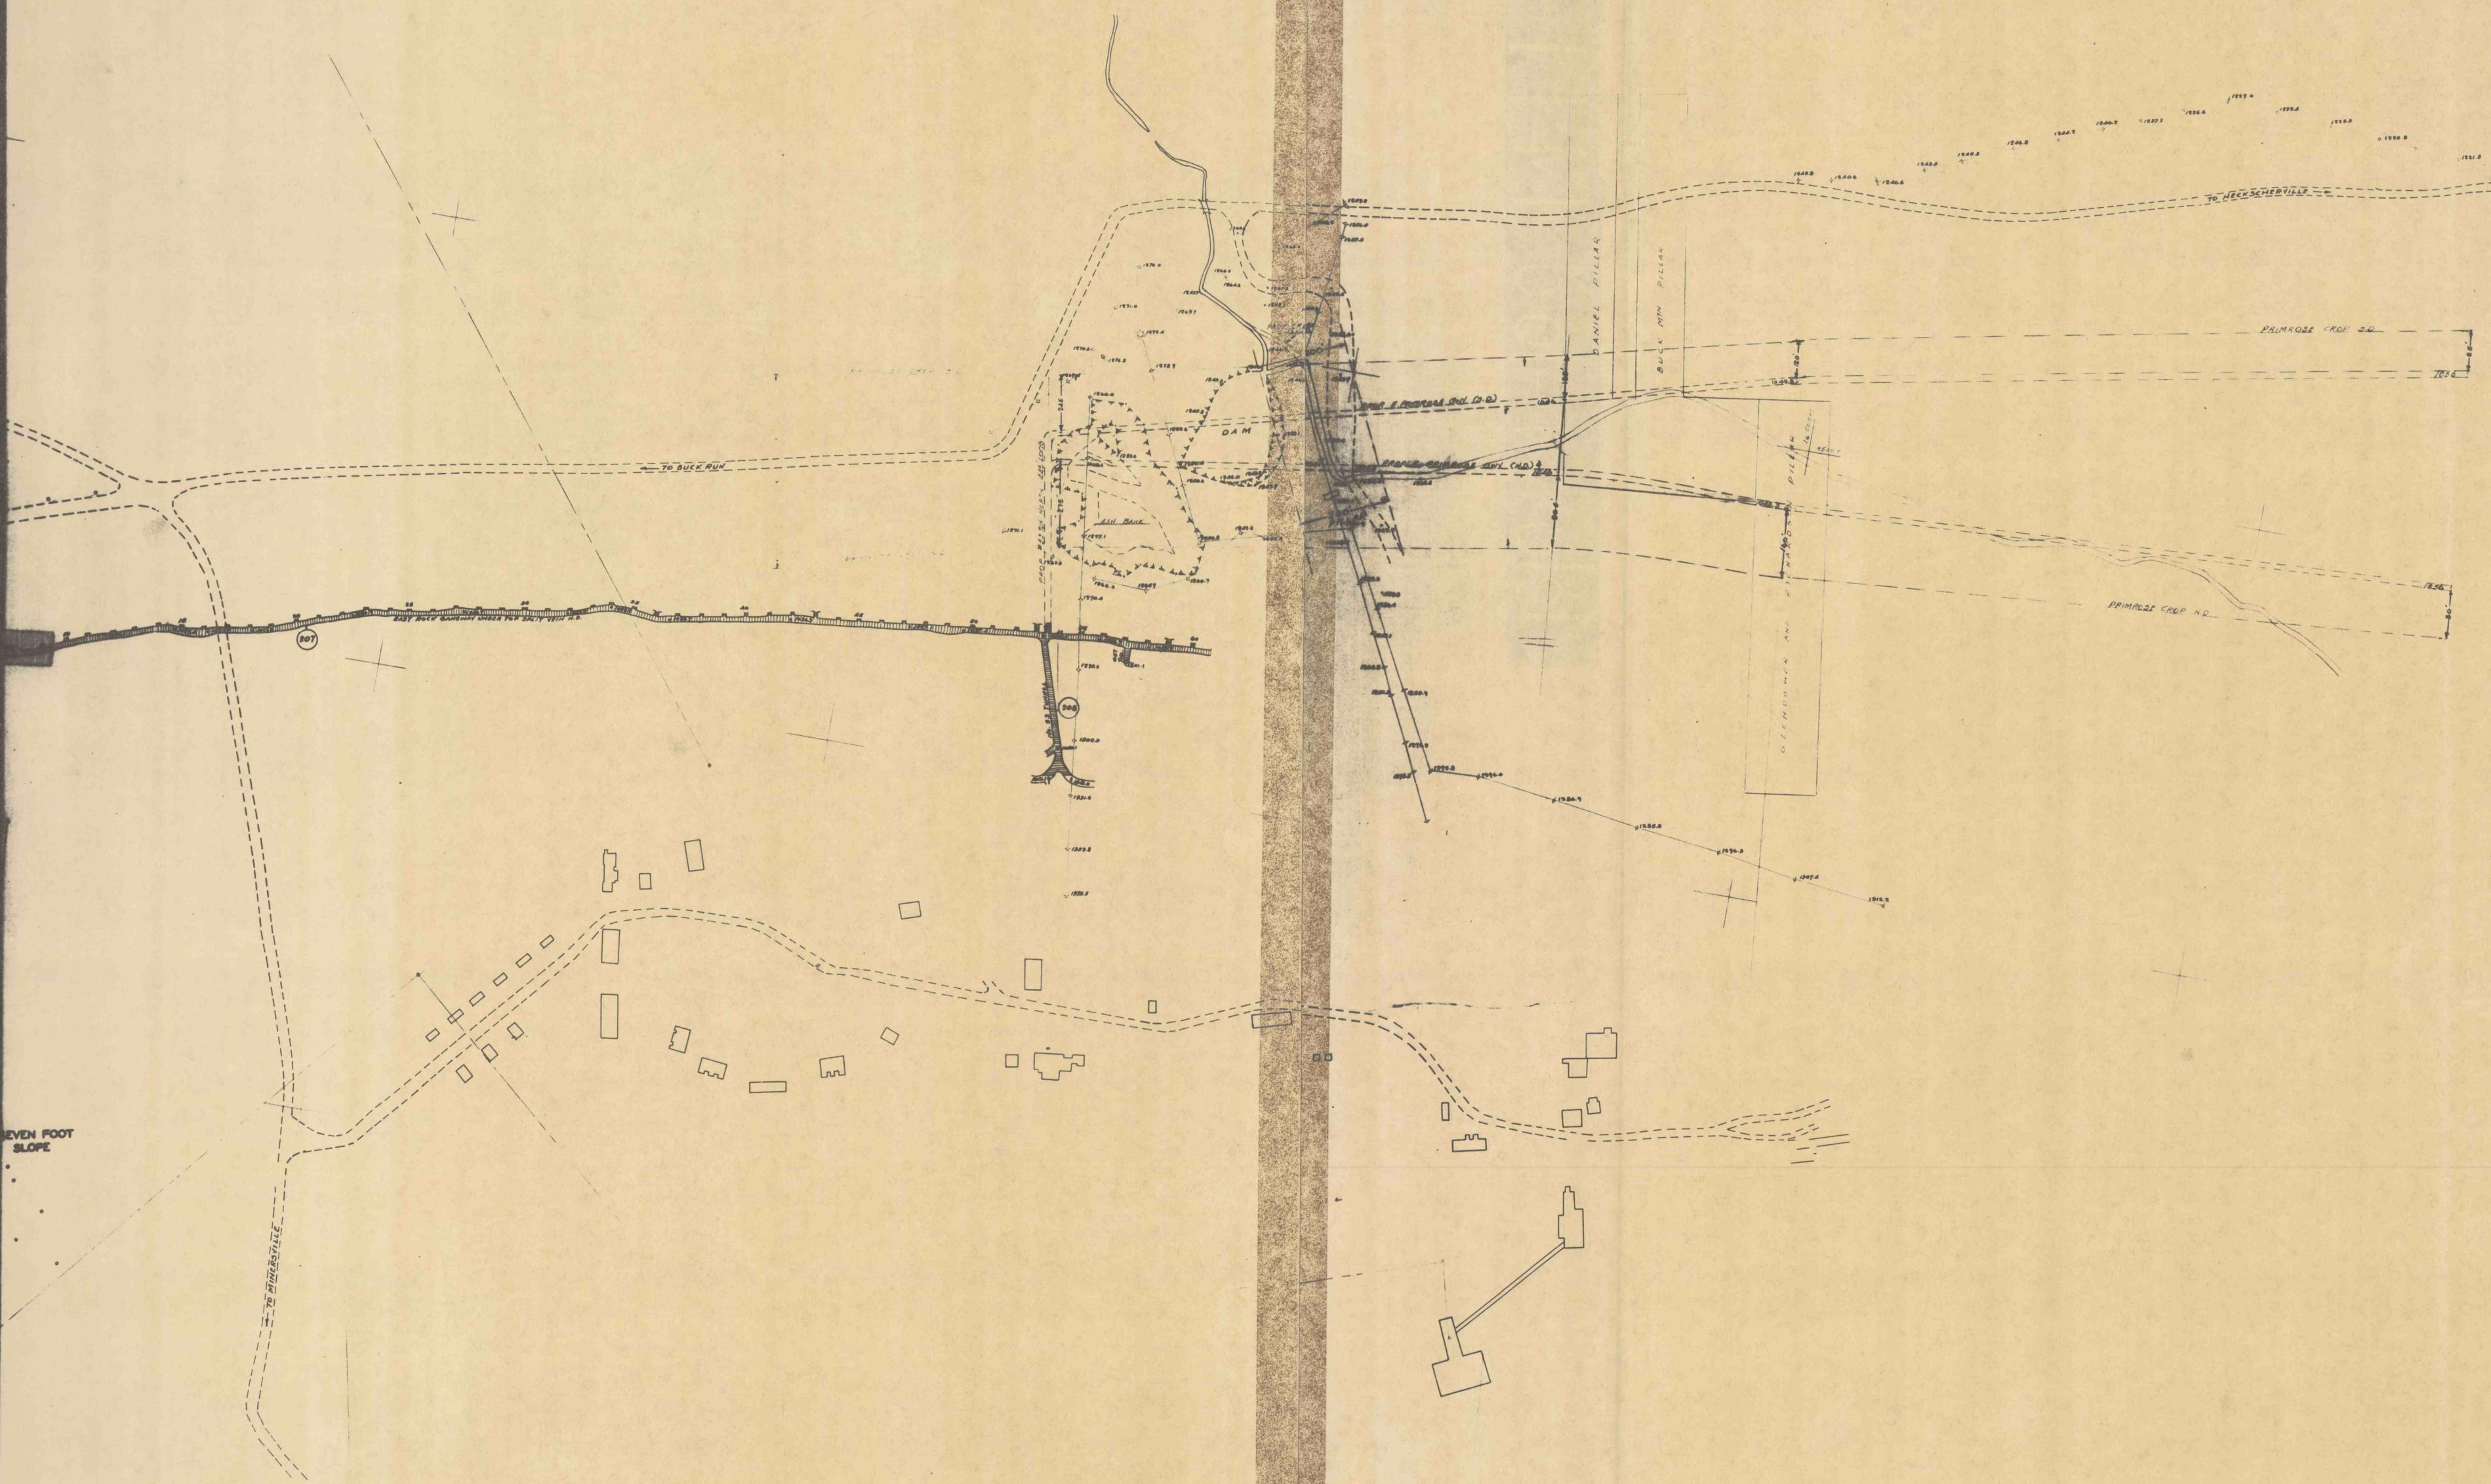

Primrose

Primrose