


No 4 Air Shaft HUBER COLIY

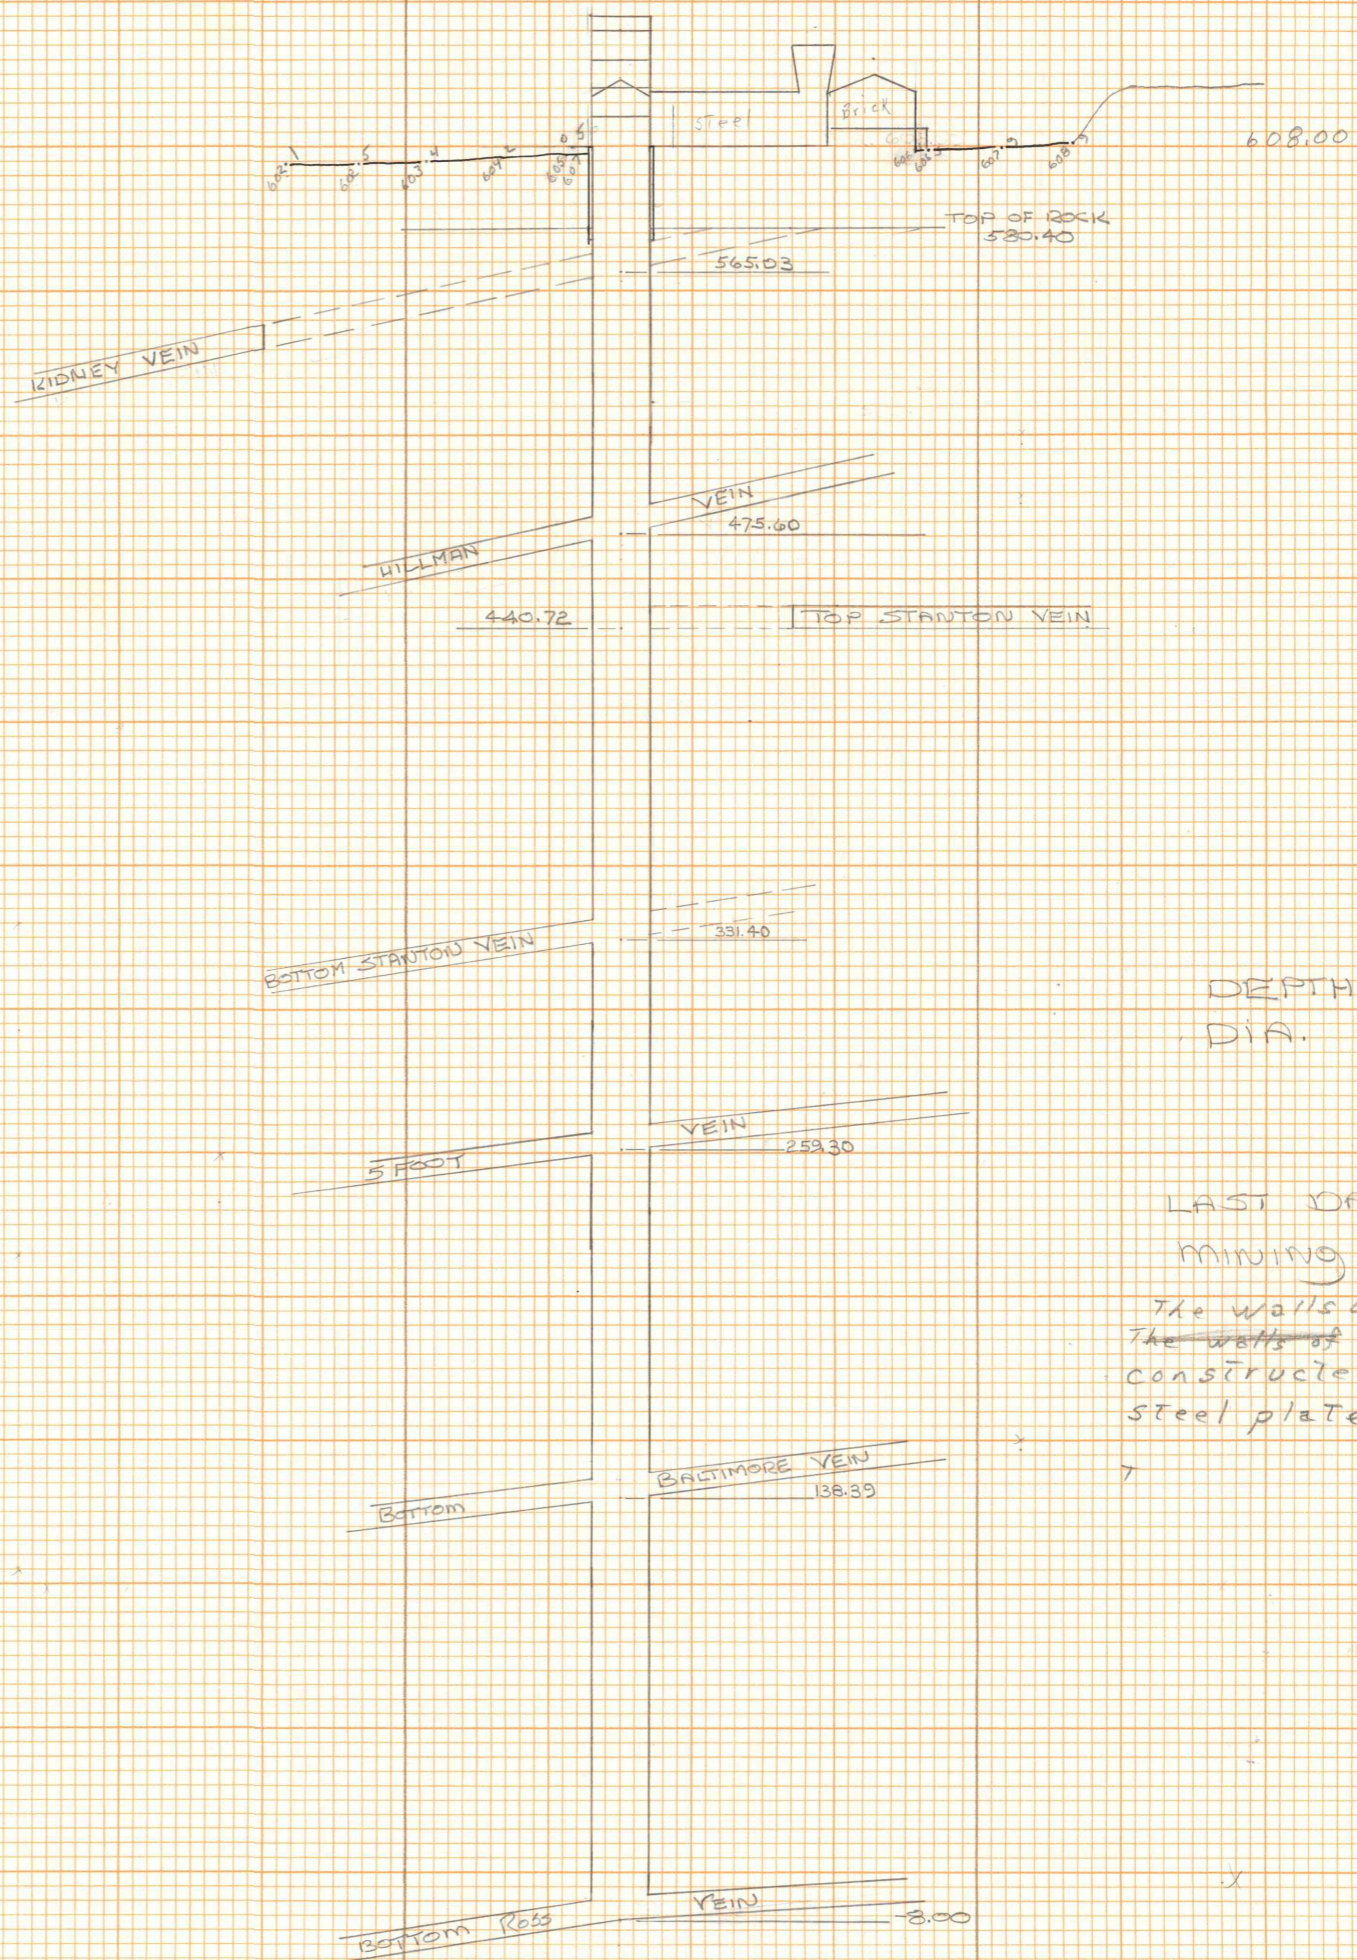

DEPTH 616.00'
DIA. 20'

LAST DATE OF
MINING 2/18/63

The walls of
The walls of the #4 shaft are
constructed of concrete with
steel plate covering the opening

1" = 50'

17
24

11061
21.22

KE
10 X 10 TO THE INCH
KEUFFEL & ESSER CO.
PRINTED IN U.S.A.
781000

23

10014

87.20

2

2262

2

5.53

235

26.73

42.1

5.58

21

553.67

563.03

1214

117.6

11061

21.22

11061

5/11/63

2