


5555

167
1207.4
266

10,500

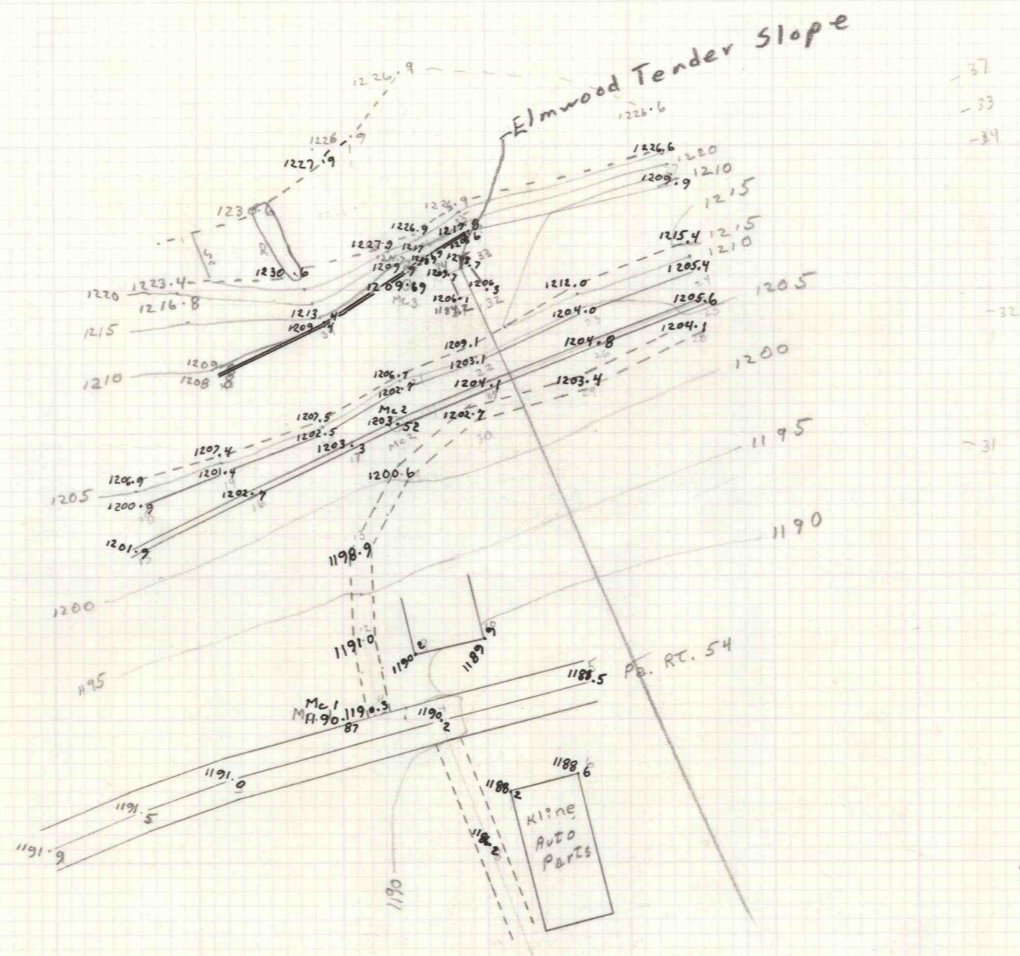

10,000

1206.6
11.8
<hr/>
1178.8

9,500

9,500

10,000

10,500

Elmwood Tender Slope