



B

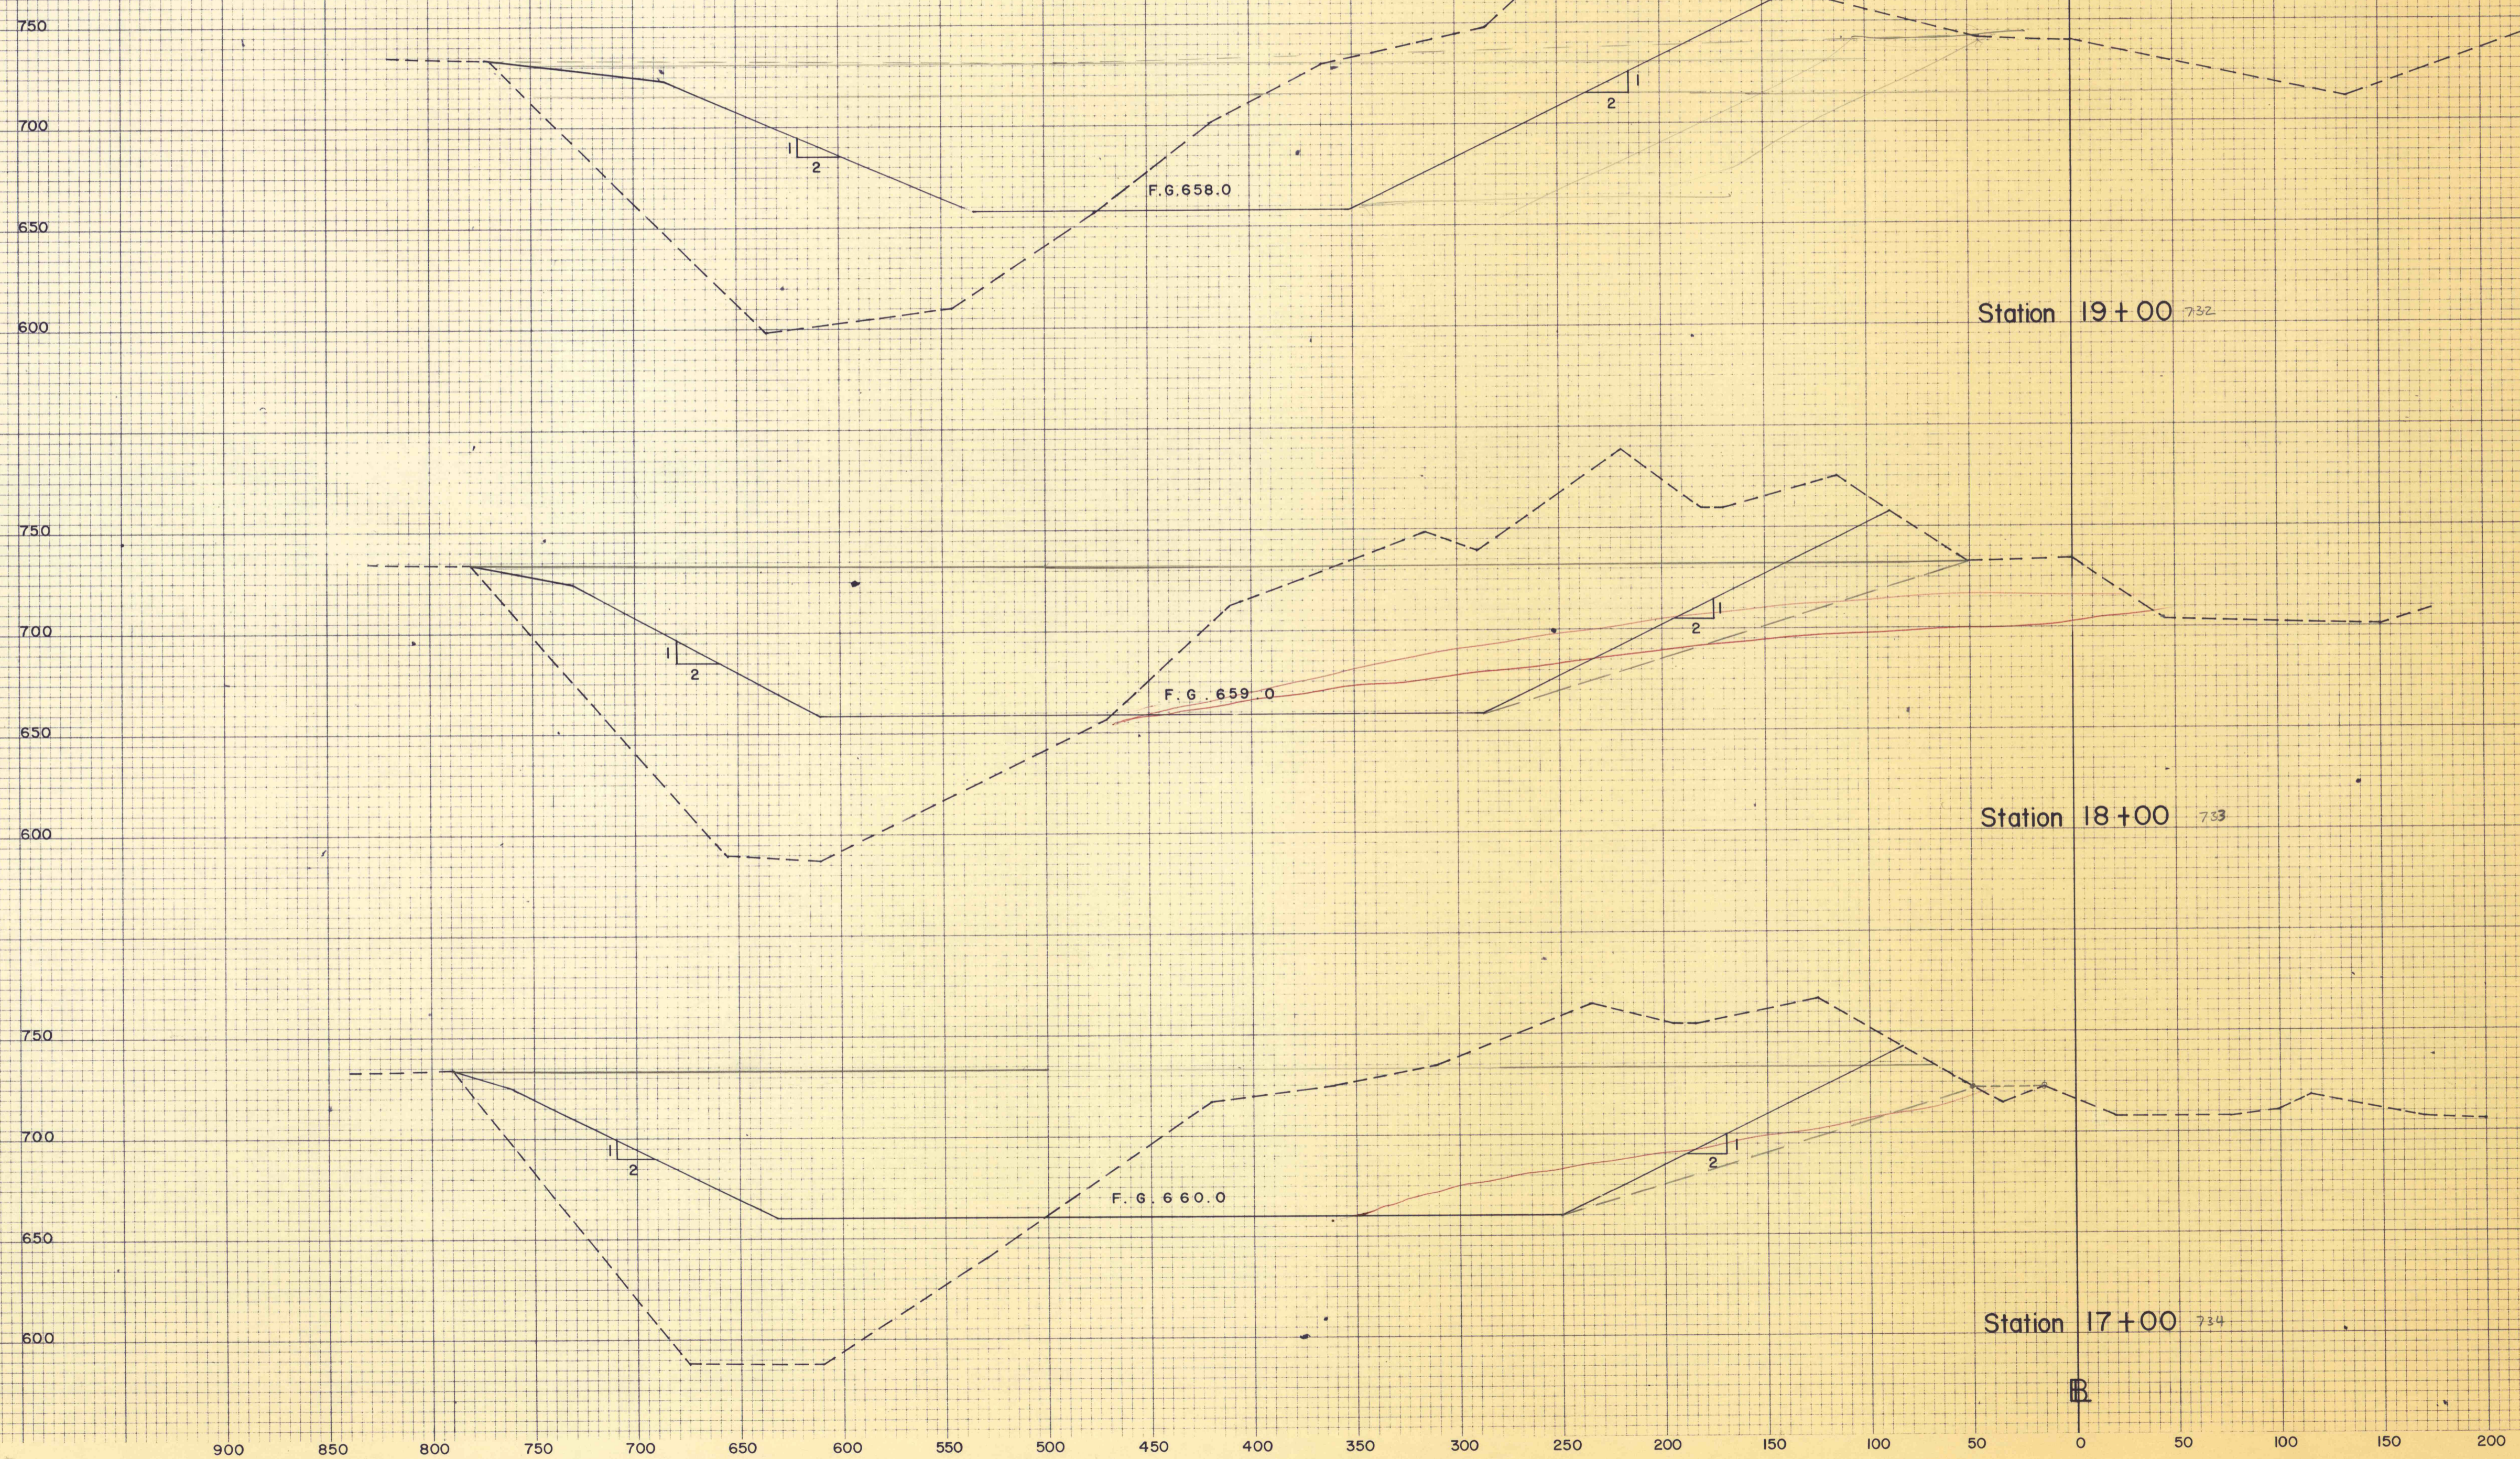

NO.	DATE	REVISION	APPR.
SUBMITTED			
DESIGNED			
APPROVED			
APPROVED			

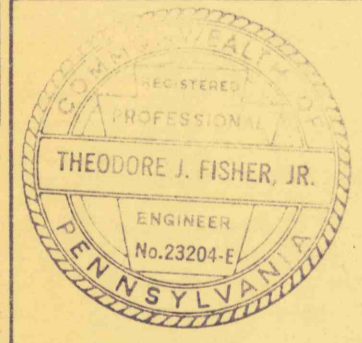

COMMONWEALTH OF PENNSYLVANIA
DEPARTMENT OF ENVIRONMENTAL RESOURCES
OFFICE OF RESOURCES MANAGEMENT

PROJECT NO. O.S.M. 40(041-80)101.1

RECLAMATION
PLAINS TOWNSHIP STRIP PIT
PLAINS TWP, LUZERNE CO., PA.

CROSS SECTIONS
Stations 17+00 To 19+00

DRAWN BY	DATE 8/29/80	DRAWING NO.
CHECKED BY	SCALE 1 in = 50 ft	8 of 9