


Total Cut
1025.6

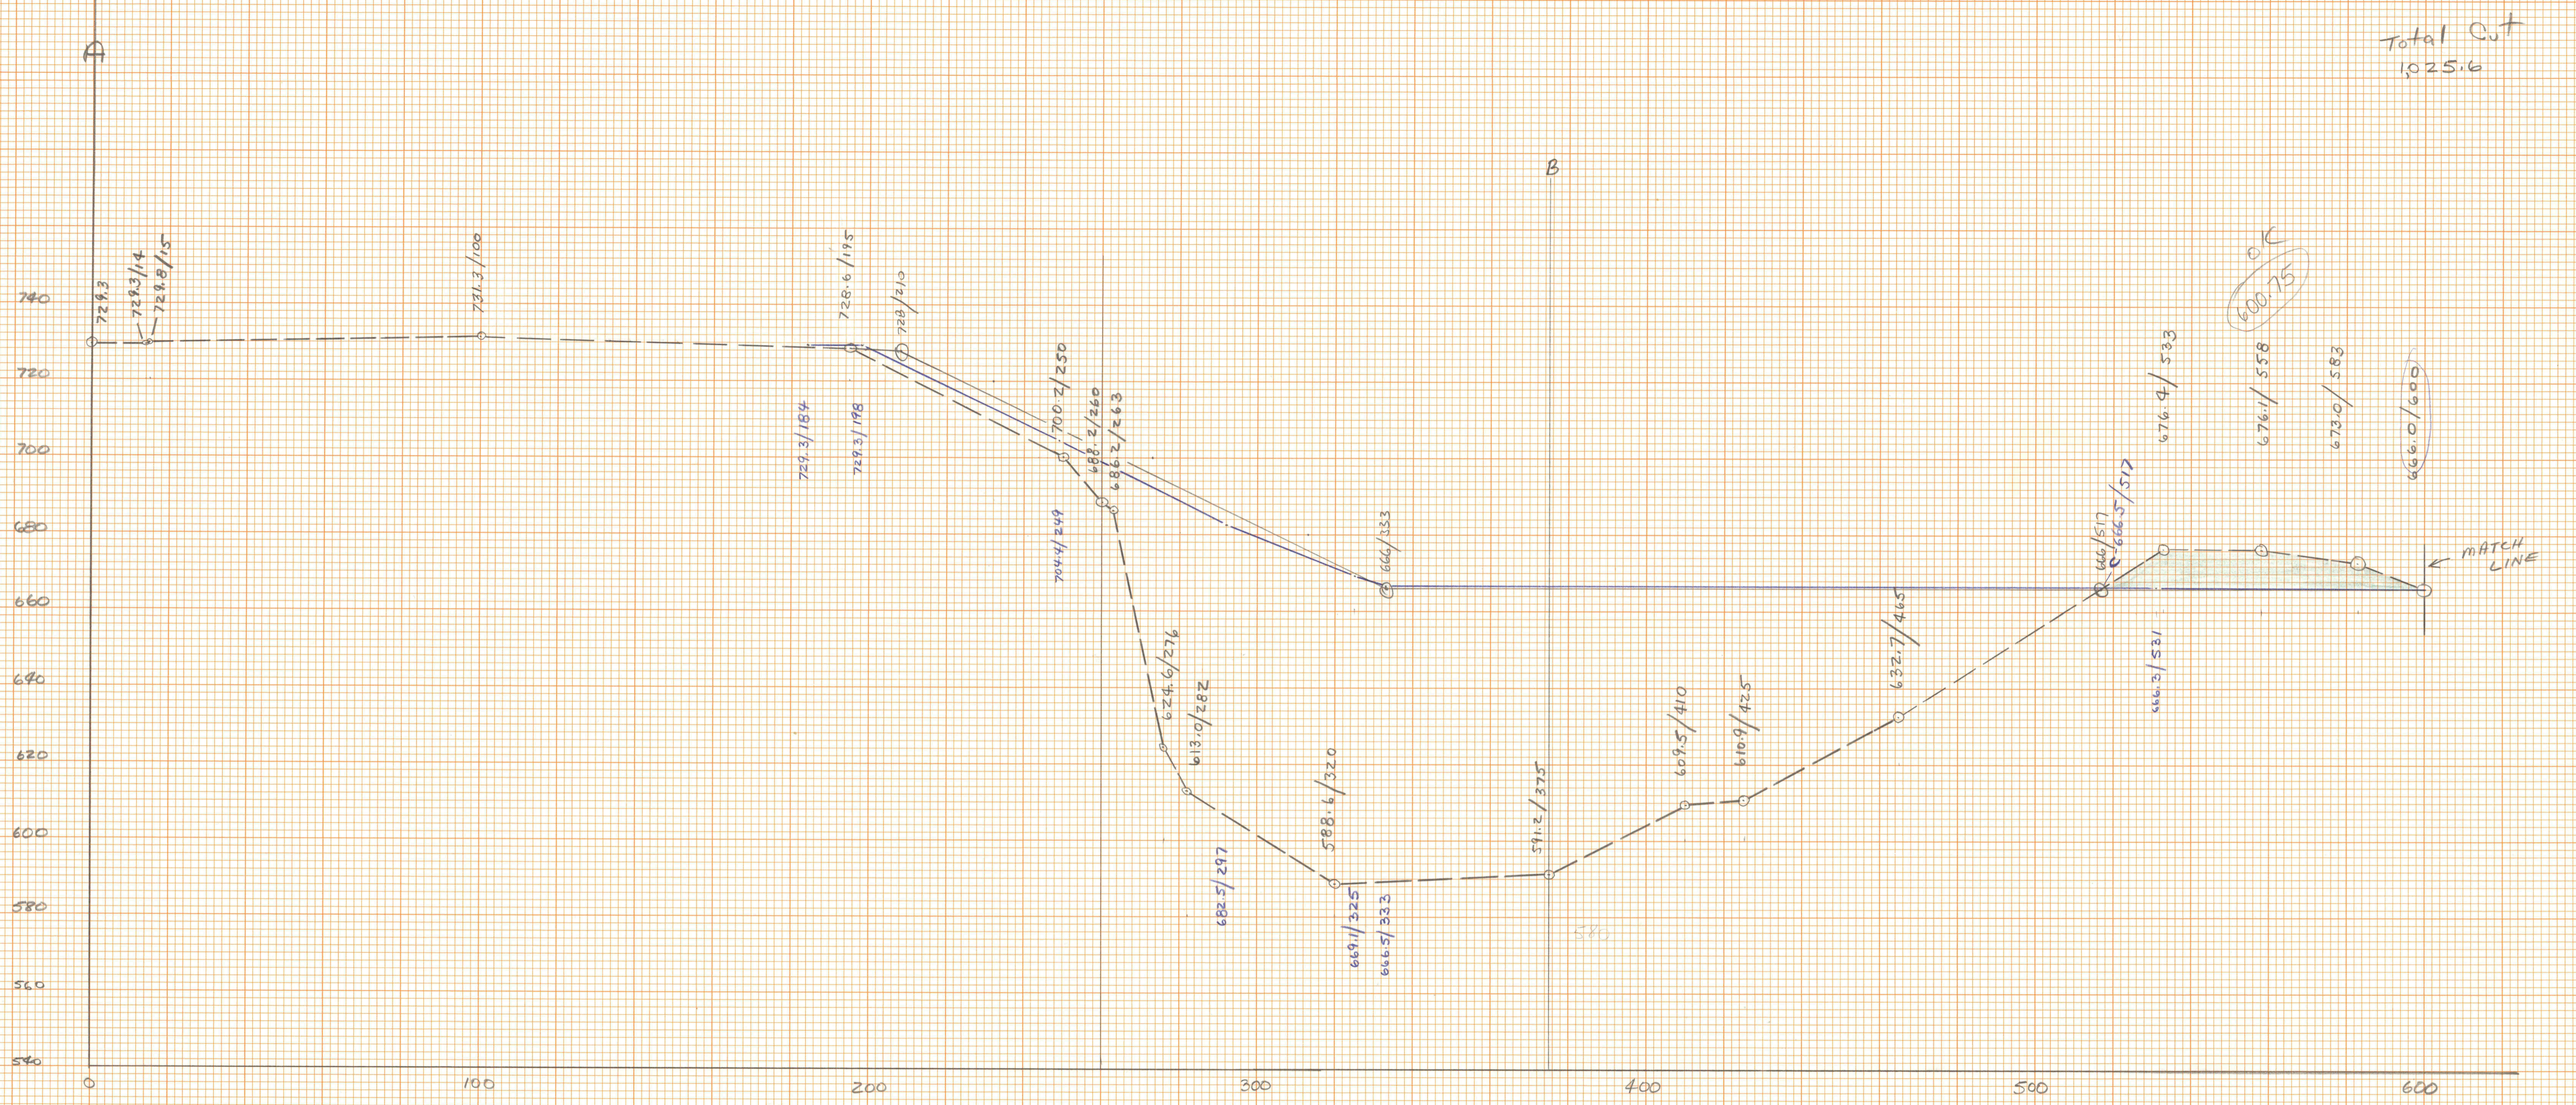

Sta. 14+00