


Total Cut
26,816.85

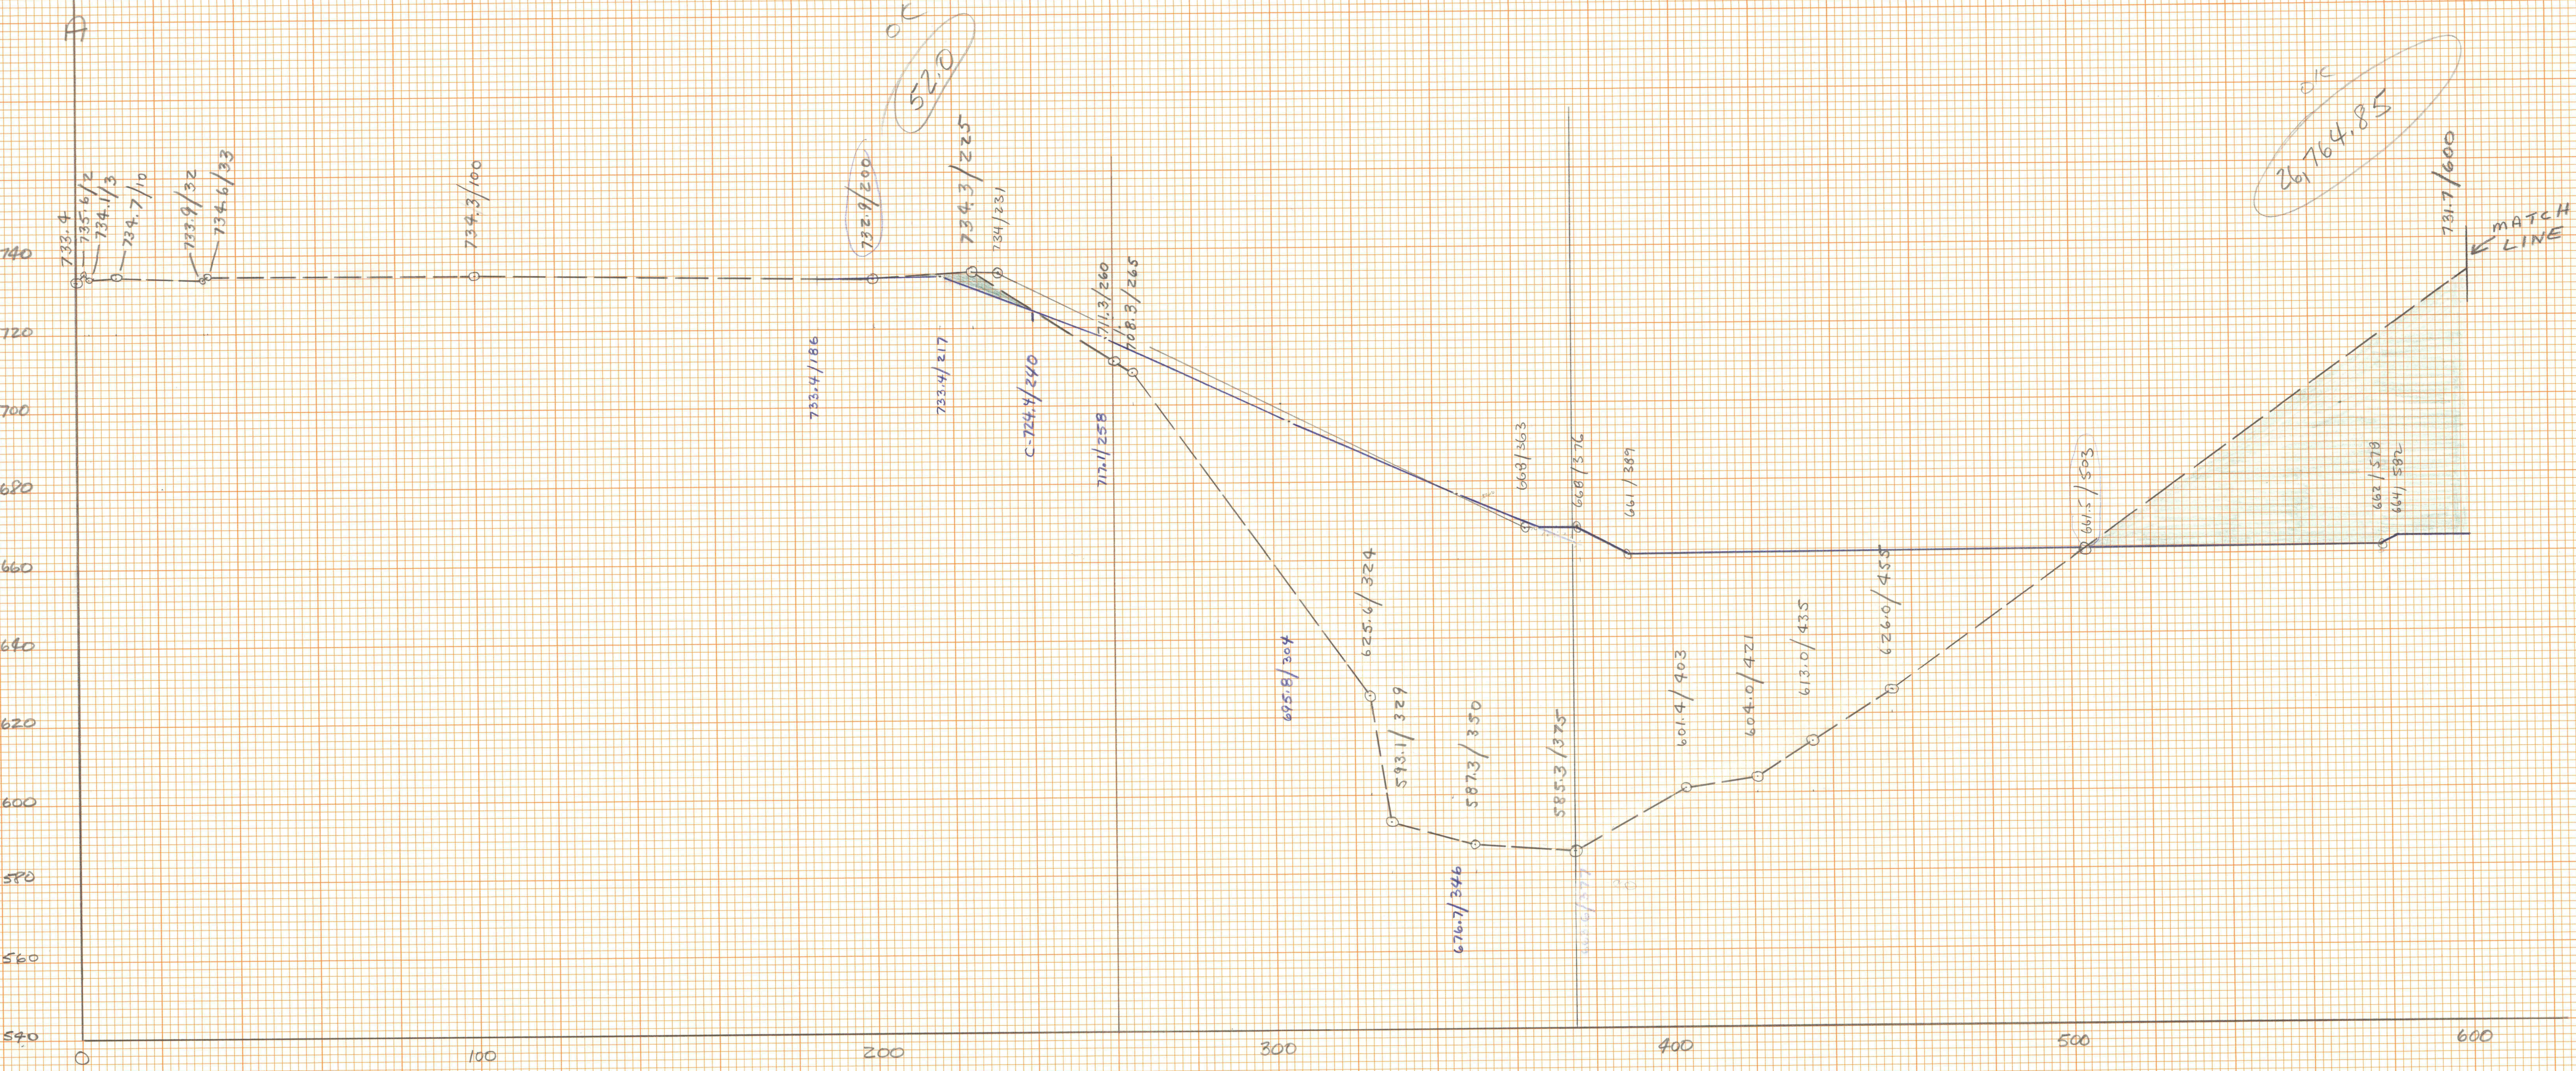

52.0

26,764.85

Sta. 17+00