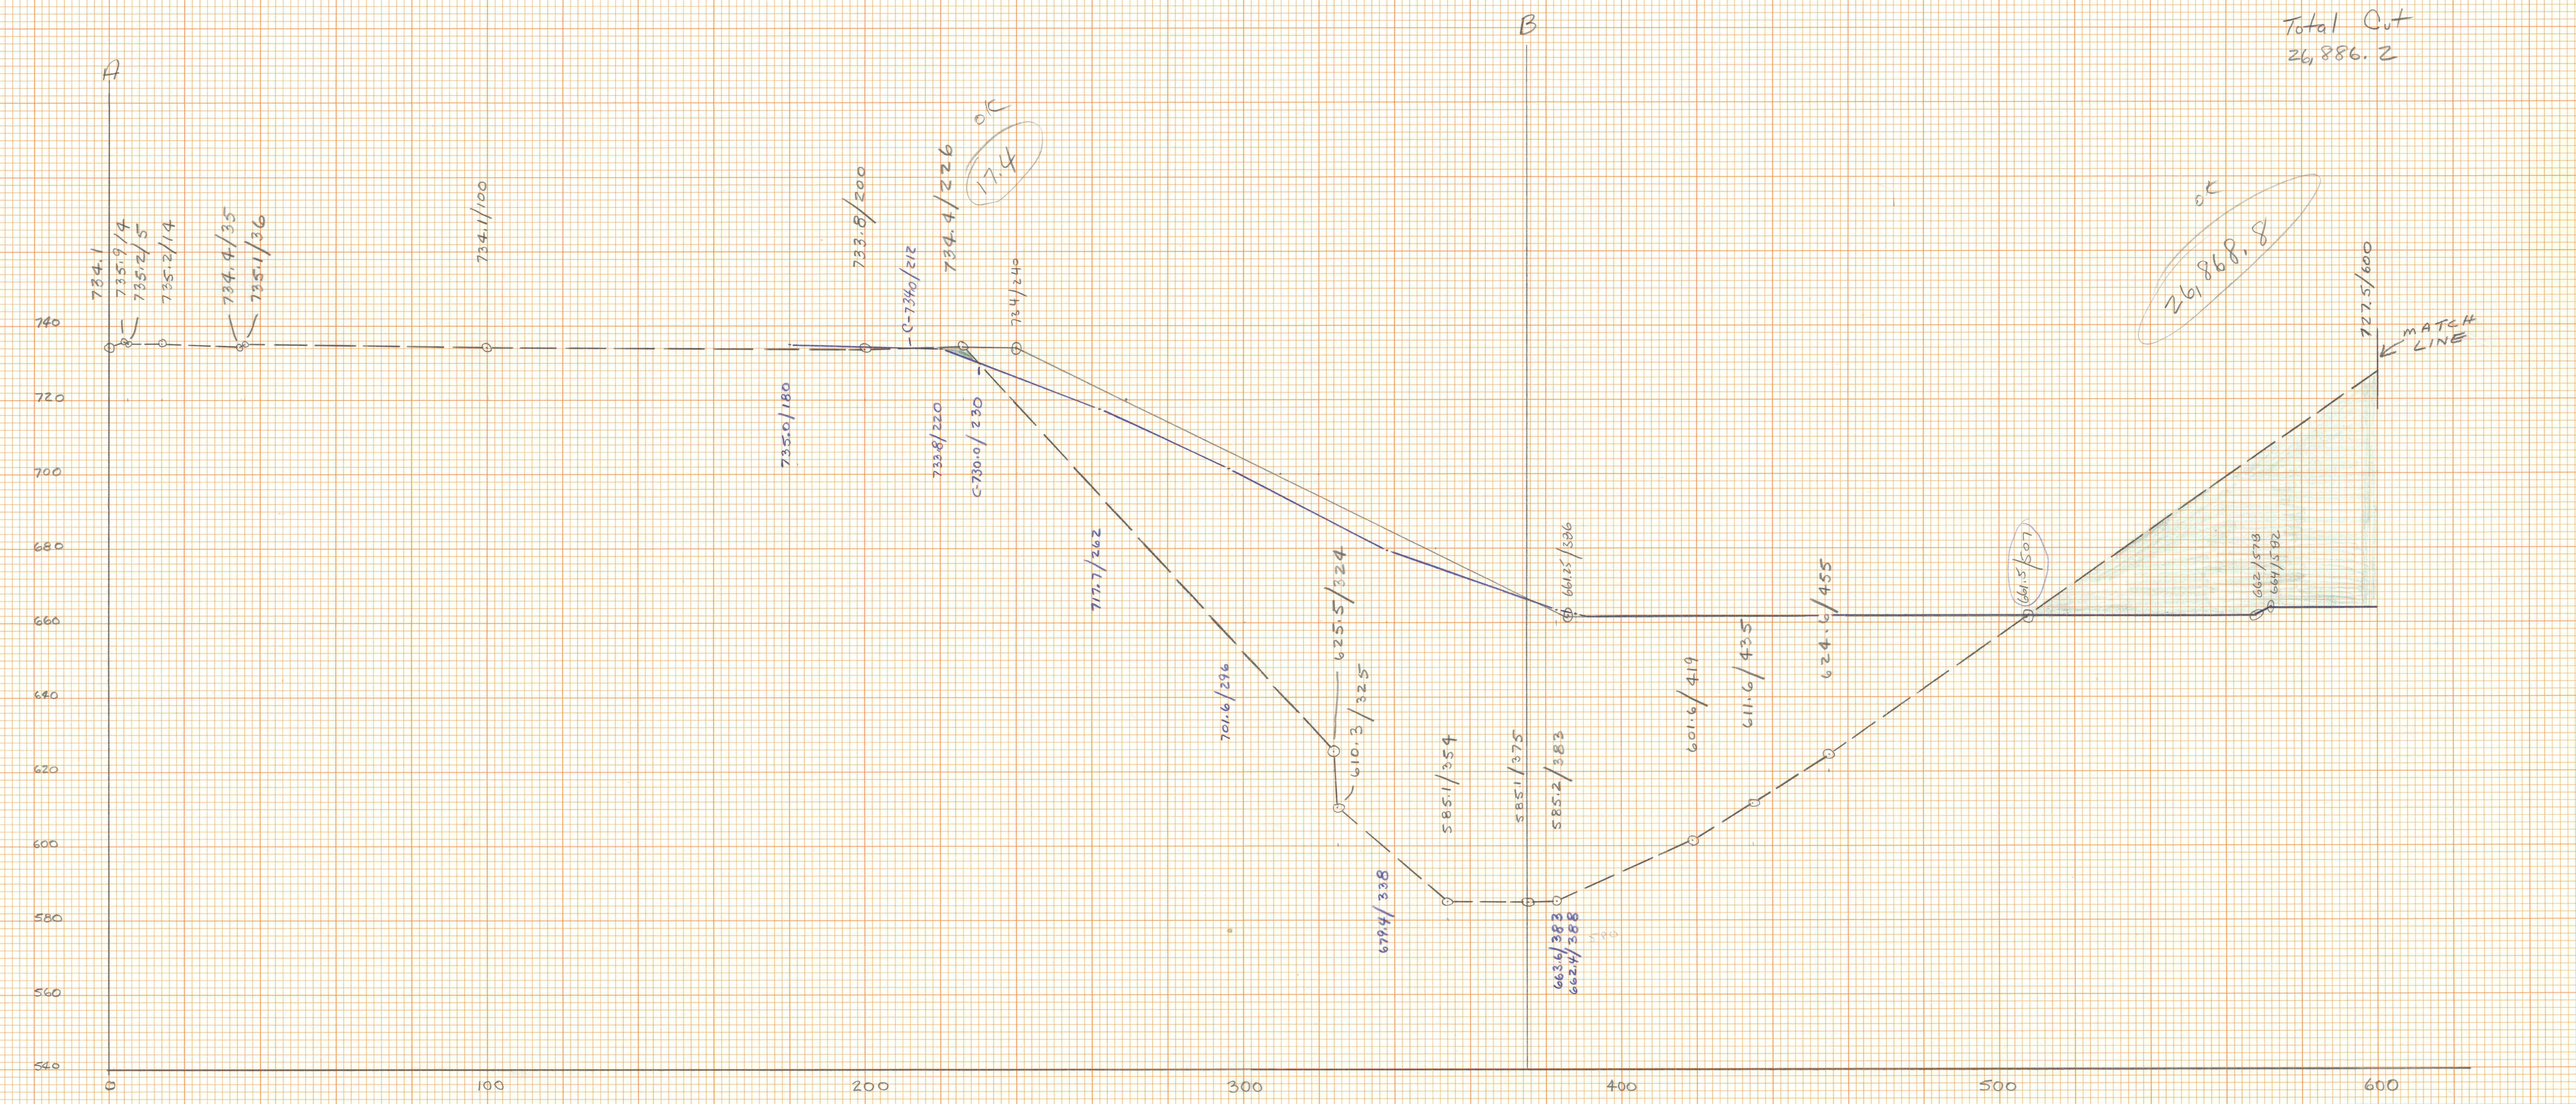
A
B
Total Cut
26,886.2
o.c
17.4
o.c
26,868.8
MATCH LINE
734.1
735.9/14
735.2/5
735.2/14
734.4/35
735.1/36
734.1/100
733.8/200
C-736.6/212
734.4/226
734.4/240
735.0/180
733.8/220
C-730.0/230
717.7/262
701.6/296
625.5/324
610.3/325
585.1/354
585.1/375
585.2/383
678.4/338
663.6/383
662.4/388
664.25/506
601.6/419
611.6/425
624.6/455
661.5/507
662/578
664/592
740
720
700
680
660
640
620
600
580
560
540
0
100
200
300
400
500
600

Sta. 17+25