


Total Cut  
21,108.6

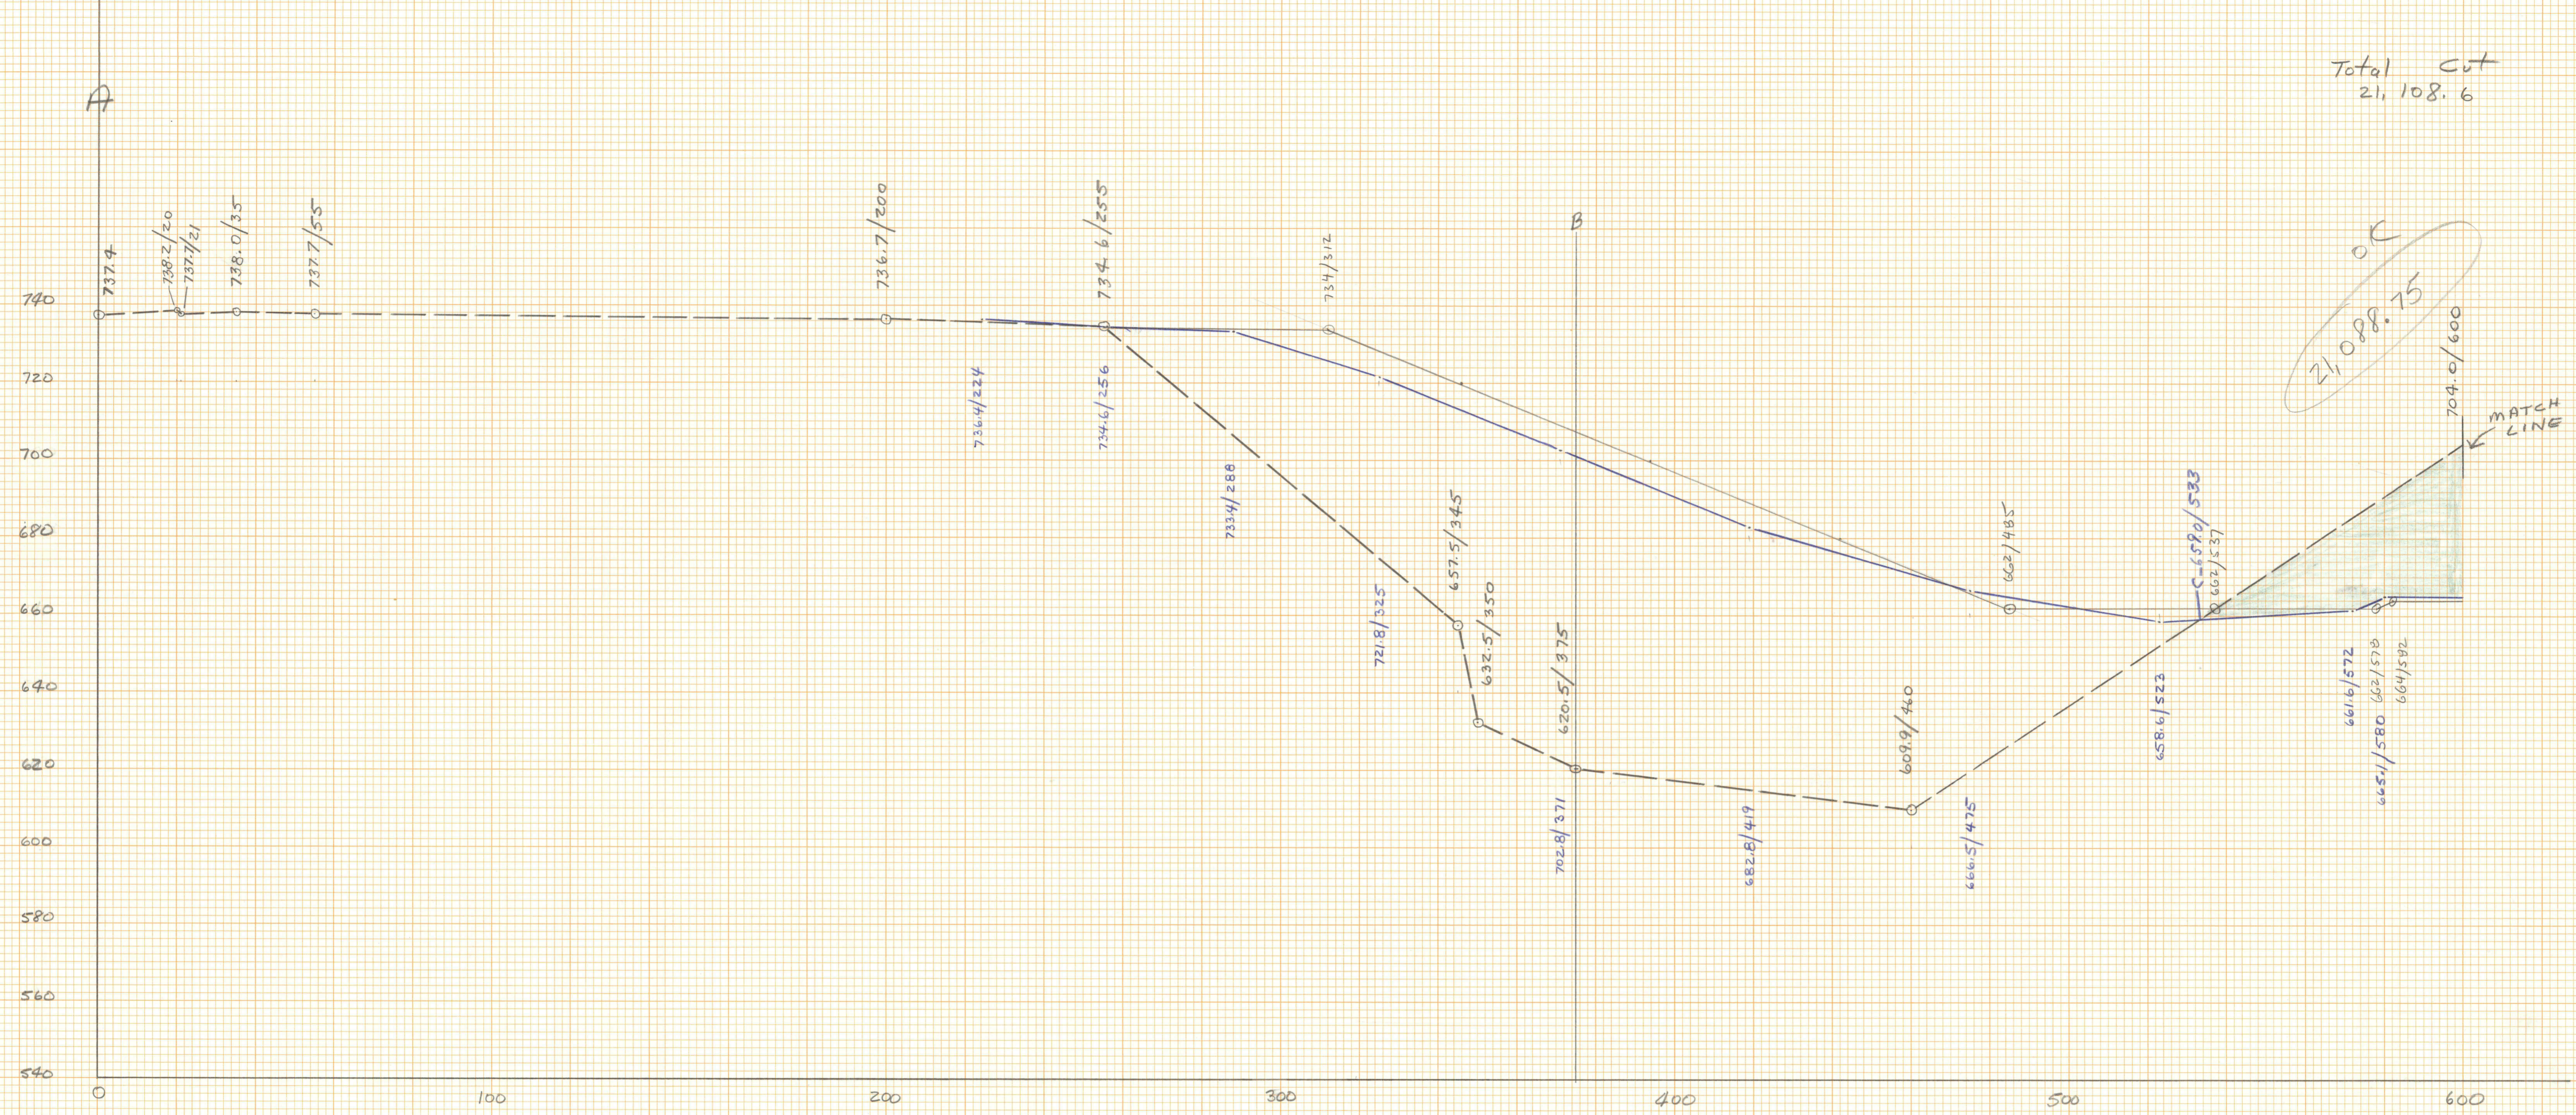

OK  
21,088.75

MATCH LINE

Sta. 19+00