


Total Cut
1,206.6

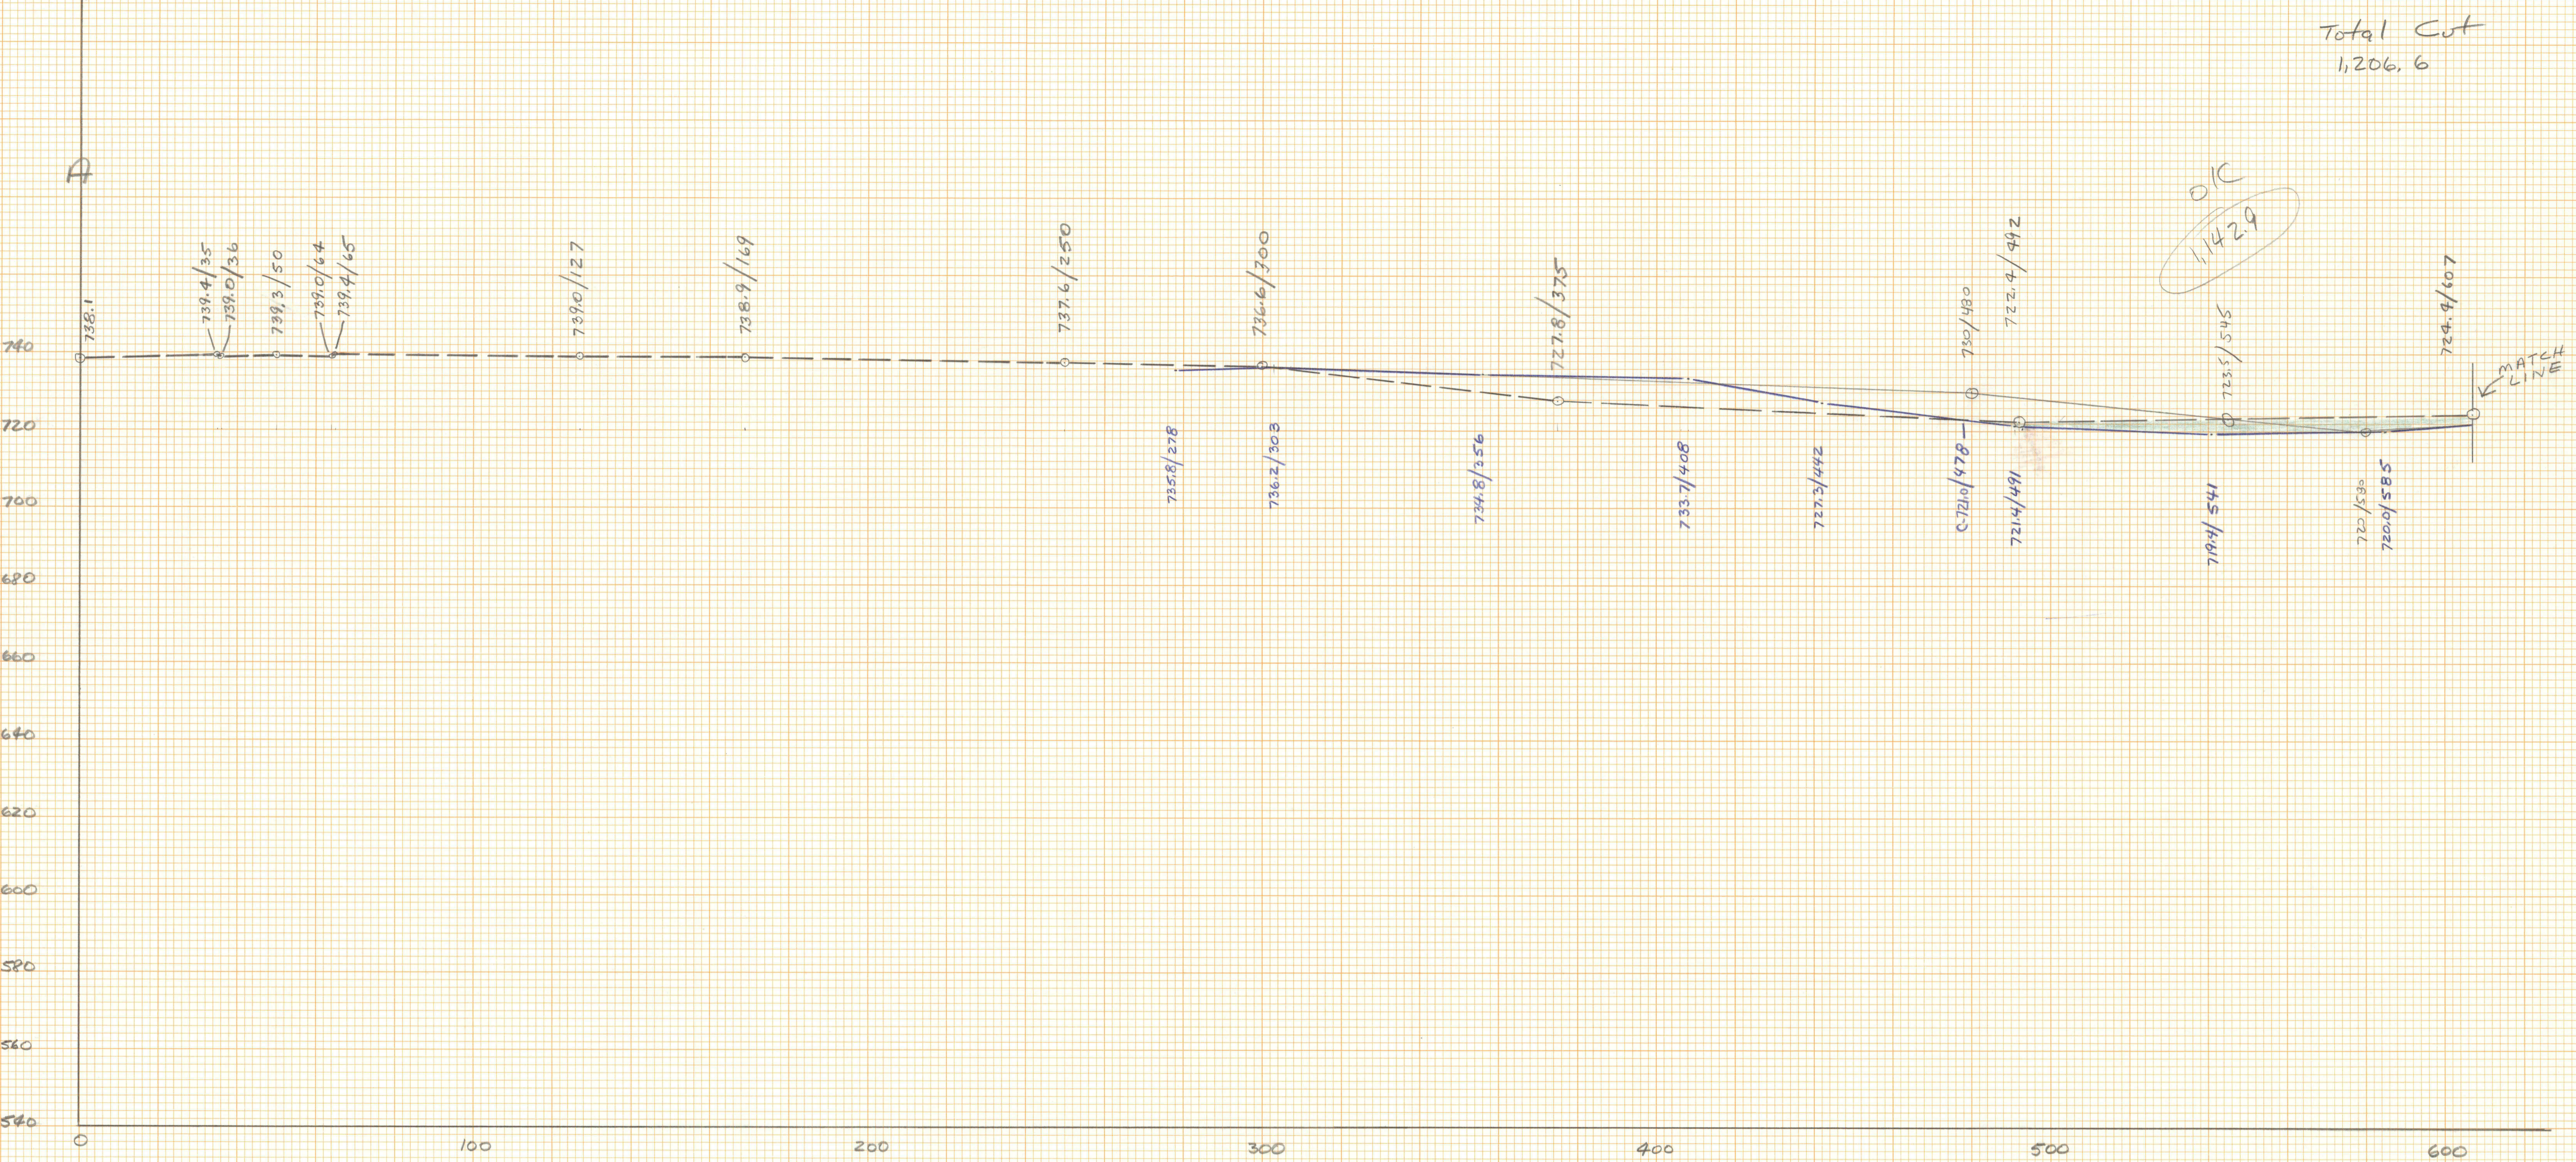

OK
1,142.9

MATCH LINE

Sta. 20+50