



LACKAWANNA
COAL
CO
LTD

WM MILES TRACT
THE D. & H CO FEE

MARIA HULL
TRACT


PRICE LAW &
WINTCH TRACT
LACKA. C. & LTD

STEVENS
FARM
THE D. & H CO FEE

SCRANTON
COAL
CO
JOHNSON COLLIERY

LACKAWANNA
COAL CO. LTD.

GLEN
ALDEN
COAL
CO
STORRS COLLIERY

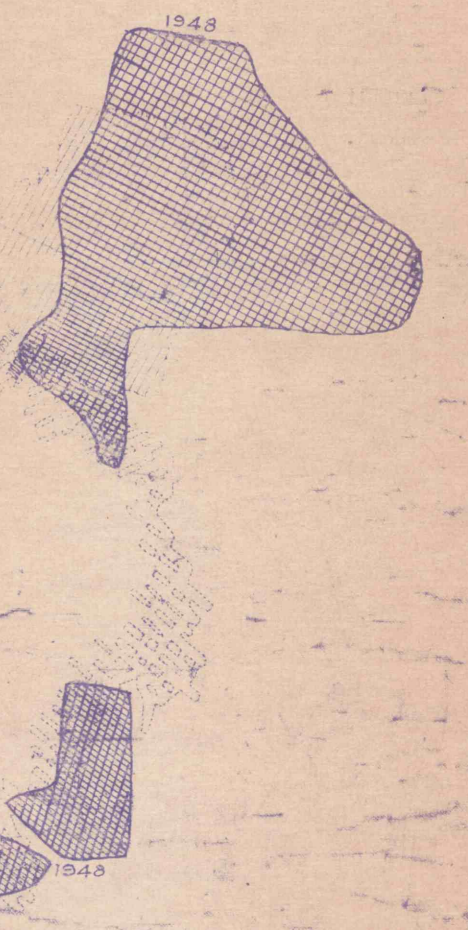

LEASE FROM THE HUDSON
COAL CO. TO THE LACKAWANNA
COAL CO. LTD. CANCELLED
1-19-1936

Z. C. & V. CO FEE

WM HULL &
THE DELAND HUDSON CO

PRICE
PANCOAST
COAL
CO

PENNA
COAL
CO

THE D. & H. CO
LESSEE

MT.
JESSUP
COLLIERY

THE D. & H. CO
LESSEE
Exchange Parcel 'X'

TEMPLE COAL CO

PENNSYLVANIA COAL CO


Note: The foreign workings shown by dotted lines were transferred from blue prints furnished by the various companies and workings shown by solid lines were taken from surveys of The Hudson Coal Co.

THE HUDSON COAL CO
MID OF THE
FOURTEEN FT BED
AT OLYMPIANT COLLIERY
SCALE 1 IN EQUAL 400 FT
OFFICE OF MINING ENGINEER
SCRANTON, PENNA. FEB. 1937