


- 3 BH #548B
- 3 BH #559B
- BH #L
- 3 BH #580B
- BH #K
- 2 BH #218B
- 3 BH #611B
- 4 BH #76
- 8 BH #210
- 4 BH #68
- 4 BH #39
- 3 BH #90
- 4 BH #163
- 4 BH #72
- BH #A
- 3 BH #104
- 8 BH #148
- 4 BH #10
- 6 BH #114
- 3 BH #43
- 4 BH #140
- 3 BH #130
- 2 BH #511
- 2 BH #512
- 3 BH #147
- 3 BH #339
- 6 BH #124

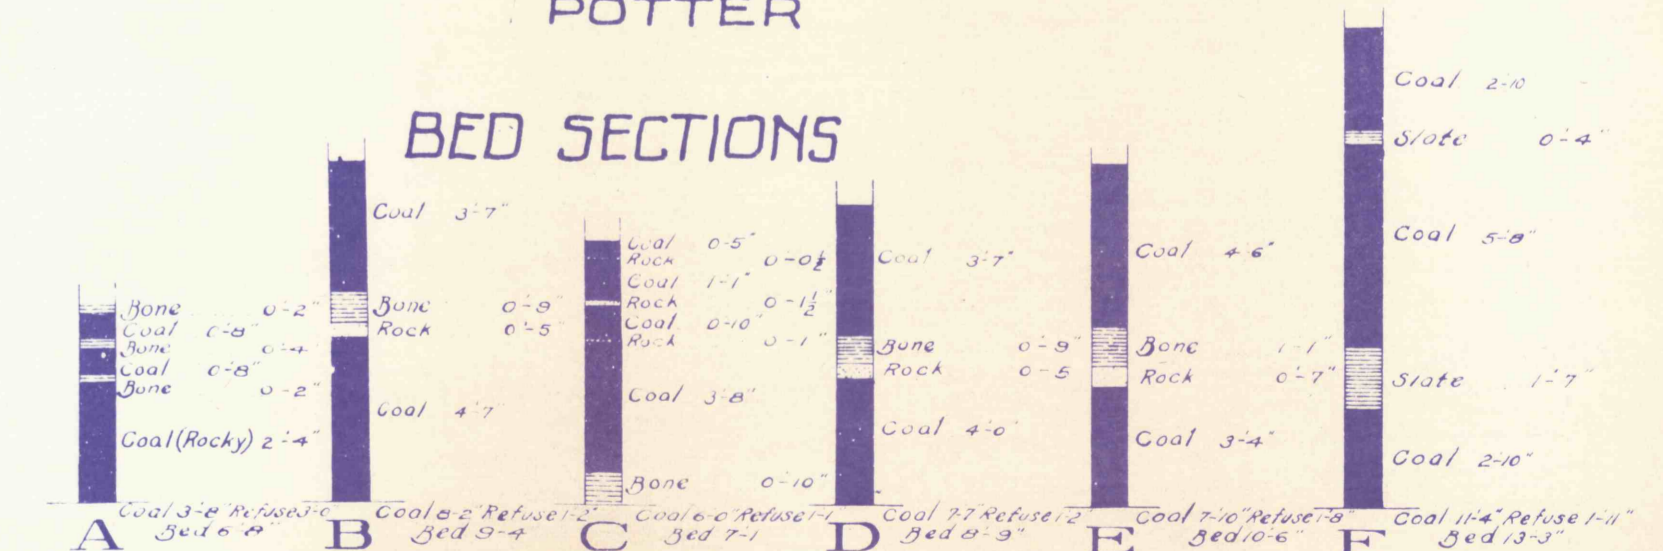

THE HUDSON COAL CO.  
 PROVIDENCE DIVISION  
 (MARVINS-DICKSON-MANVILLE COLLIERIES)  
 WORKINGS IN THE  
 14-FOOT-BED  
 Scale: 1" = 400'

Note: Adjacent workings are transferred from  
 Maps of various Coal Cos.

Office of  
 Forecast Department  
 Scranton, Pa.  
 May, 1920.  
 Posted to Jan. 1922.