

PRICE-PANCOAST COAL CO.

PENNA. COAL CO.
JOS. HORSEFIELD

THE DELAWARE & HUDSON CO.

GEOL. BROWN

D. & H. Co. Penna. Coal Co. Exchange
DOLPH & PORTER
PENNA. COAL CO.

GILBERT DUNNING

STEVENS
D. L. & W. FEE

GENET

N. C. & I. CO.

WILLARD PARKER

BOWMAN

LEVI DEPEW

JOHN MILLS

PENNA. COAL CO.

JACOB BIESECKER

DANIEL SWARTZ

JACOB DEPEW

THE D. & H. CO. FEE

C. M. S.
SIMPSON
COAL
CO.

POTTER

SANDERSON

GILMORE - MEYLERT

SANDERSON

GILMORE - MEYLERT

WALSH

BLAIR

SCRANTON COAL CO.

LUZERNE COAL CO.
D. L. & W. LESSEE

LACKAWANNA VALLEY
COAL CO.
D. L. & W. FEE

CAYUGA & SUSQUEHANNA
D. L. & W. FEE

H. B. ROCKWELL

MISCELLANEOUS LOTS

H. B. ROCKWELL

FERD. VON STORCH
Von Storch Collieries Co. Fee

T. C. VON STORCH
Von Storch Collieries Co. Fee

ROBINSON
Bulls Head Coal Co. Lessee

EARL & GRIFFIN
Bulls Head Coal Co. Lessee

KELSEY
Bulls Head Coal Co. Lessee

CHURCH
Bulls Head Coal Co. Lessee

NASSAU


BRIFFIN

WINTON
D. L. & W. Fee

WILLARD PARKER
Von Storch Collieries Co. Lessee

D. L. & W. R. R. FEE

D. L. & W. FEE

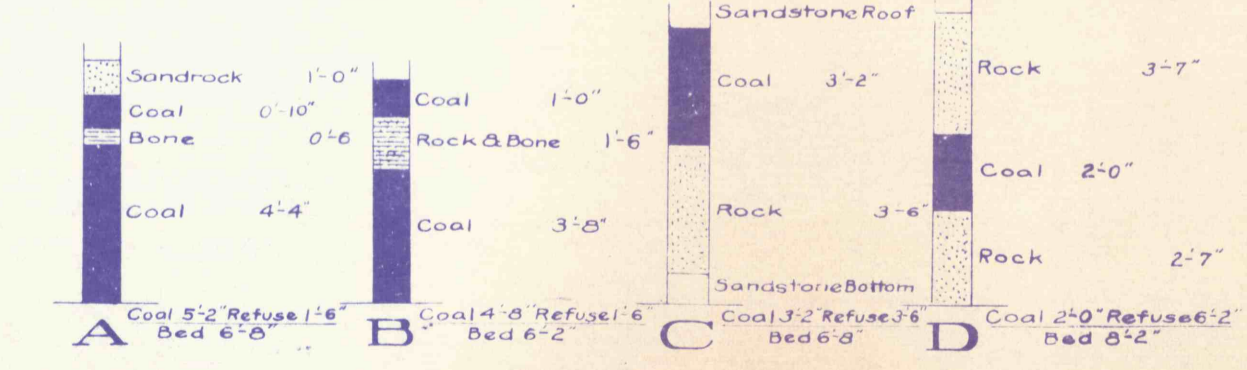

THE HUDSON COAL CO.
PROVIDENCE DIVISION
(MARVINE - DICKSON - MANVILLE - GILMORES)
WORKINGS IN THE
BOTTOM 14 FOOT BED
Scale: 1" = 400'

NOTE - Adjoining workings are transferred from
Maps of various Coal Cos.

Office of
Forecast Department
Scranton, Pa.