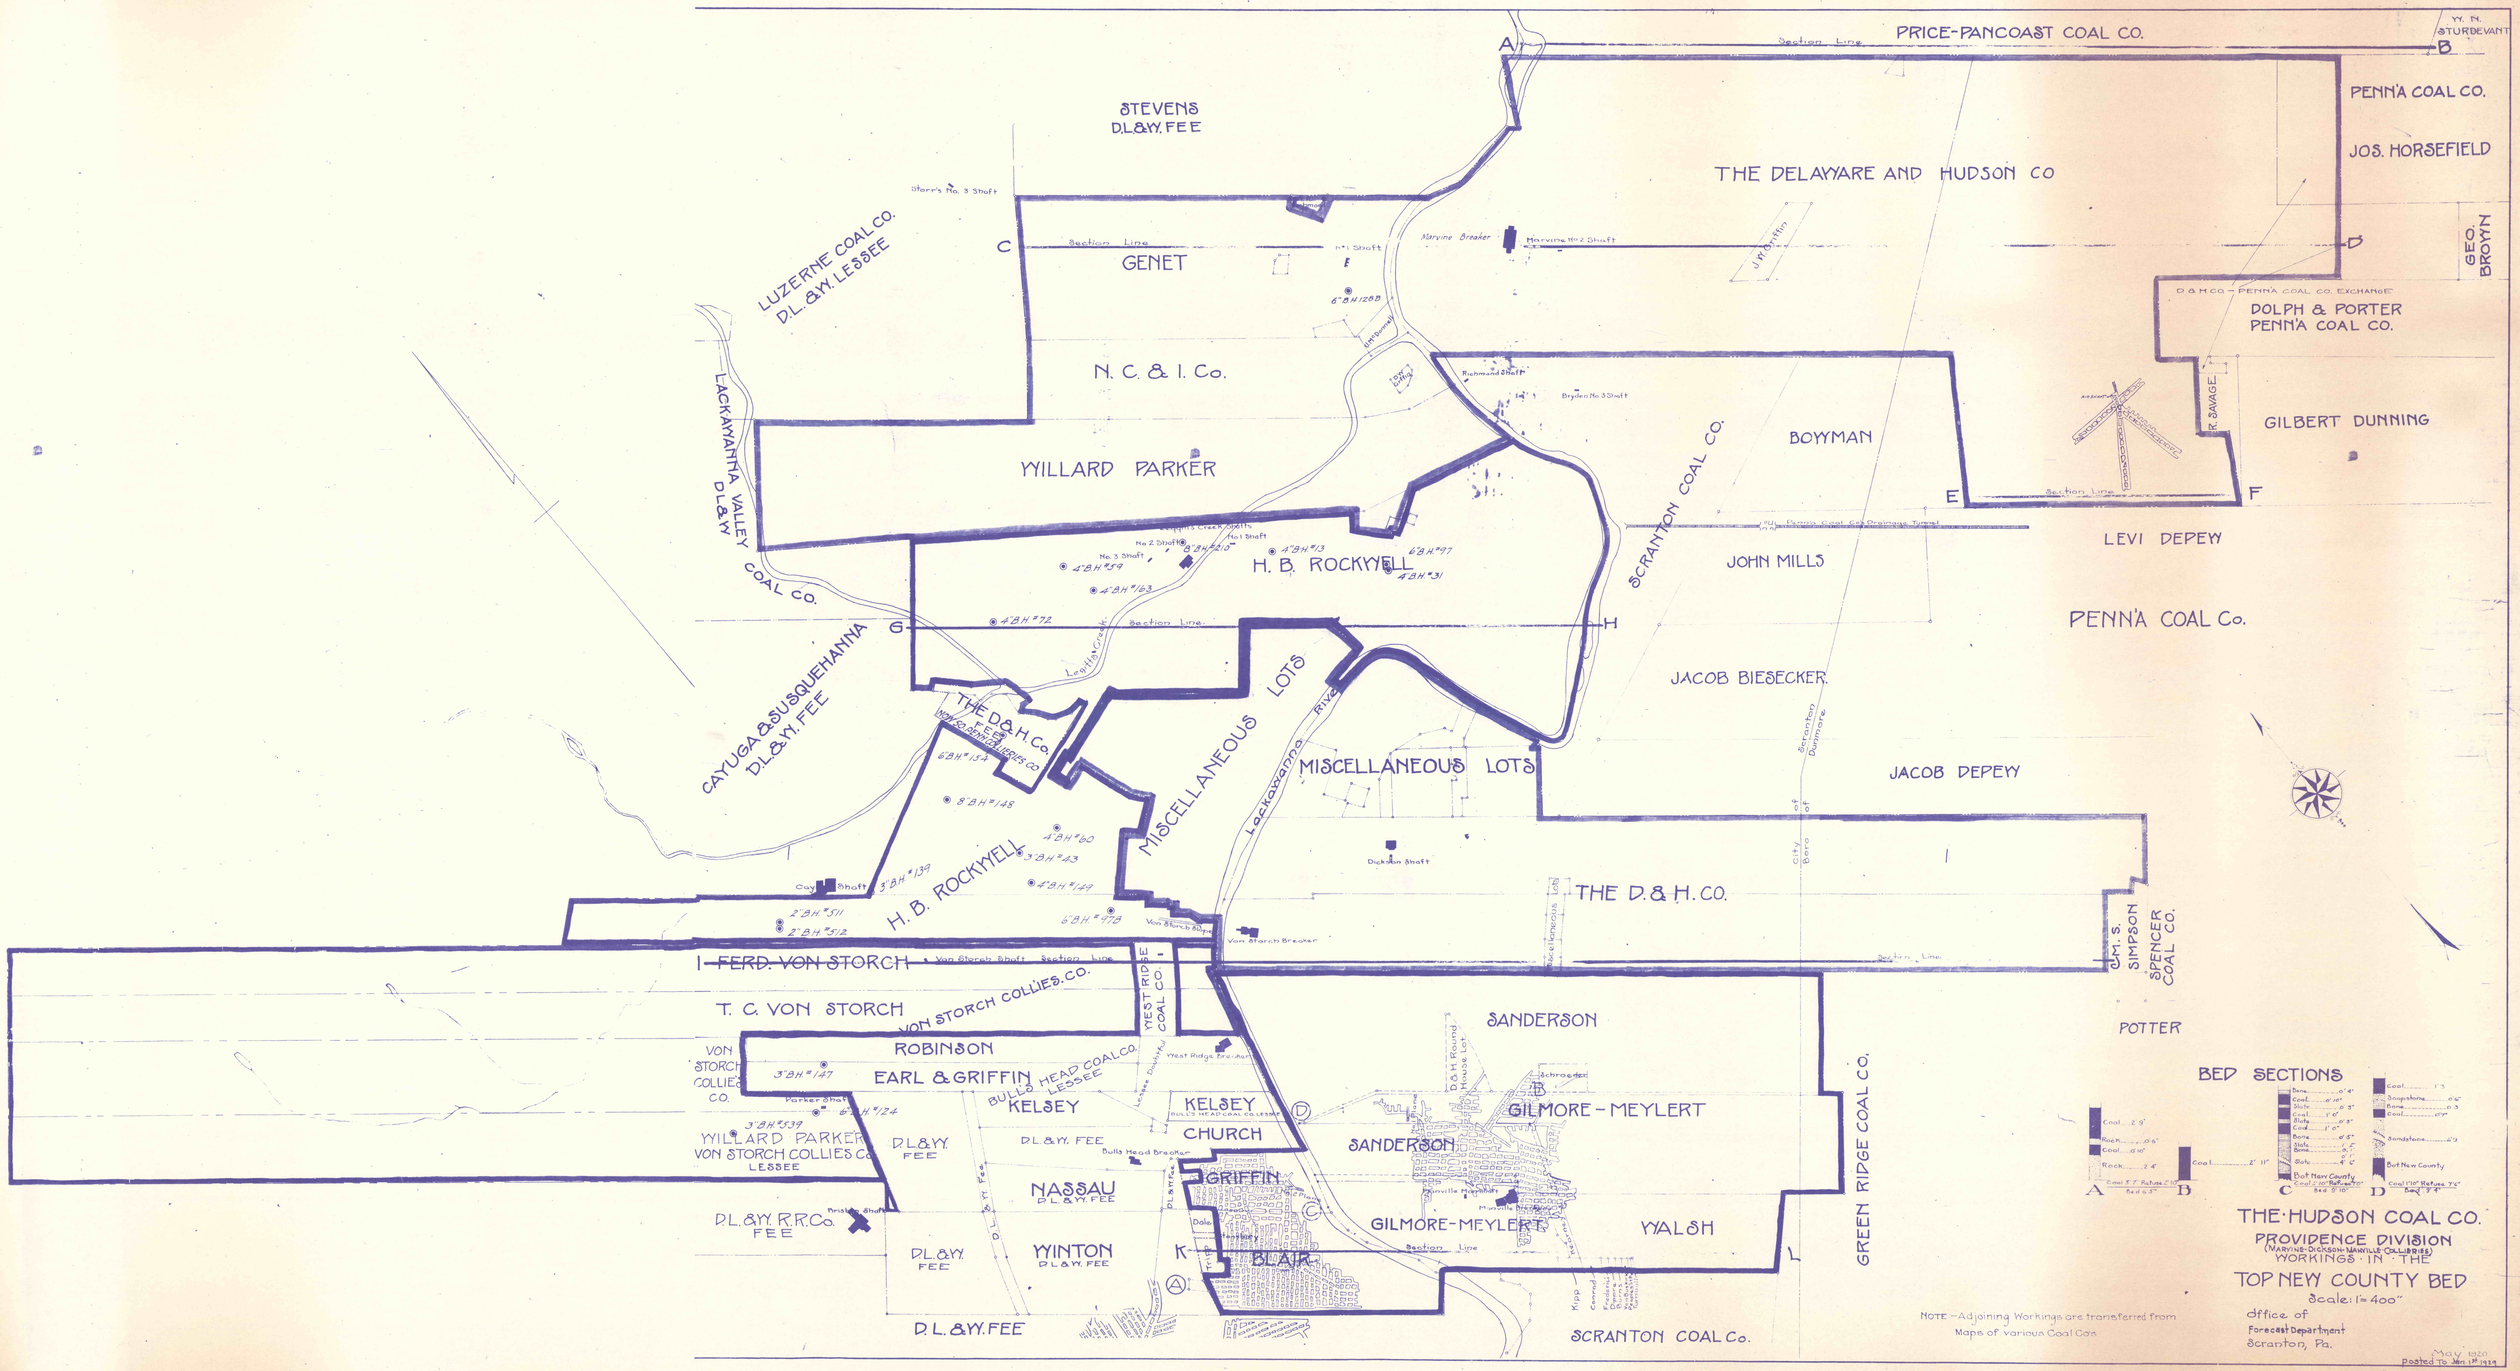
PRICE-PANCOAST COAL CO.
Section Line
A
B
STEVENS
D.L.&W. FEE
PENN'A COAL CO.
JOS. HORSEFIELD
THE DELAWARE AND HUDSON CO
Storr's No. 3 Shaft
LUZERNE COAL CO.
D.L.&W. LESSEE
C
Section Line
GENET
No. 1 Shaft
Marvine Breaker
Marvine No. 2 Shaft
J.W. Griffin
GEO. BROWN
D
D.&H.CO.-PENN'A COAL CO. EXCHANGE
DOLPH & PORTER
PENN'A COAL CO.
N. C. & I. Co.
Richmond Shaft
No. 1
Bryden No. 3 Shaft
R. SAVAGE
GILBERT DUNNING
LACKAWANNA VALLEY
D.L.&W.
COAL CO.
WILLARD PARKER
SCRANTON COAL CO.
BOWMAN
E
F
Section Lines
LEVI DEPEW
No. 2 Shaft
No. 3 Shaft
No. 1 Shaft
H. B. ROCKWELL
JOHN MILLS
G
Section Line
H
PENN'A COAL Co.
CAYUGA & SUSQUEHANNA
D.L.&W. FEE
THE D.&H. Co.
FEE
MISCELLANEOUS LOTS
Lackawanna River
JACOB BIESECKER
MISCELLANEOUS LOTS
Scranton Dunmore
JACOB DEPEW
Dickson Shaft
H. B. ROCKWELL
Cayuga Shaft
Von Storch Shaft
Section Line
THE D. & H. CO.
Miscellaneous Lots
FERD. VON STORCH
T. C. VON STORCH
VON STORCH COLLIES CO.
WEST RIDGE COAL CO.
J.M.S. SIMPSON
SPENCER COAL CO.
POTTER
SANDERSON
ROBINSON
VON STORCH COLLIES CO.
EARL & GRIFFIN
BULLS HEAD COAL CO. LESSEE
KELSEY
KELSEY
BULLS HEAD COAL CO. LESSEE
CHURCH
GILMORE-MEYLERT
WILLARD PARKER
VON STORCH COLLIES CO.
LESSEE
D.L.&W. FEE
D.L.&W. FEE
SANDERSON
GRIFFIN
NASSAU
D.L.&W. FEE
D.L.&W. R.R.Co.
FEE
D.L.&W. FEE
WINTON
D.L.&W. FEE
BLAIR
GILMORE-MEYLERT
WALSH
GREEN RIDGE COAL CO.
D.L.&W. FEE
SCRANTON COAL Co.
BED SECTIONS
A
B
C
D
THE HUDSON COAL CO.
PROVIDENCE DIVISION
(MARVINE-DICKSON-MANVILLE COLLIERIES)
WORKINGS IN THE
TOP NEW COUNTY BED
Scale: 1" = 400'
Office of
Forecast Department
Scranton, Pa.
NOTE - Adjoining Workings are transferred from Maps of various Coal Cos
May 1920
Posted To Jan 1st 1929