

W. N. STURDEVANT  
B

PENNA. COAL CO.  
JOS. HORSEFIELD

GEO. BROWN

D. & H. Coal Co. Penna. Coal Co. Exchange.  
DOLPH & PORTER  
PENNA. COAL CO.

GILBERT DUNNING

PRICE PANCOAST COAL CO.

STEVENS  
D.L. & W. FEE

THE DELAWARE & HUDSON CO.

LUZERNE COAL CO.  
D.L. & W. LESSEE

GENET

N. C. & I. CO.

WILLARD PARKER

J.W. GRIFFIN

LACKAWANNA VALLEY  
D.L. & W. FEE  
COAL CO.

H. B. ROCKWELL

SCRANTON COAL CO.

BOYMAN

JOHN MILLS

LEVI DEPEW

CAYUGA & SUSQUEHANNA  
TRACT  
D.L. & W. FEE

H. B. ROCKWELL

MISCELLANEOUS LOTS

MISCELLANEOUS LOTS

JACOB BIESECKER

PENNA. COAL CO.

DANIEL SWARTZ

JACOB DEPEW

THE D. & H. CO. FEE

C. M. S. SIMPSON  
SPENCER COAL CO.

FERD. VON STORCH  
WEST RIDGE COAL CO.  
T. C. VON STORCH

VON STORCH  
COLLIES CO.  
FEE

ROBINSON  
West Ridge Coal Co. Lessee.  
EARL & GRIFFIN  
Bulls Head Coal Co. Lessee.

KELSEY

SANDERSON

GILMORE - MEYLERT

WILLARD PARKER  
Von Storch Collies Co.  
Lessee

D.L. & W. FEE  
D.L. & W. Co. Lessee  
KELSEY  
D.L. & W. Co. Sub-Lessee

CHURCH

SANDERSON

D.L. & W. R.R.  
FEE

NASSAU  
D.L. & W. Fee

WINTON  
D. L. & W. Fee

BLAIR

GILMORE-MEYLERT



WALSH

GREEN RIDGE COAL CO.

POTTER

D.L. & W. FEE

SCRANTON  
COAL CO.

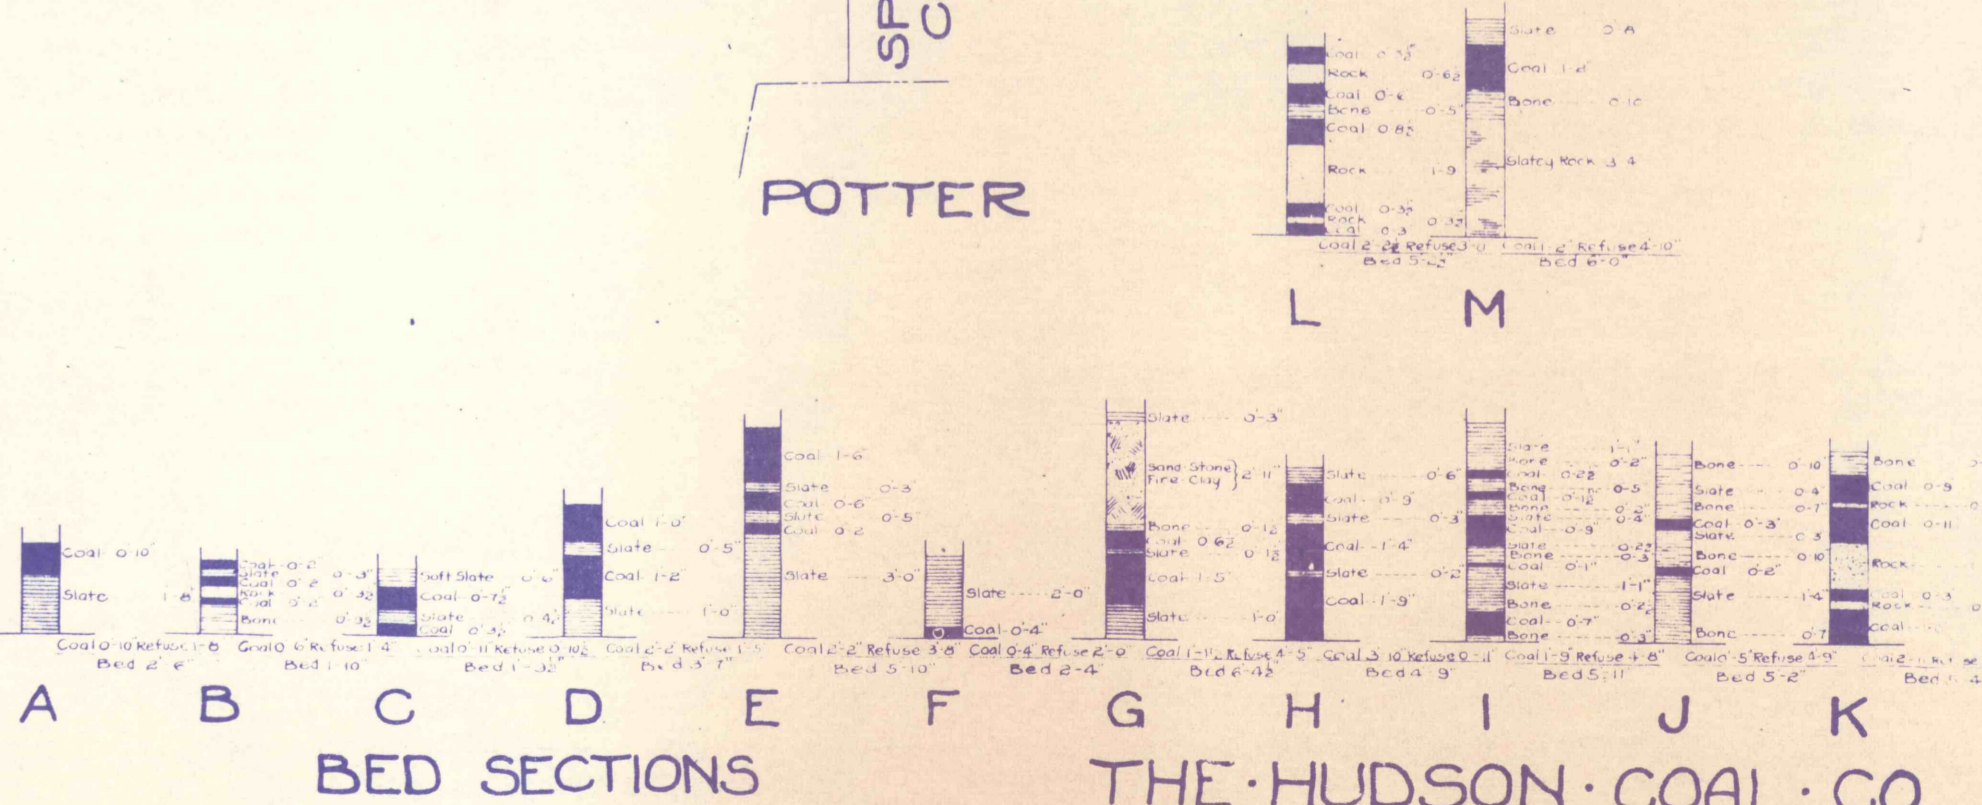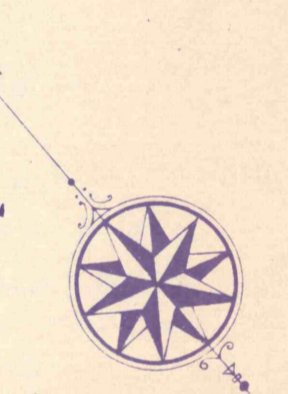

NOTE: Adjoining Workings are transferred from  
Maps of various Coal Cos.

THE HUDSON COAL CO.  
PROVIDENCE DIVISION  
(MARVINS-DICKSON-MARYVILLE COLLIERIES)  
WORKINGS IN THE  
NO. 1 DUNMORE BED.  
Scale: 1" = 400'

Office of  
Forecast Department  
Scranton, Pa.

May, 1920.  
Posted To Jan. 1st 1924