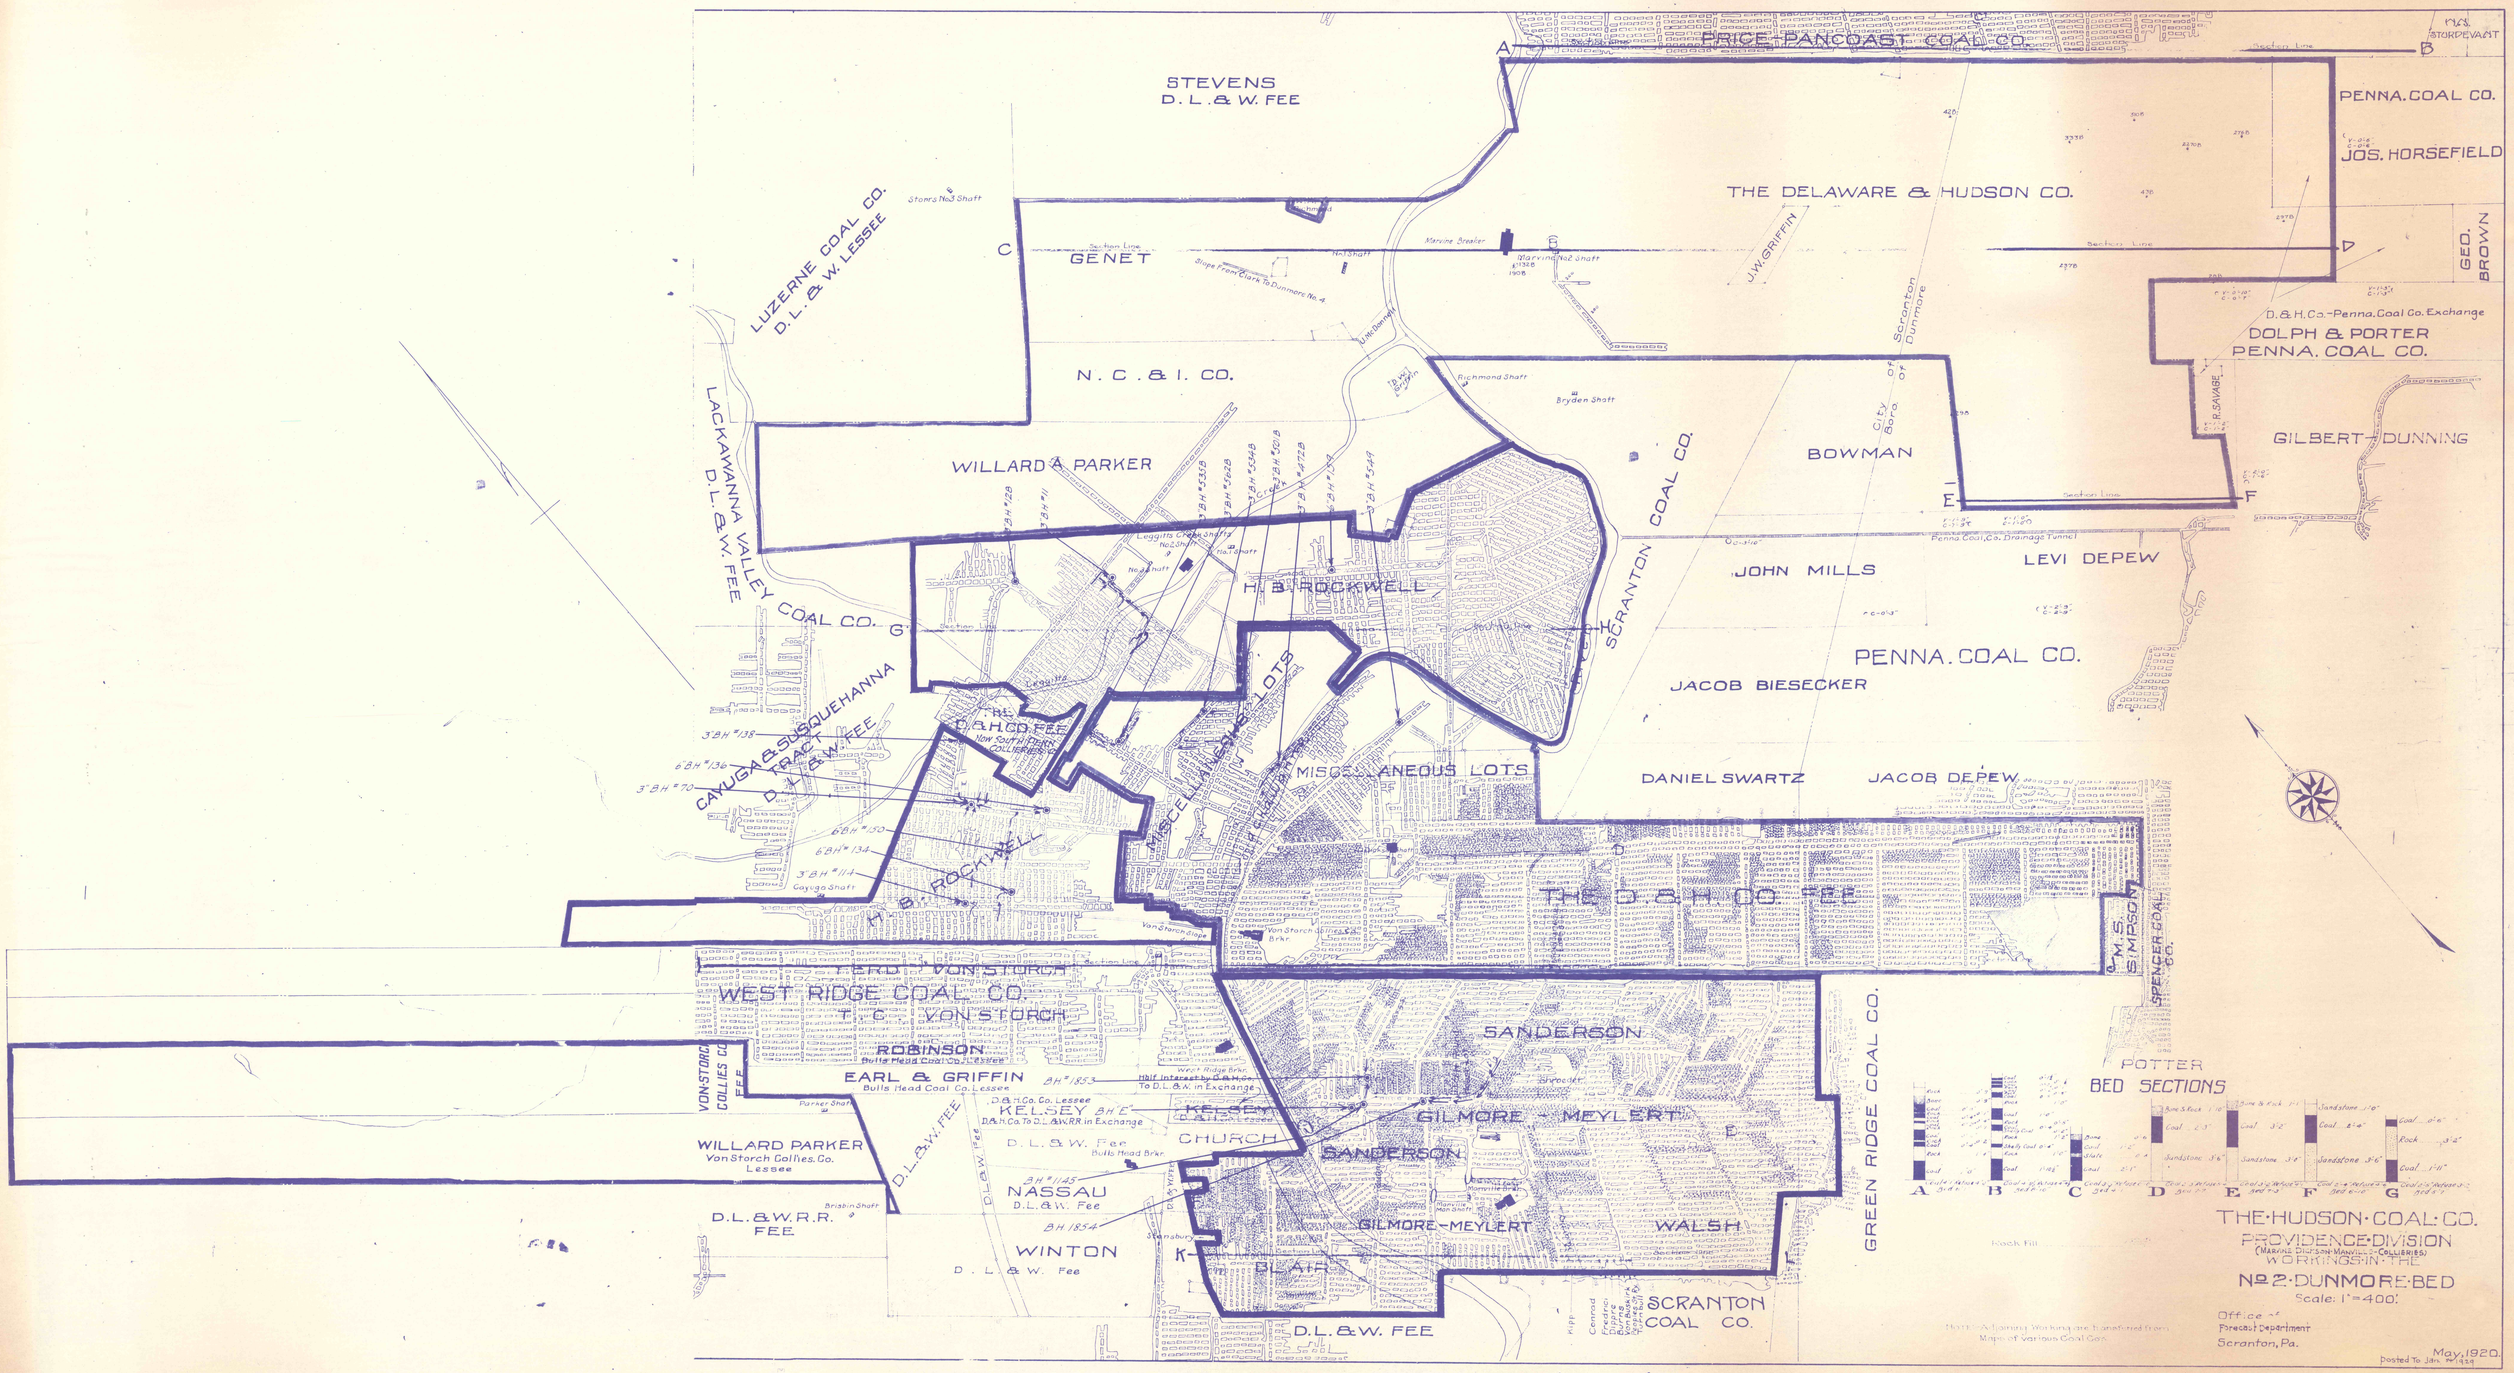
PRICE-PANCOAST COAL CO.
STEVENS
D. L. & W. FEE
PENNA. COAL CO.
JOS. HORSEFIELD
THE DELAWARE & HUDSON CO.
GEO. BROWN
D. & H. Co.-Penna. Coal Co. Exchange
DOLPH & PORTER
PENNA. COAL CO.
GILBERT-DUNNING
LUZERNE COAL CO.
D. L. & W. LESSEE
GENET
N. C. & I. CO.
WILLARD A. PARKER
LACKAWANNA VALLEY
D. L. & W. FEE
H. B. ROCKWELL
BOWMAN
SCRANTON COAL CO.
JOHN MILLS
LEVI DEPEW
PENNA. COAL CO.
JACOB BIESECKER
DANIEL SWARTZ
JACOB DEPEW
CAYUGA & SUSQUEHANNA
TRACT
D. L. & W. FEE
D. & H. CO. FEE
New South Park Colliery
MISCELLANEOUS LOTS
THE D. & H. CO. FEE
FERD. VON STORCH
WEST RIDGE COAL CO.
T. C. VON STORCH
ROBINSON
Bulls Head Coal Co. Lessee
EARL & GRIFFIN
Bulls Head Coal Co. Lessee
KELSEY
WILLARD PARKER
Von Storch Collies Co.
Lessee
D. L. & W. Fee
CHURCH
NASSAU
D. L. & W. Fee
WINTON
D. L. & W. Fee
D. L. & W. R. R.
FEE
SANDERSON
GILMORE-MEYLERT
WALSH
SCRANTON COAL CO.
GREEN RIDGE COAL CO.
D. L. & W. FEE
SPENCER COAL CO.
POTTER
BED SECTIONS
THE HUDSON COAL CO.
PROVIDENCE DIVISION
(MARINE DIVISION MANNING COLLIERIES)
WORKINGS IN THE
No. 2 DUNMORE BED
Scale: 1" = 400'
Office of
Forecast Department
Scranton, Pa.
May, 1920.
Posted To Jan. 1st 1935