




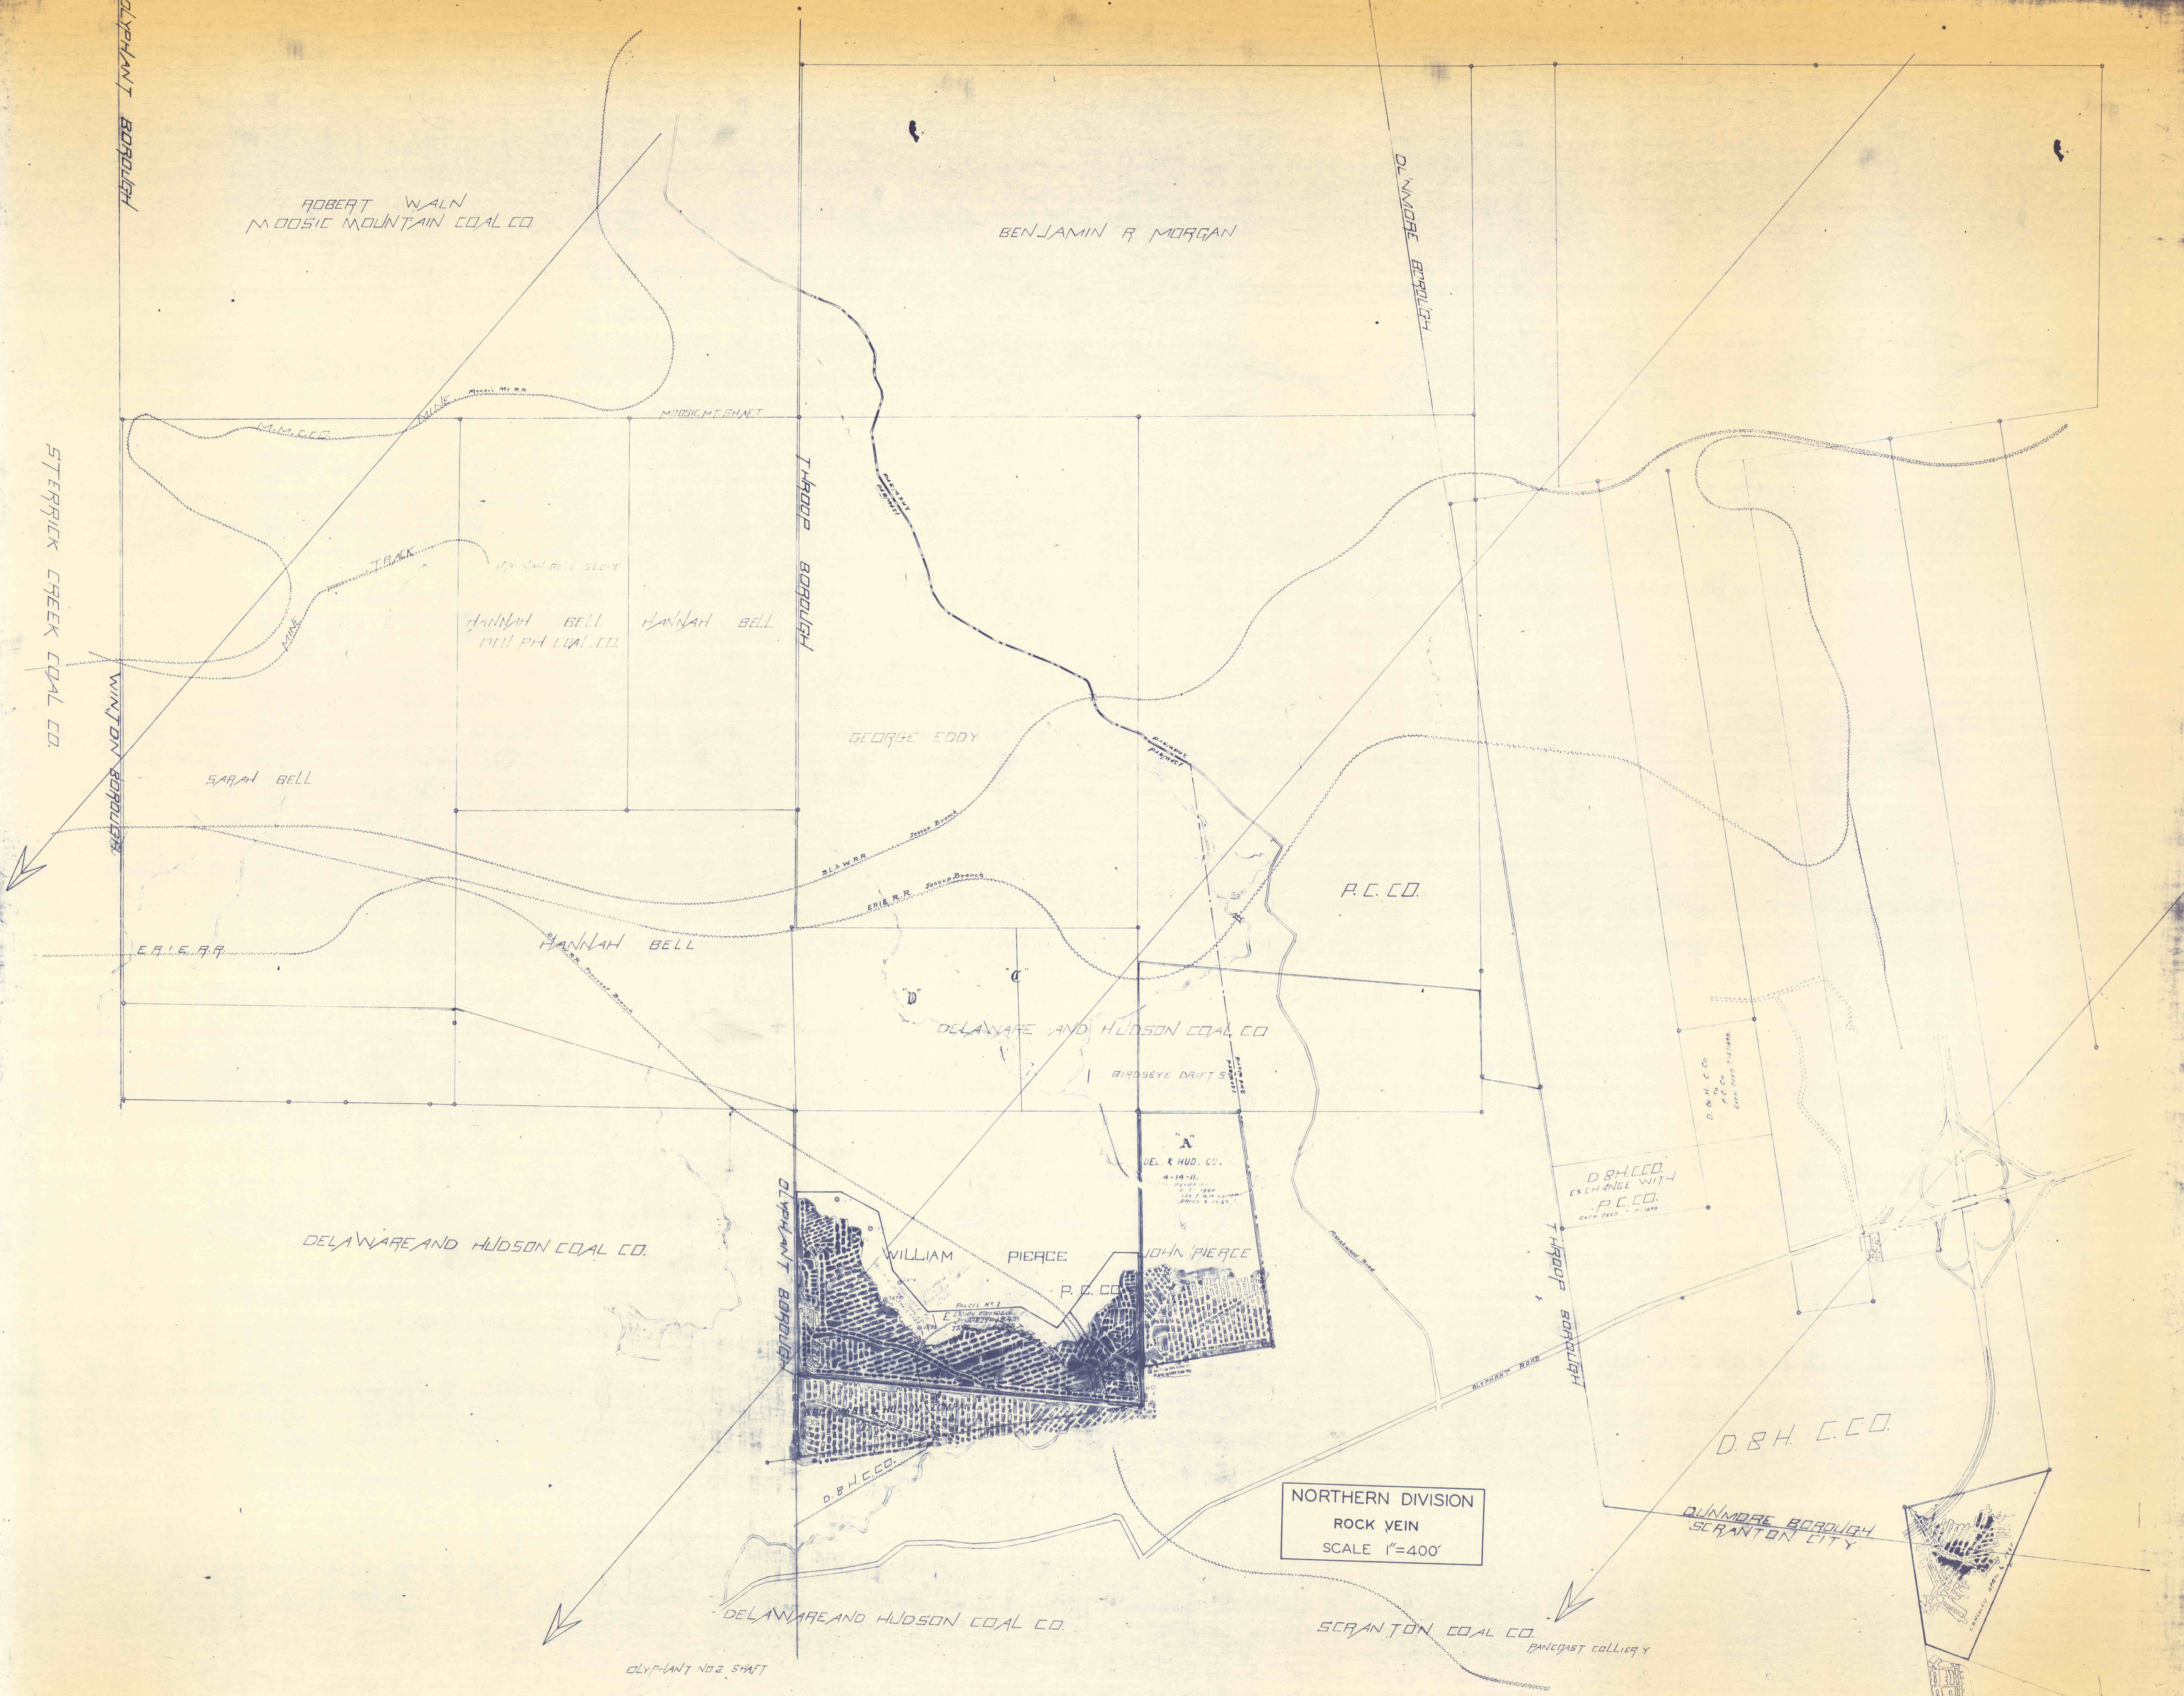

NORTHERN DIVISION
 ROCK VEIN
 SCALE 1"=400'

Rock Vein