


400 FT. MIDDLE NEW COUNTY VEIN 400 FT.

400 FT. MIDDLE NEW COUNTY VEIN 400 FT.

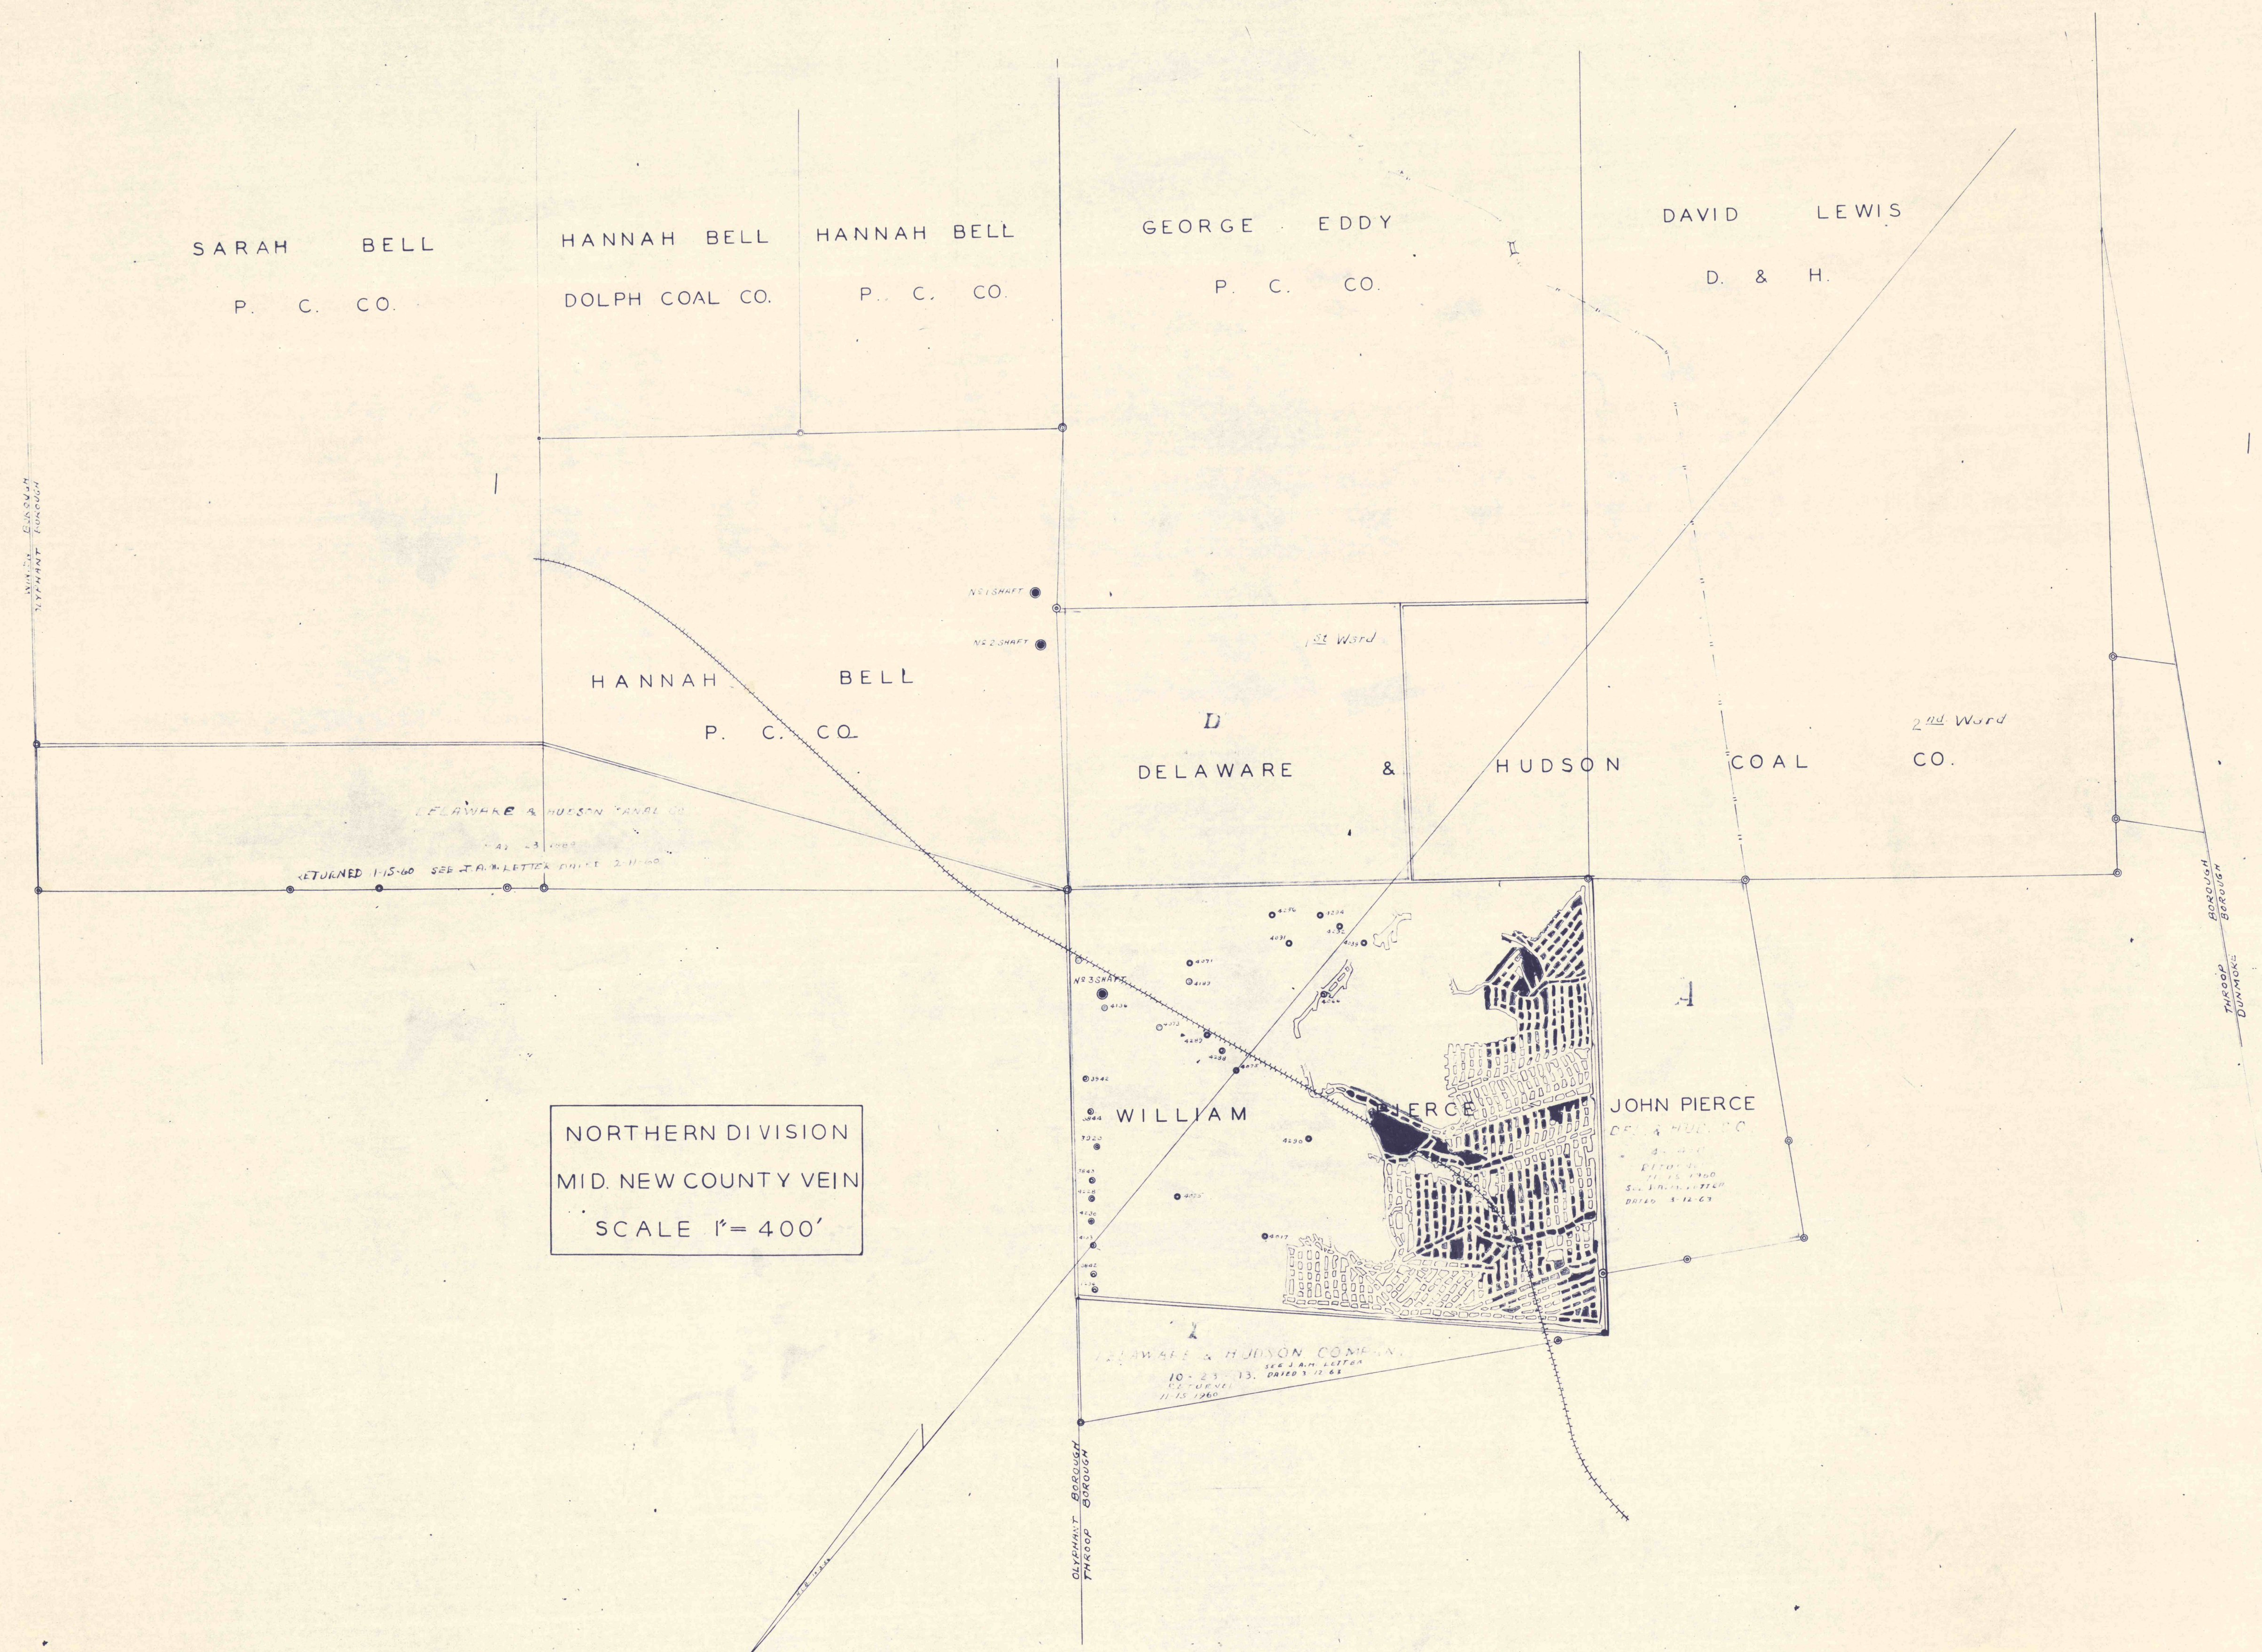

NORTHERN DIVISION
 MID. NEW COUNTY VEIN
 SCALE 1" = 400'

MIDDLE NEW COUNTY VEIN