

400 FT.

BOTTOM NEW COUNTY VEIN

400 FT.

Winton, Eddy & Olyphant Borings

SARAH BELL  
P. C. CO.

HANNAH BELL  
DOLPH COAL CO.

HANNAH BELL  
P. C. CO.

GEORGE EDDY  
P. C. CO.

HANNAH BELL  
P. C. CO.

DELAWARE & HUDSON CANAL COMPANY  
MAY 23 1888  
RETURNED TO SHERIFF'S OFFICE BY LETTER DATED 2-11-63

N#1 Shaft  
N#2 Shaft


1st Ward

"D"  
APR. 14, 1911

DELAWARE & HUDSON COAL CO.

2nd Ward

Assigned to Bay Ridge Coal Inc. 4-1-53  
VILLAGE SLOPE COAL CO.  
FEB. 2, 1914

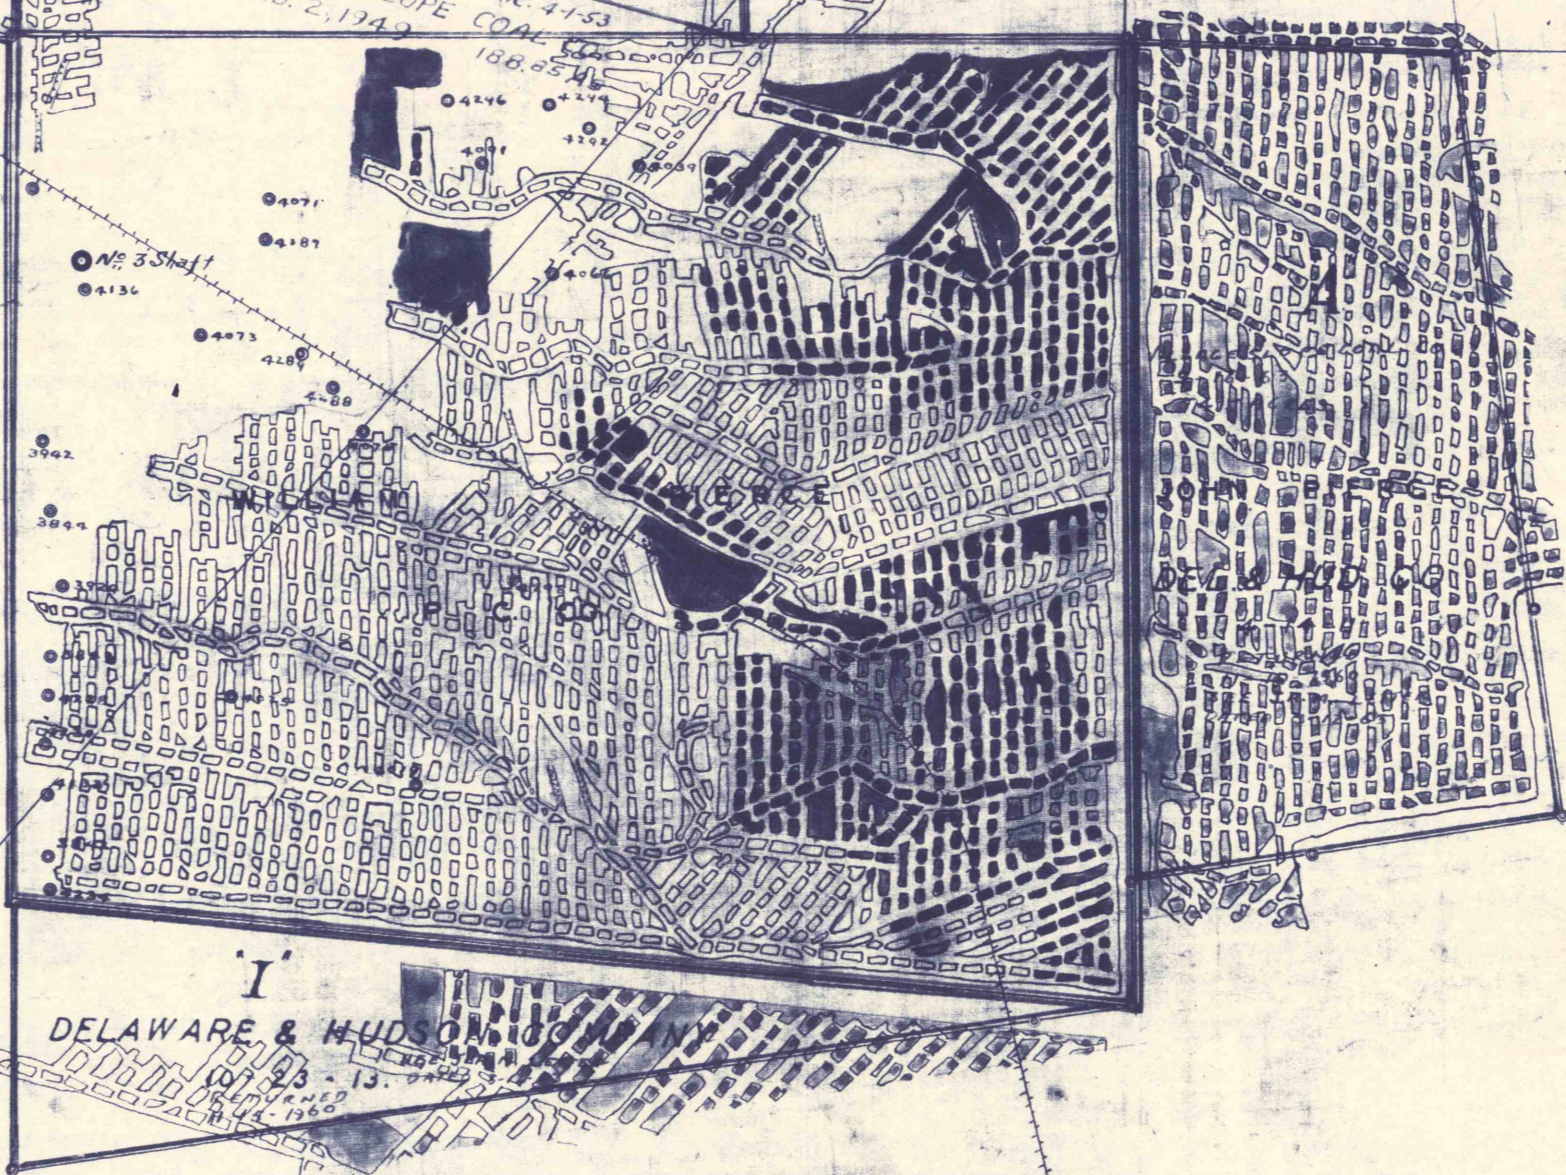

NORTHERN DIVISION  
BOT. NEW COUNTY VEIN  
SCALE 1"=400'

Olyphant Borings  
Throp Borings

Throp Borings  
Dunmire Borings

400 FT.

BOTTOM NEW COUNTY VEIN

400 FT.

BOT. NEW COUNTY VEIN