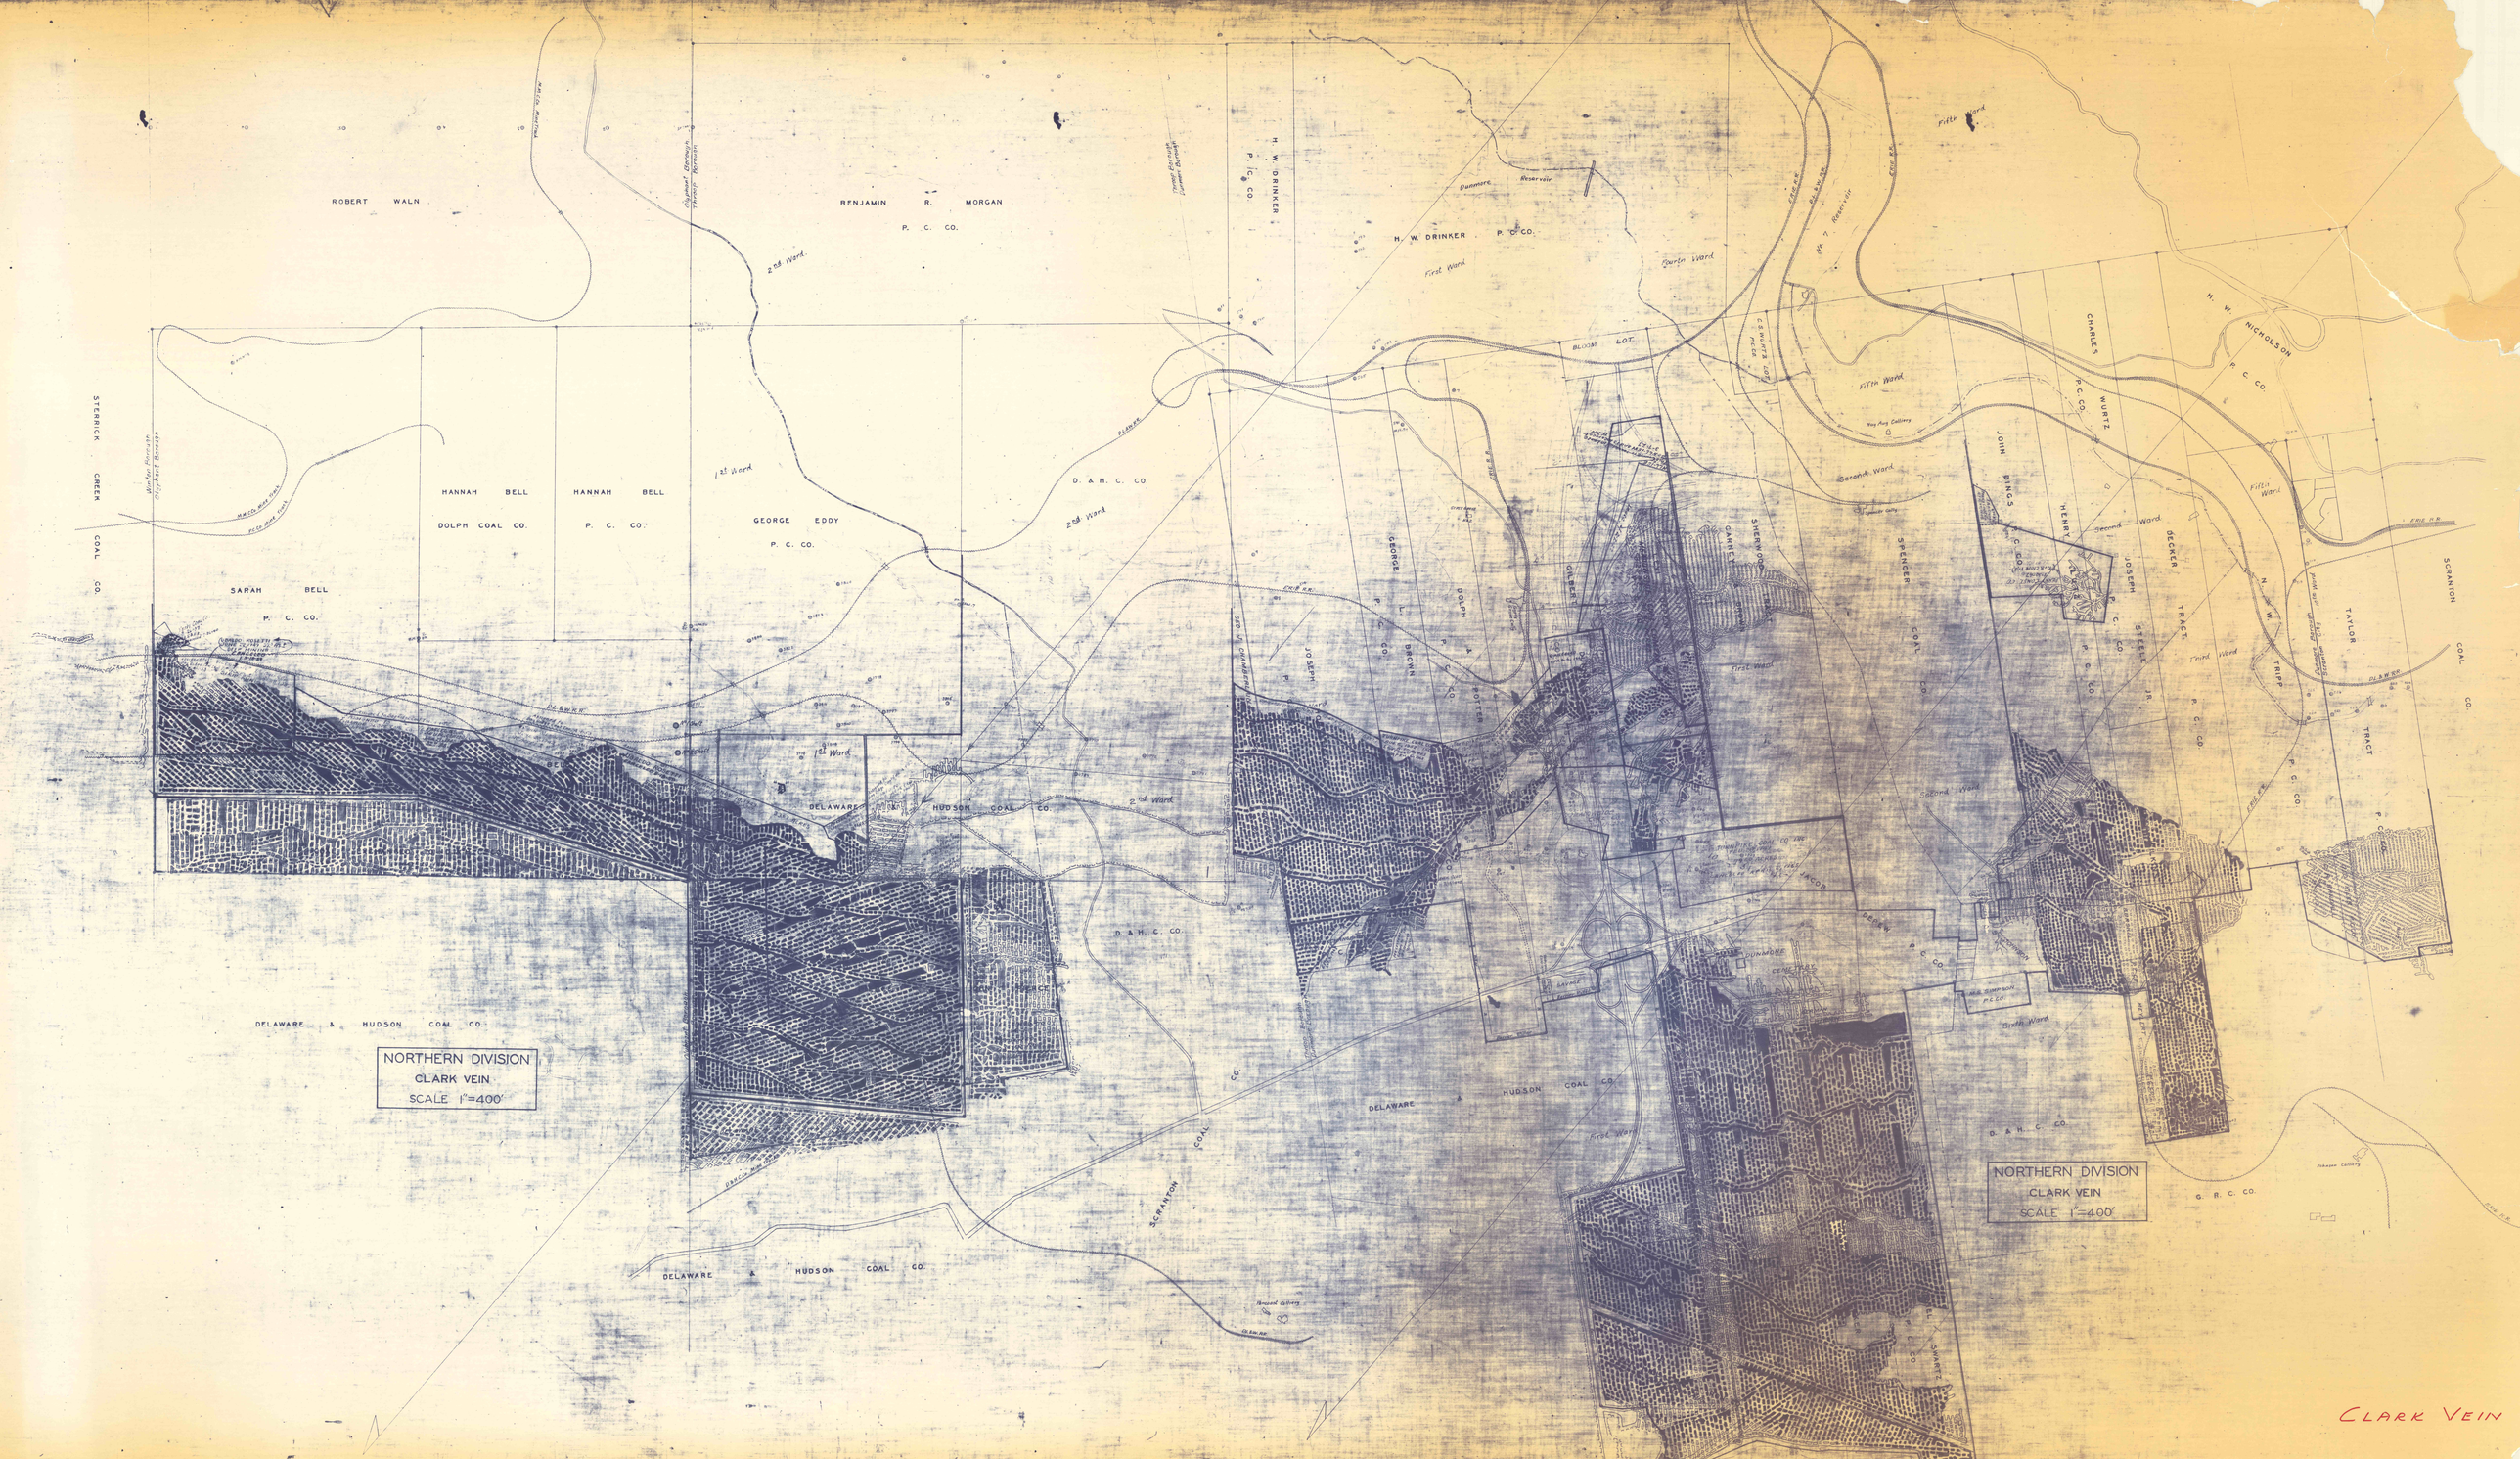
ROBERT WALN
BENJAMIN R. MORGAN
P. C. CO.
H. W. DRINKER
P. C. CO.
H. W. DRINKER P. C. CO.
STERRICK CREEK COAL CO.
HANNAH BELL
DOLPH COAL CO.
HANNAH BELL
P. C. CO.
GEORGE EDDY
P. C. CO.
D. & H. C. CO.
SARAH BELL
P. C. CO.
DELAWARE & HUDSON COAL CO.
NORTHERN DIVISION
CLARK VEIN
SCALE 1"=400'
SCRANTON COAL CO.
CHARLES WURTZ P. C. CO.
H. W. NICHOLSON P. C. CO.
JOHN DINGS
HENRY
JOSEPH STEELE JR.
BECKER TRACT
TAYLOR
TRIPP
G. R. C. CO.
NORTHERN DIVISION
CLARK VEIN
SCALE 1"=400'
CLARK VEIN