

TOP 2ND DUNMORE VEIN

400'

NORTHERN DIVISION

400'

TOP 2ND DUNMORE VEIN


TOP 2ND DUNMORE VEIN

400'

NORTHERN DIVISION

400'

TOP 2ND DUNMORE VEIN

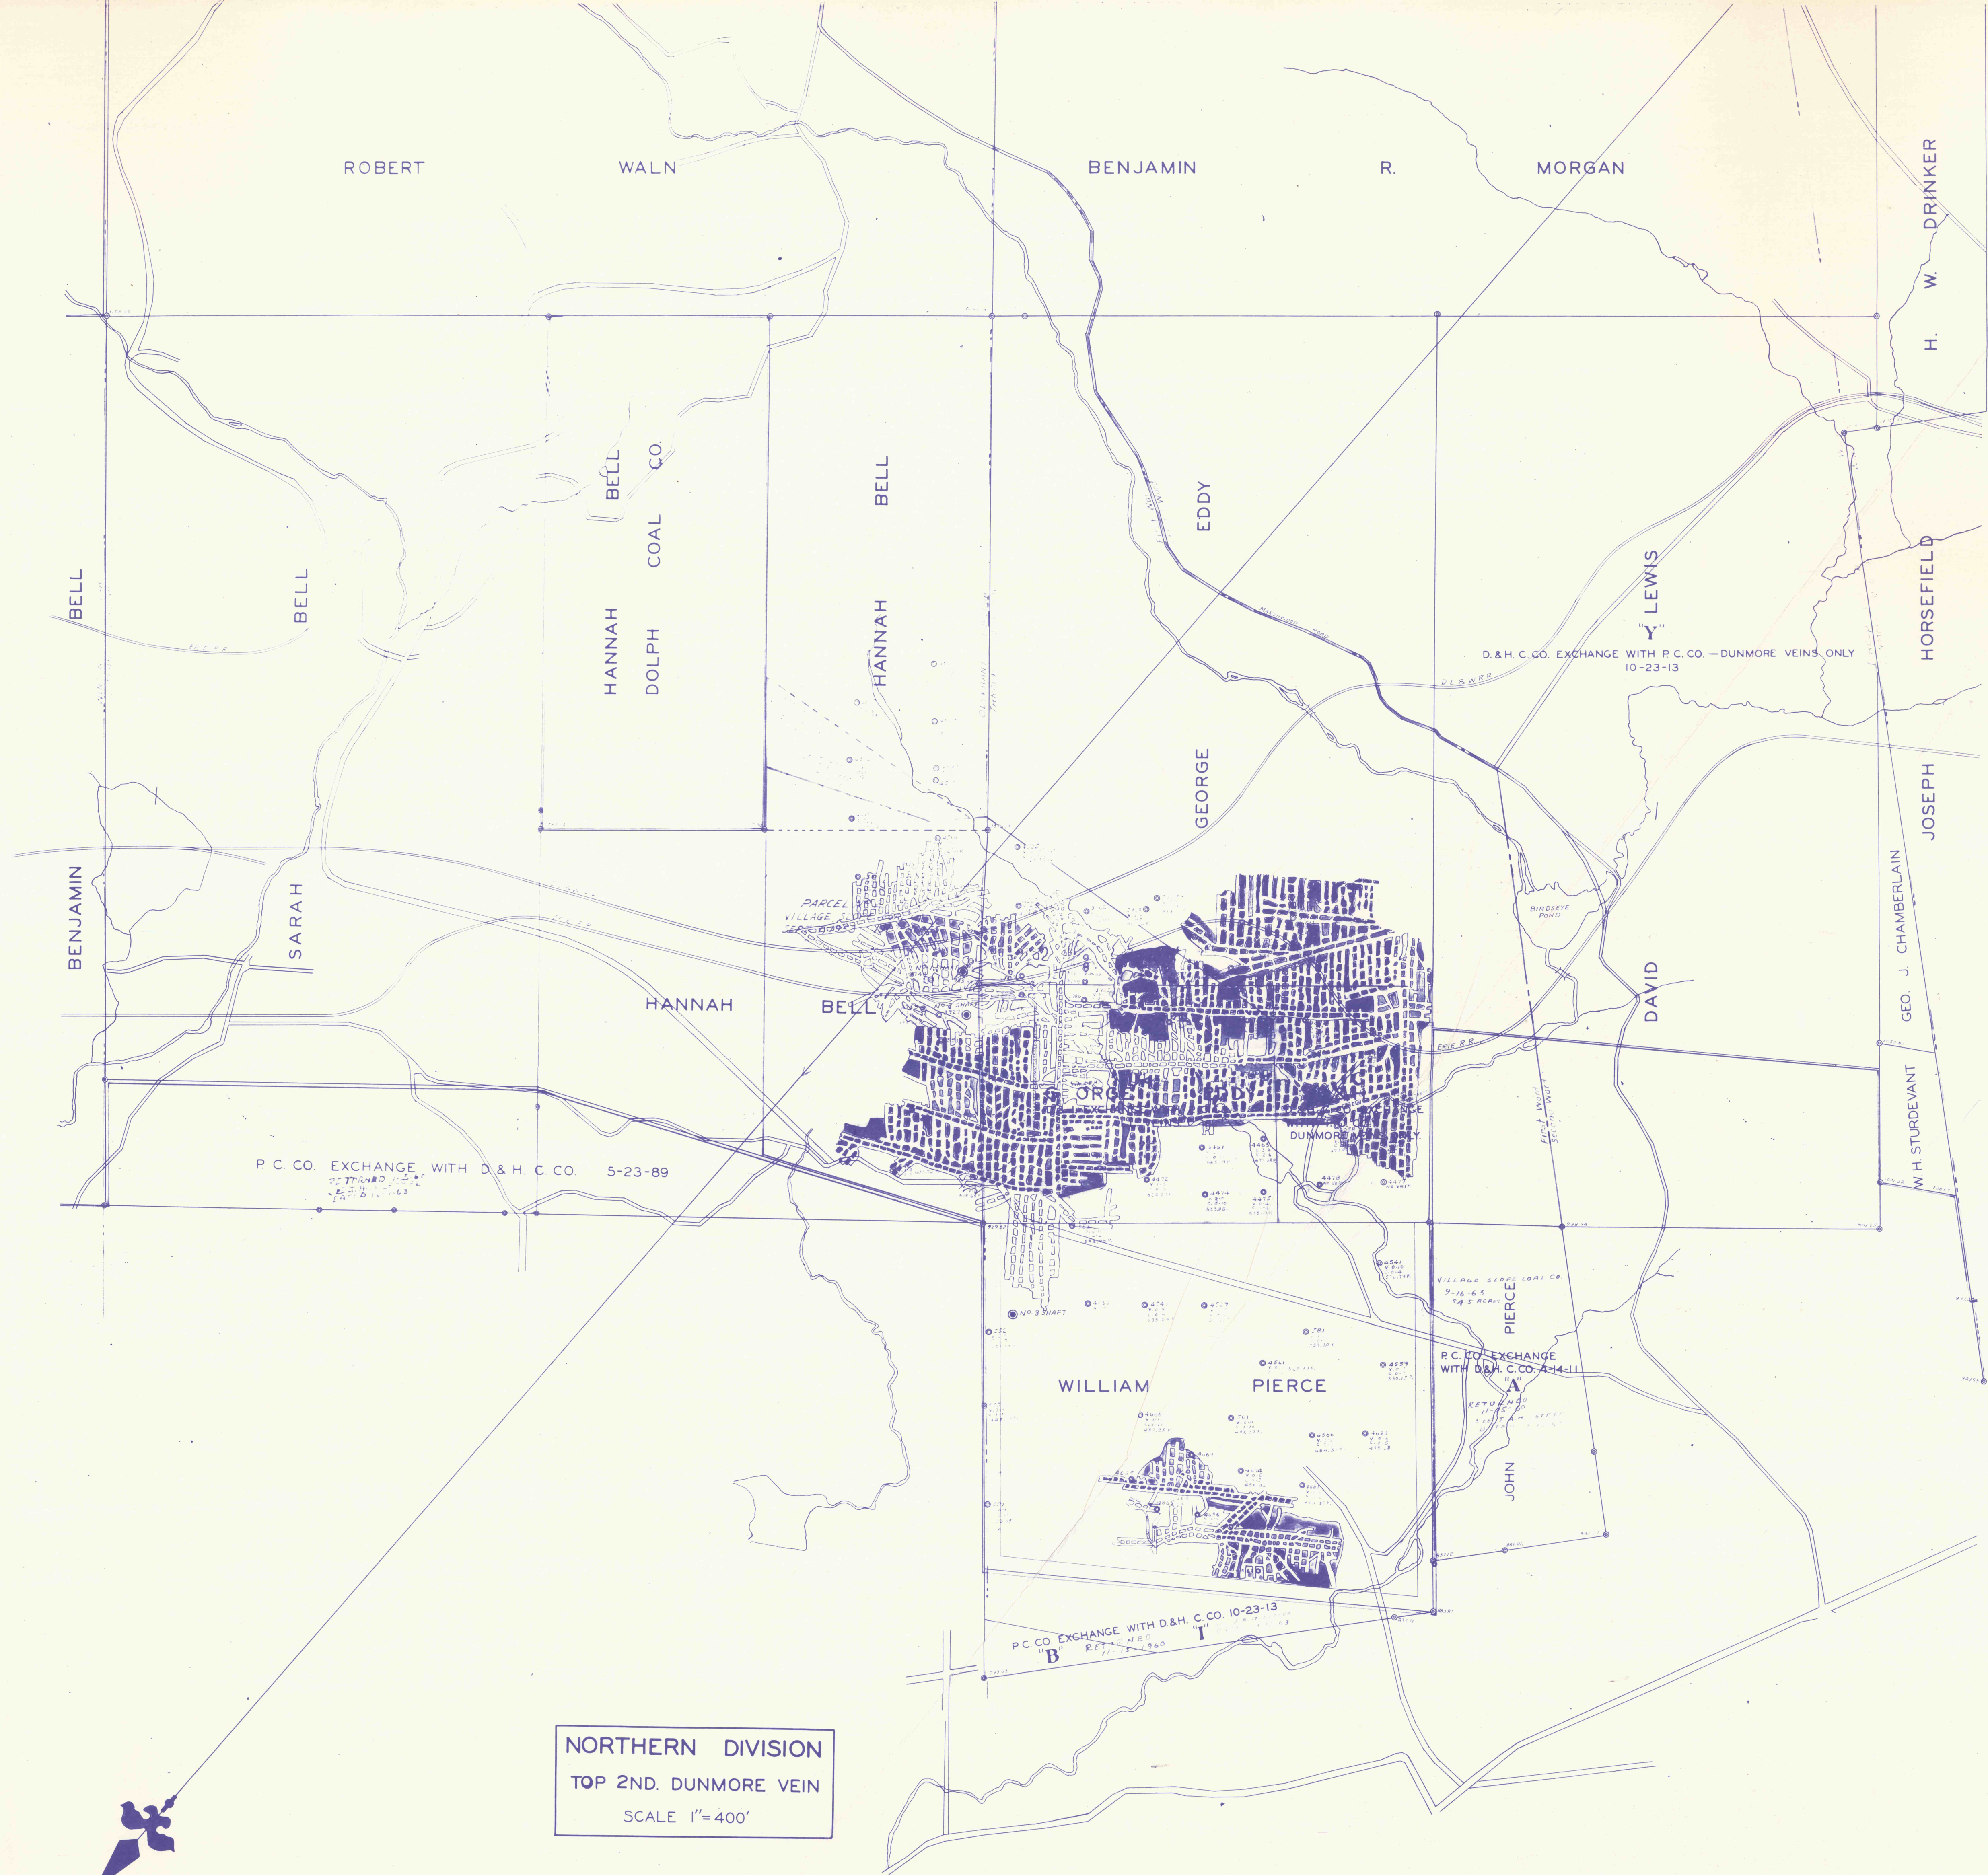

NORTHERN DIVISION
 TOP 2ND. DUNMORE VEIN
 SCALE 1"=400'

TOP
 No. 2 DUNMORE
 VEIN