


MID. 2ND. DUNMORE VEIN

400.

NORTHERN DIVISION

400.

MID. 2ND. DUNMORE VEIN

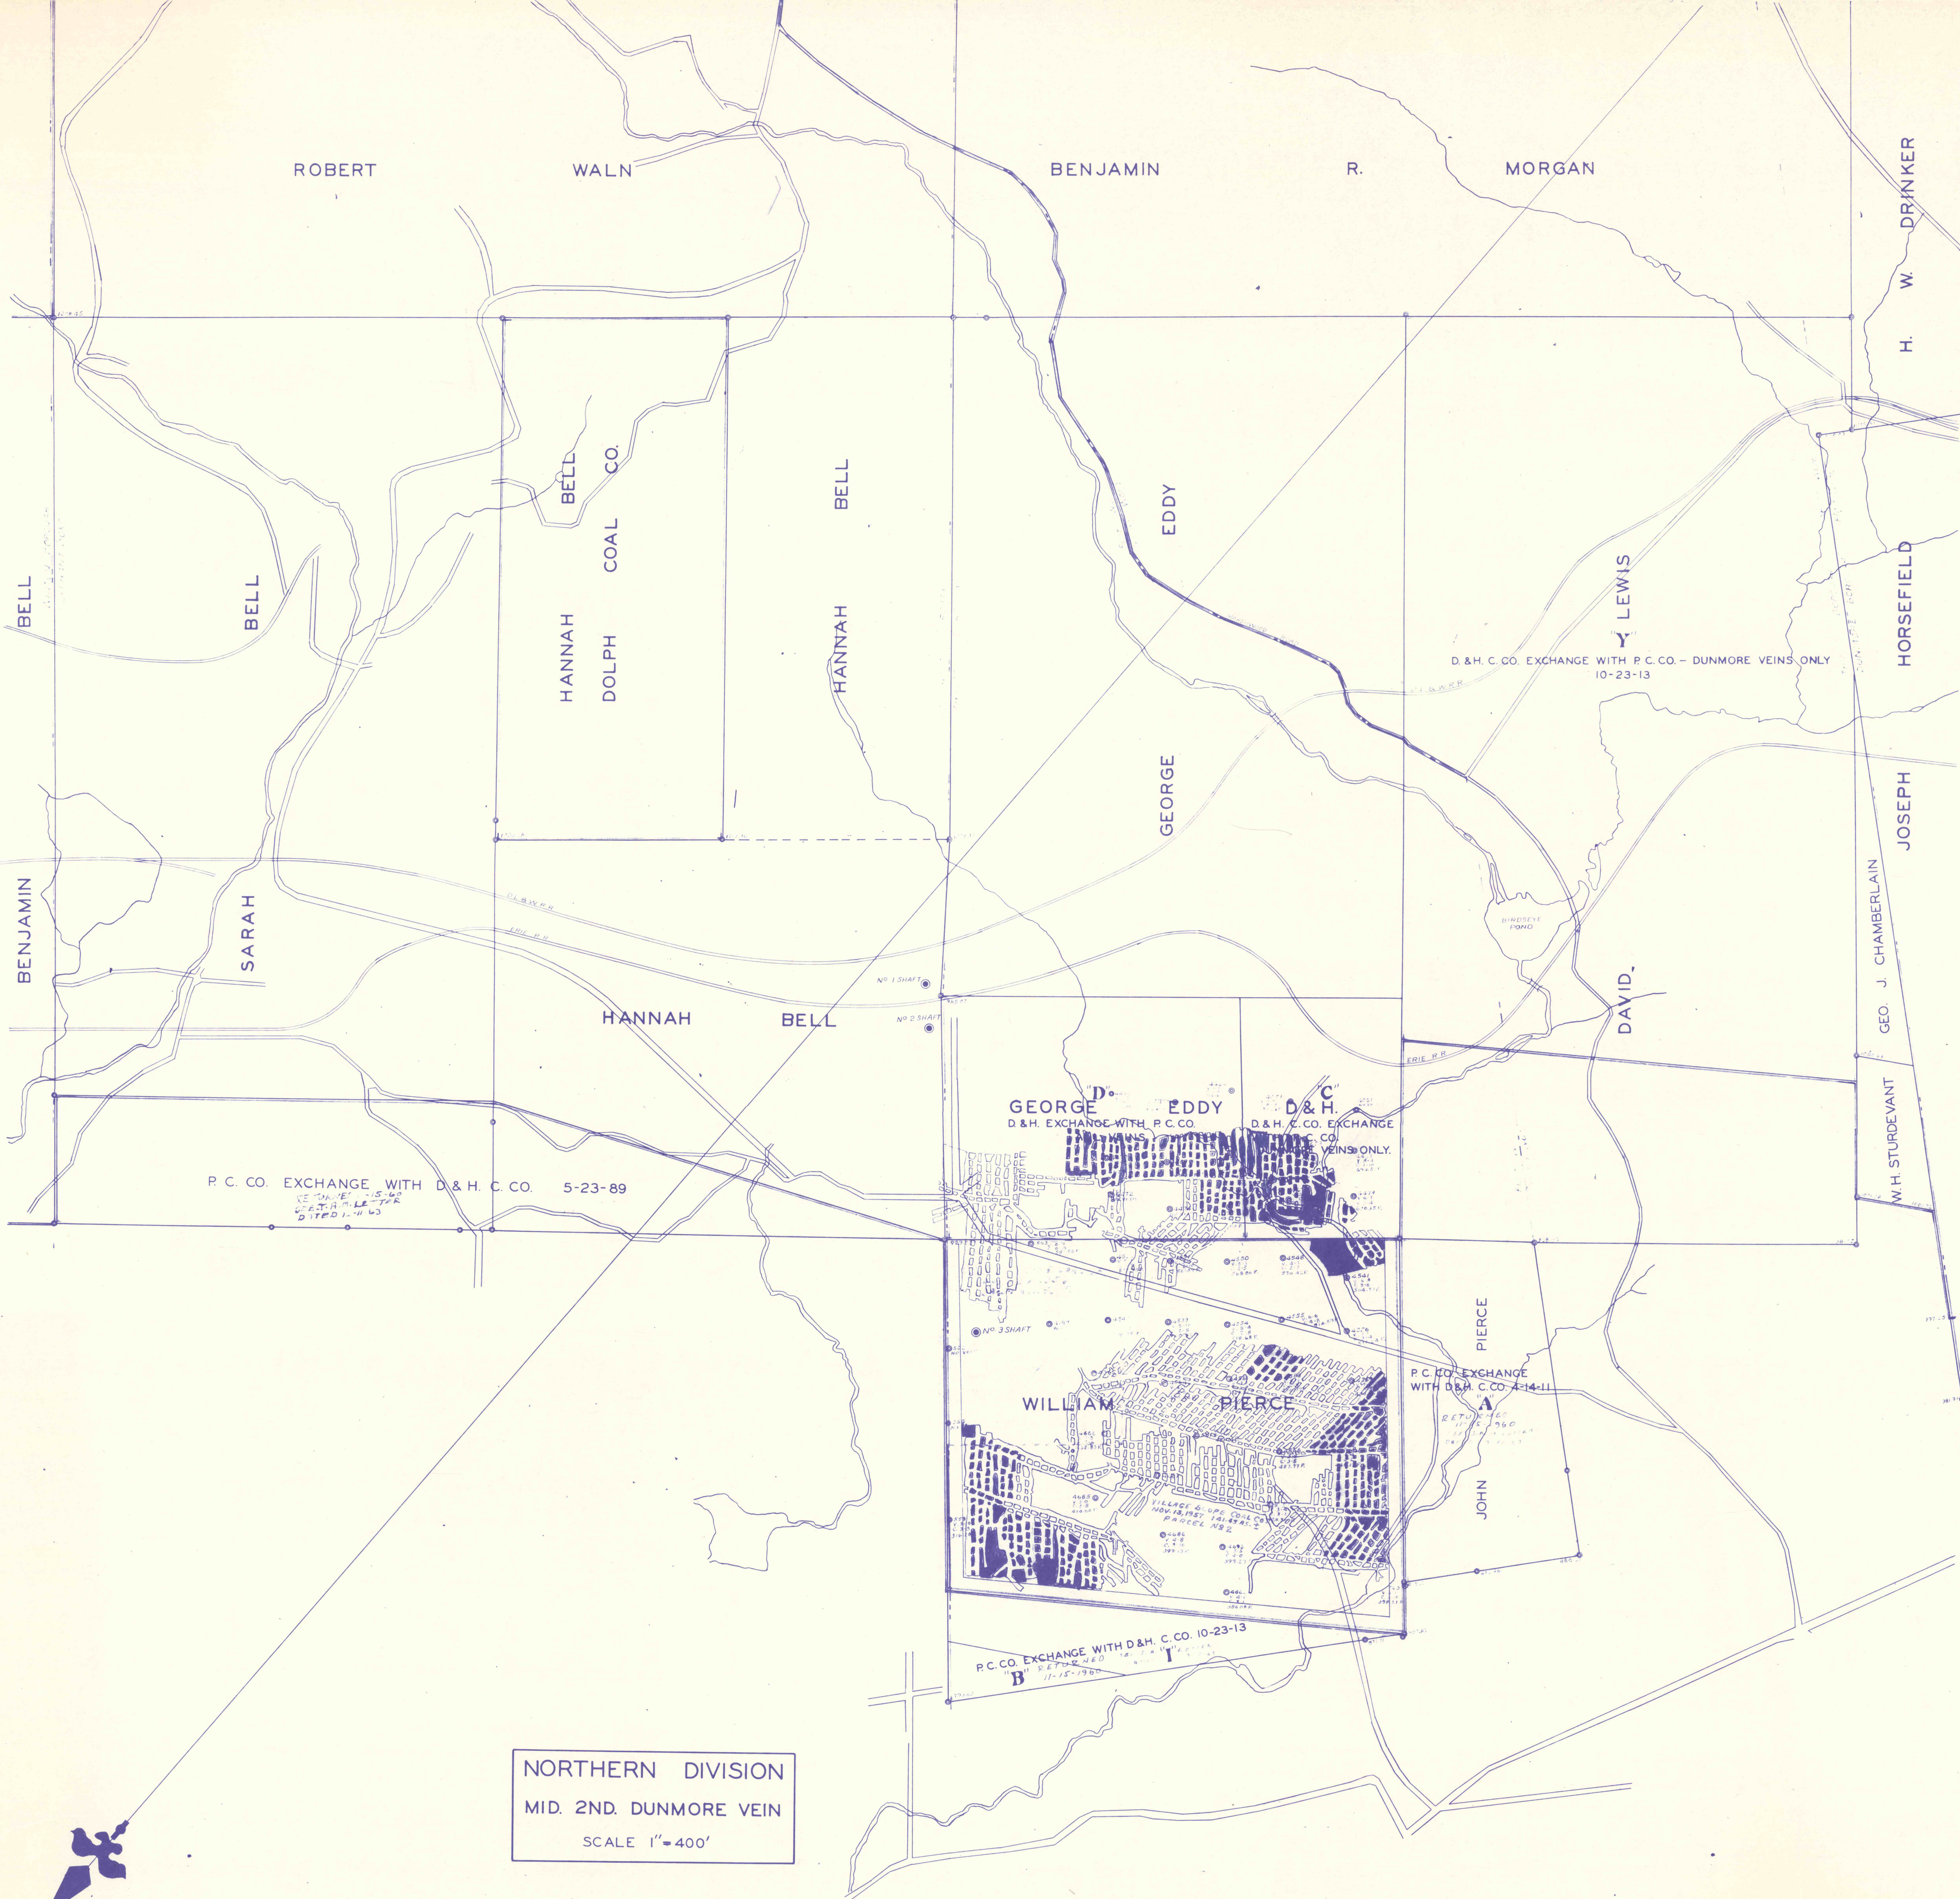

NORTHERN DIVISION
 MID. 2ND. DUNMORE VEIN
 SCALE 1" = 400'

MIDDLE
 No. 2 DUNMORE VEIN