


J. B. SMITH TO PENNSYLVANIA COAL CO.
MAR. 31, 1883.
P. C. CO. TO DEL. & HUD. CANAL CO.
MAY 23, 1889

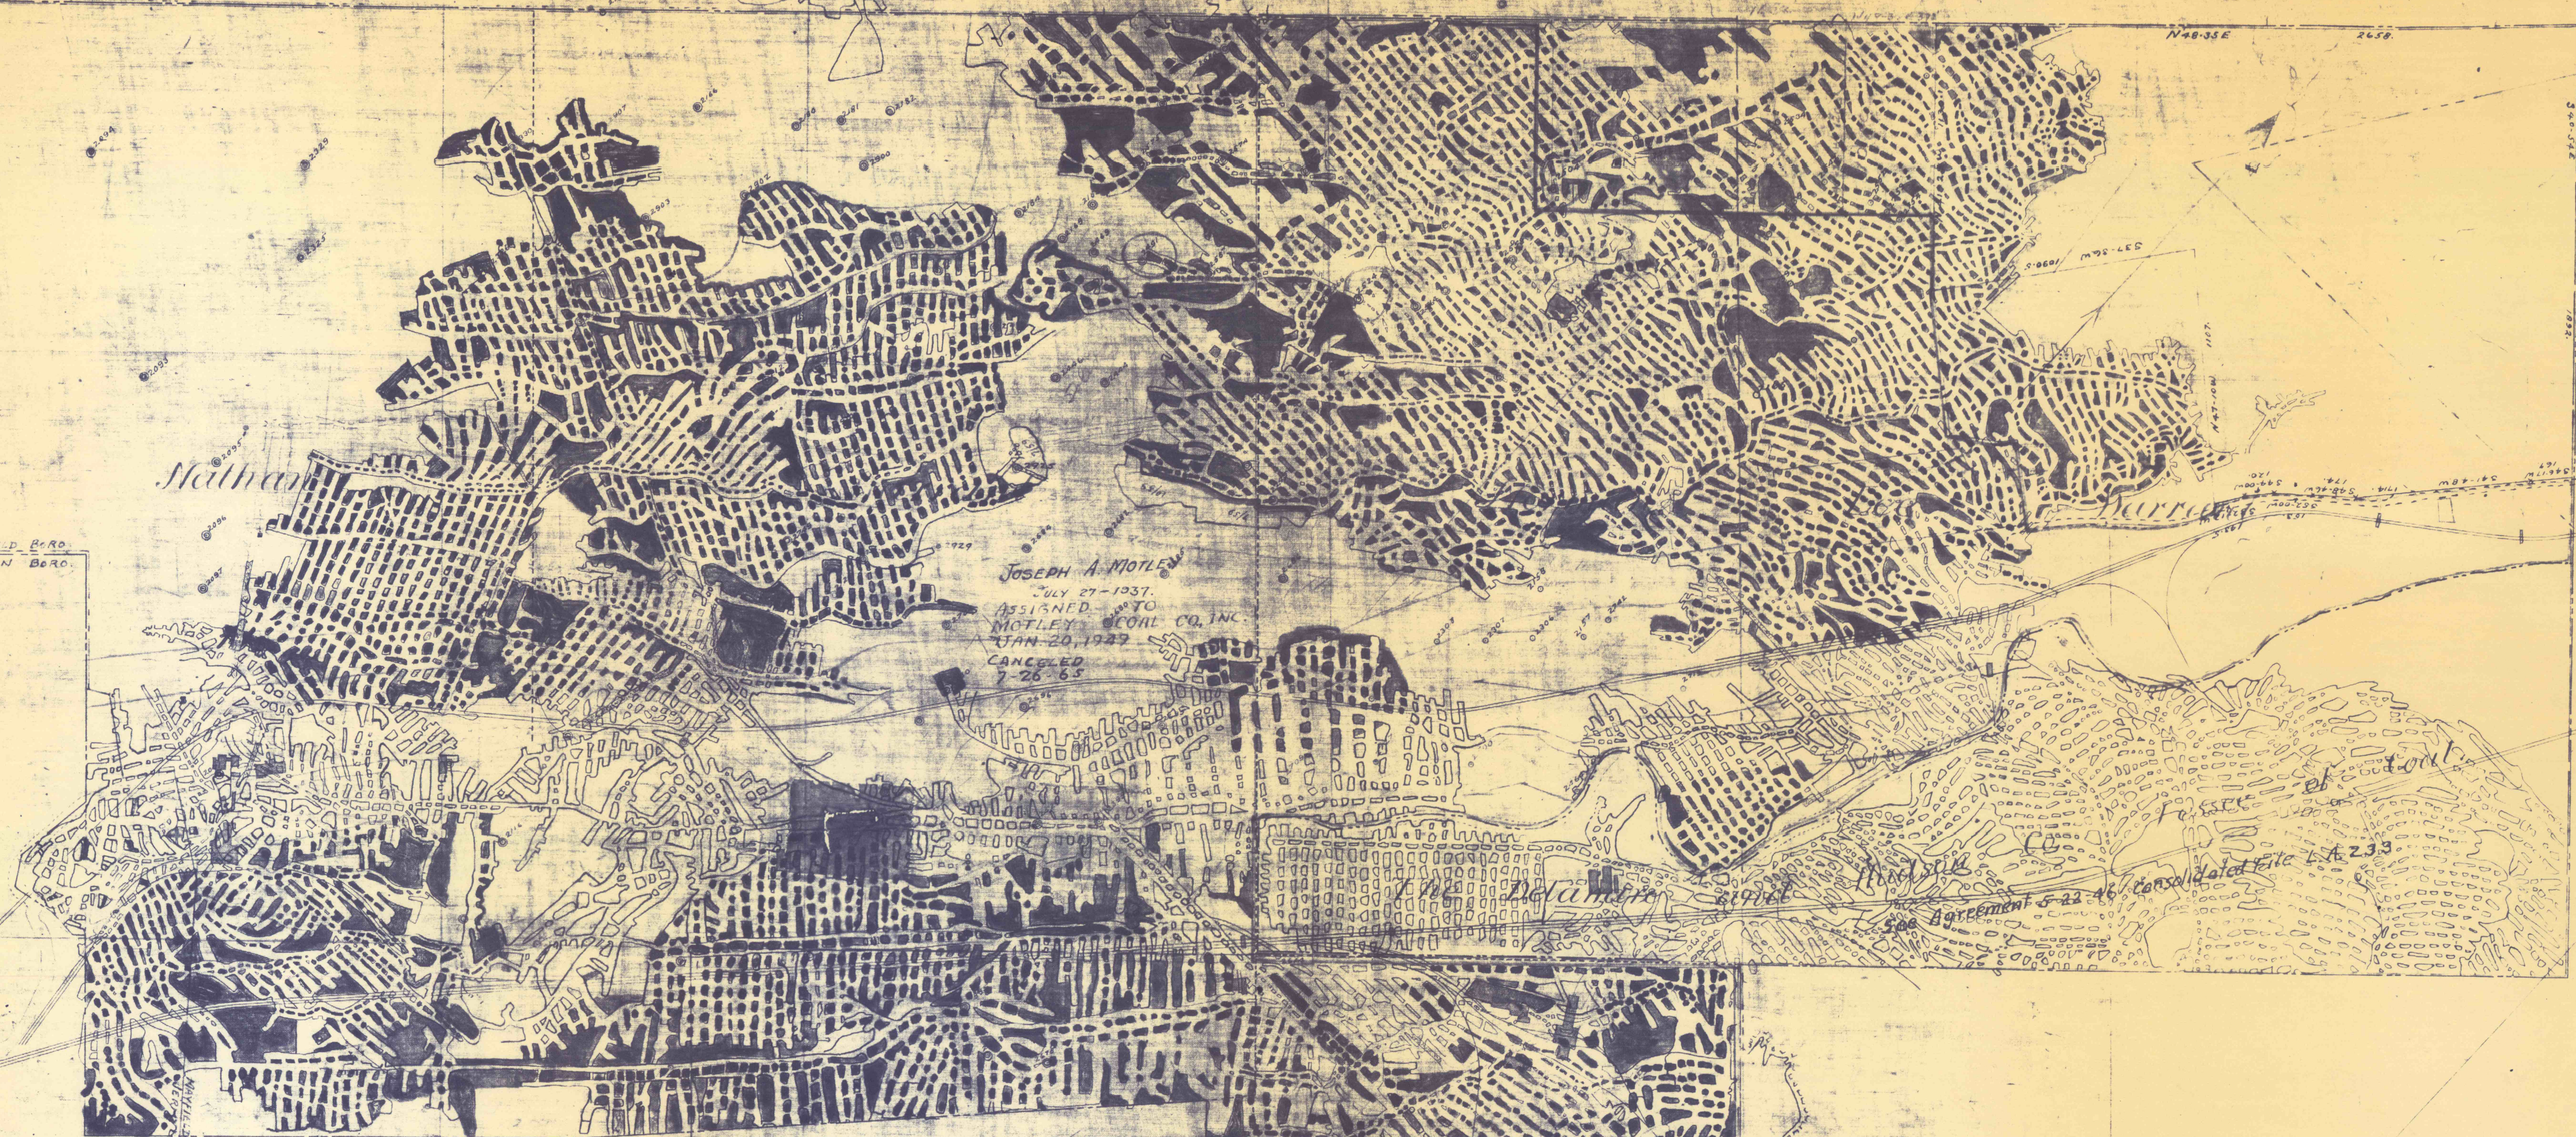


MAYFIELD
NEW COUNTY VEIN
SCALE, 1"=400'

Peter Rider Warrant.

James Rider Warrant.

Samuel Rider Warrant.

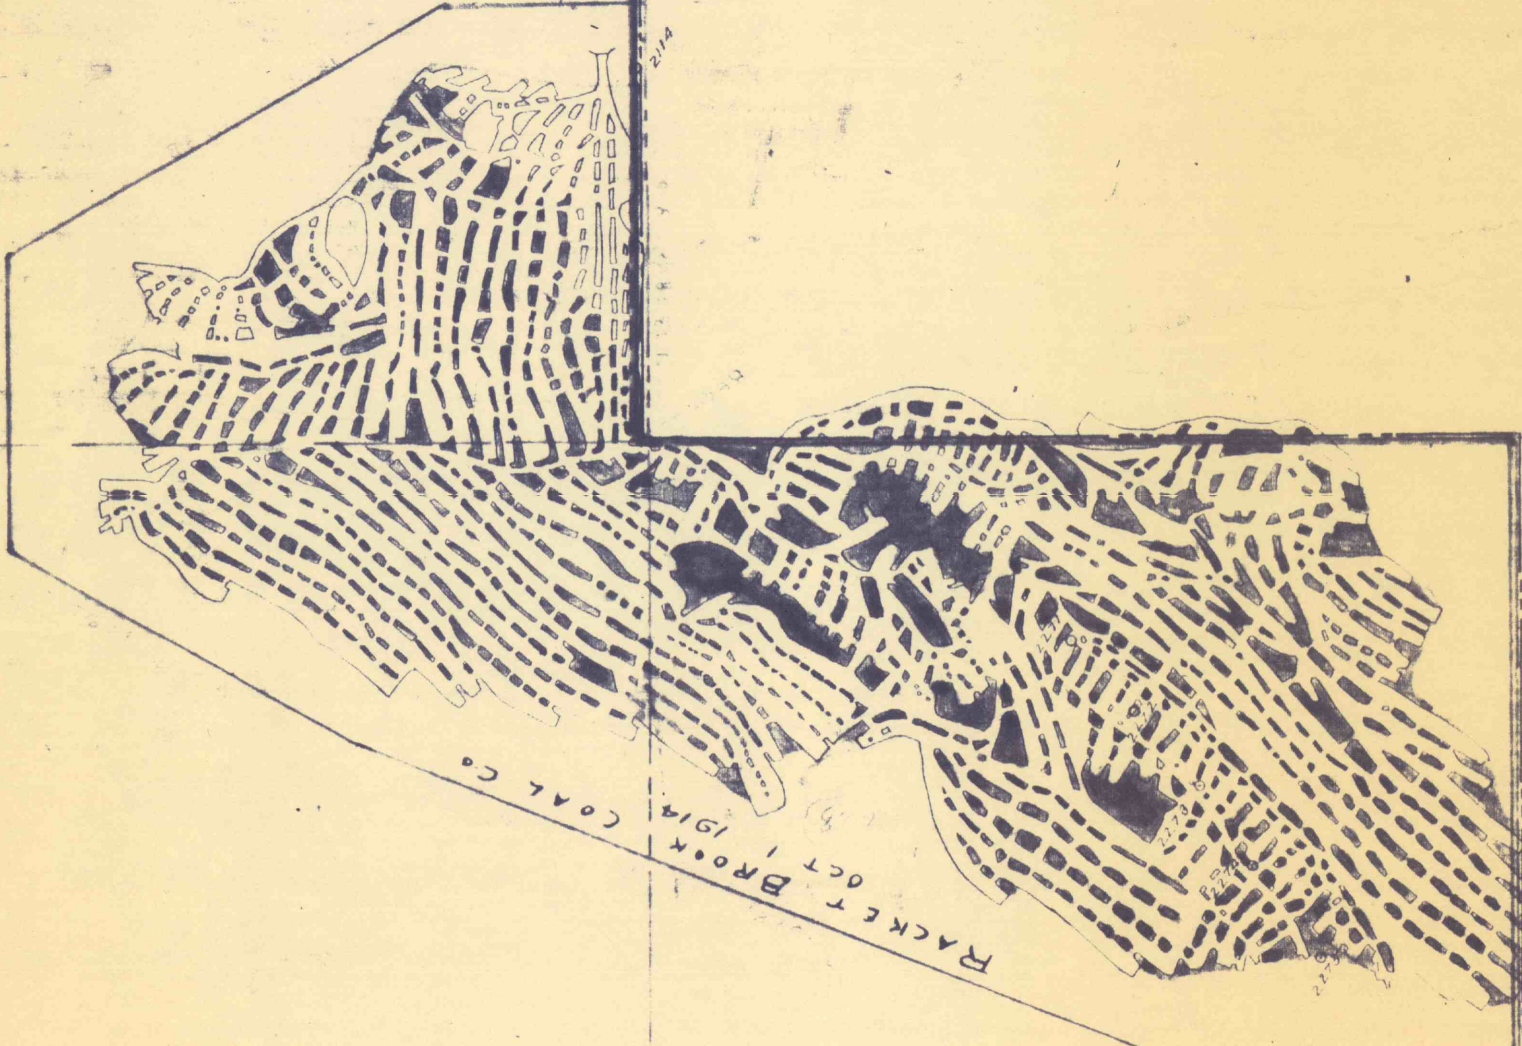

RACKET BROOK COAL CO.
JULY 15, 1932
SHE. OF AS. 1

Benjamin Ryan Warr.

*GRASSY ISLAND VEIN
NEW COUNTY VEIN*