


J. B. SMITH TO PENNSYLVANIA COAL CO.
MAR. 31, 1843
F. C. CO TO DEL & HUD. CANAL CO.
MAY 23, 1859



MAYFIELD
CLARK VEIN
SCALE 1"=400'

Peter Rider Warrant James Rider Warrant Samuel Rider Warrant

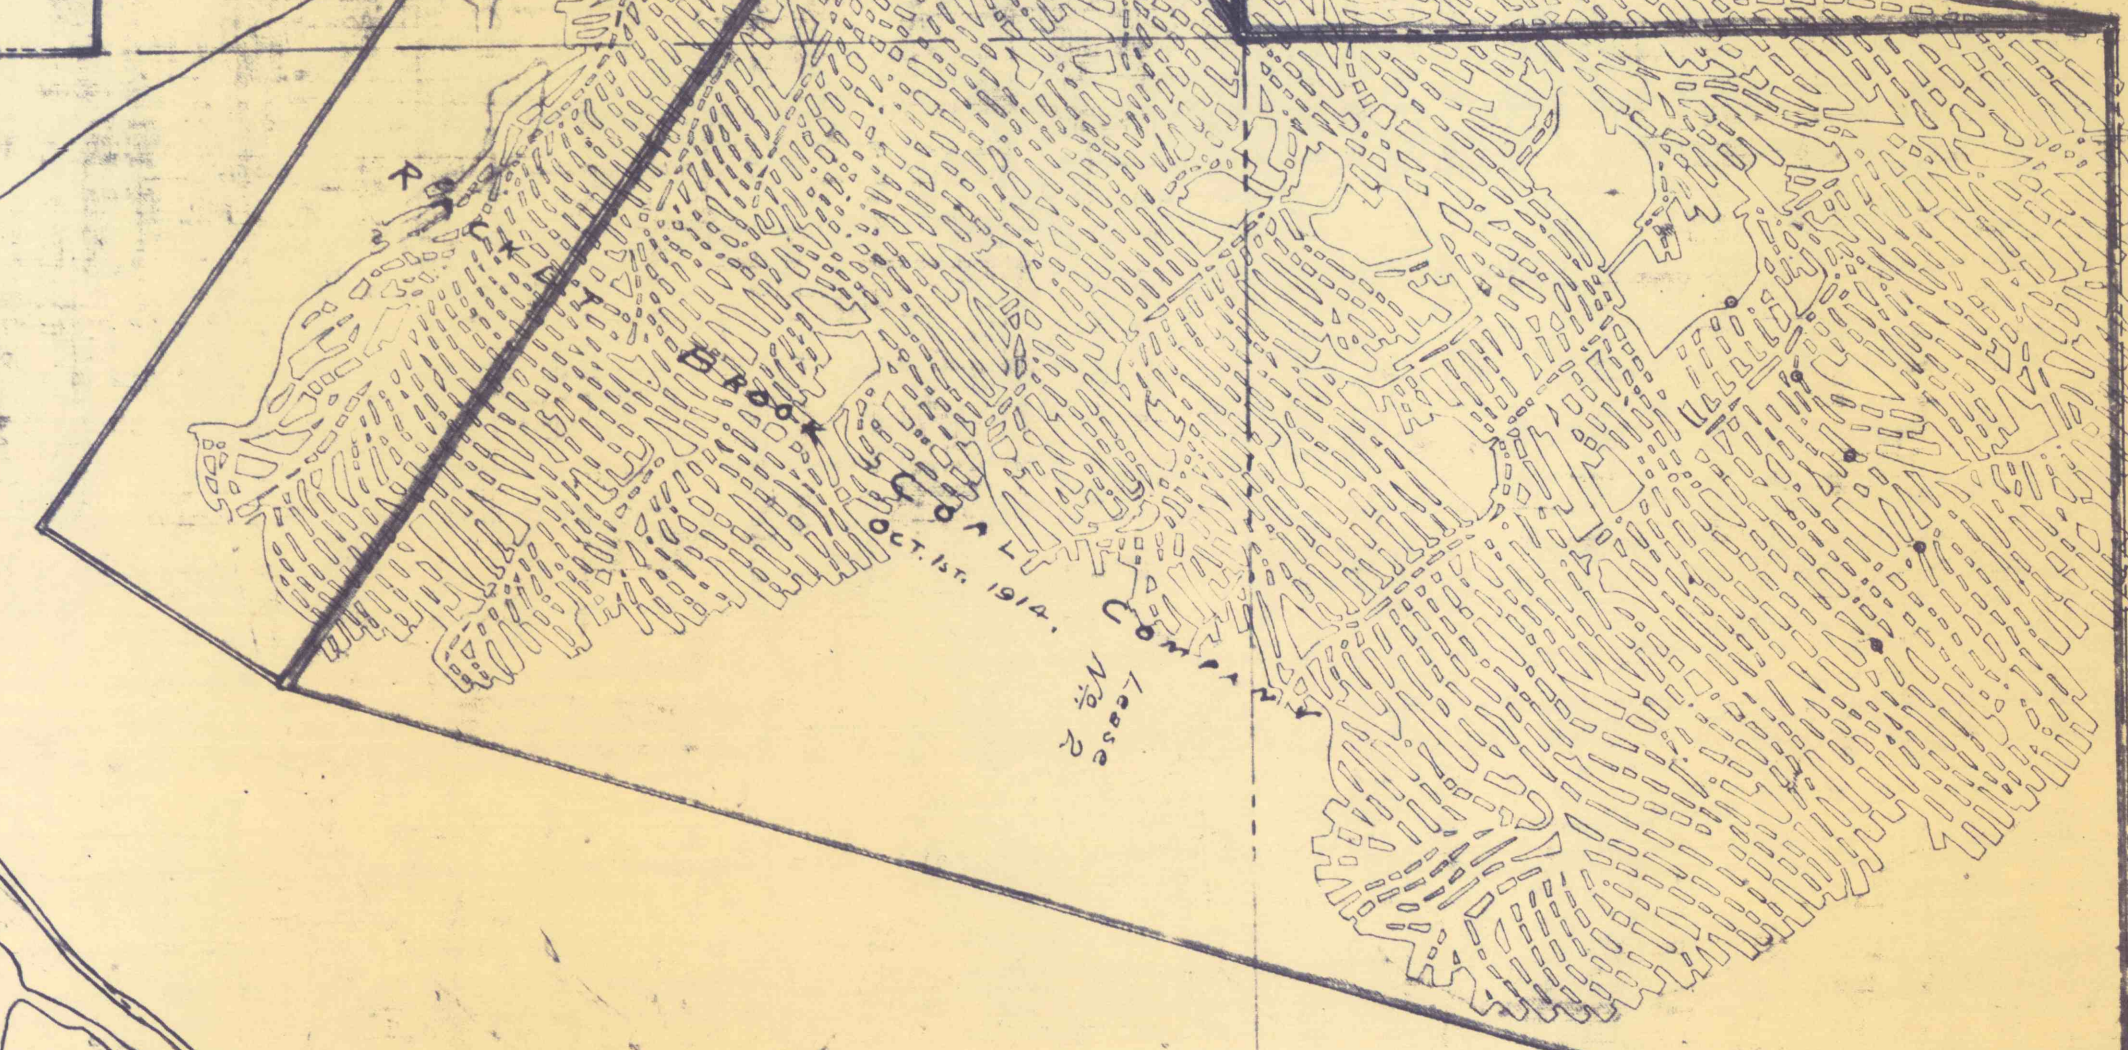

Benjamin Ryan Warrant
BROOK L. S. COAL CO.
JULY 15, 1842
516.14 152

NEW COUNTY V.
CLARK VEIN