


EXTENSION OF MINE WORKINGS  
APPLIED HEREON BY  
ON

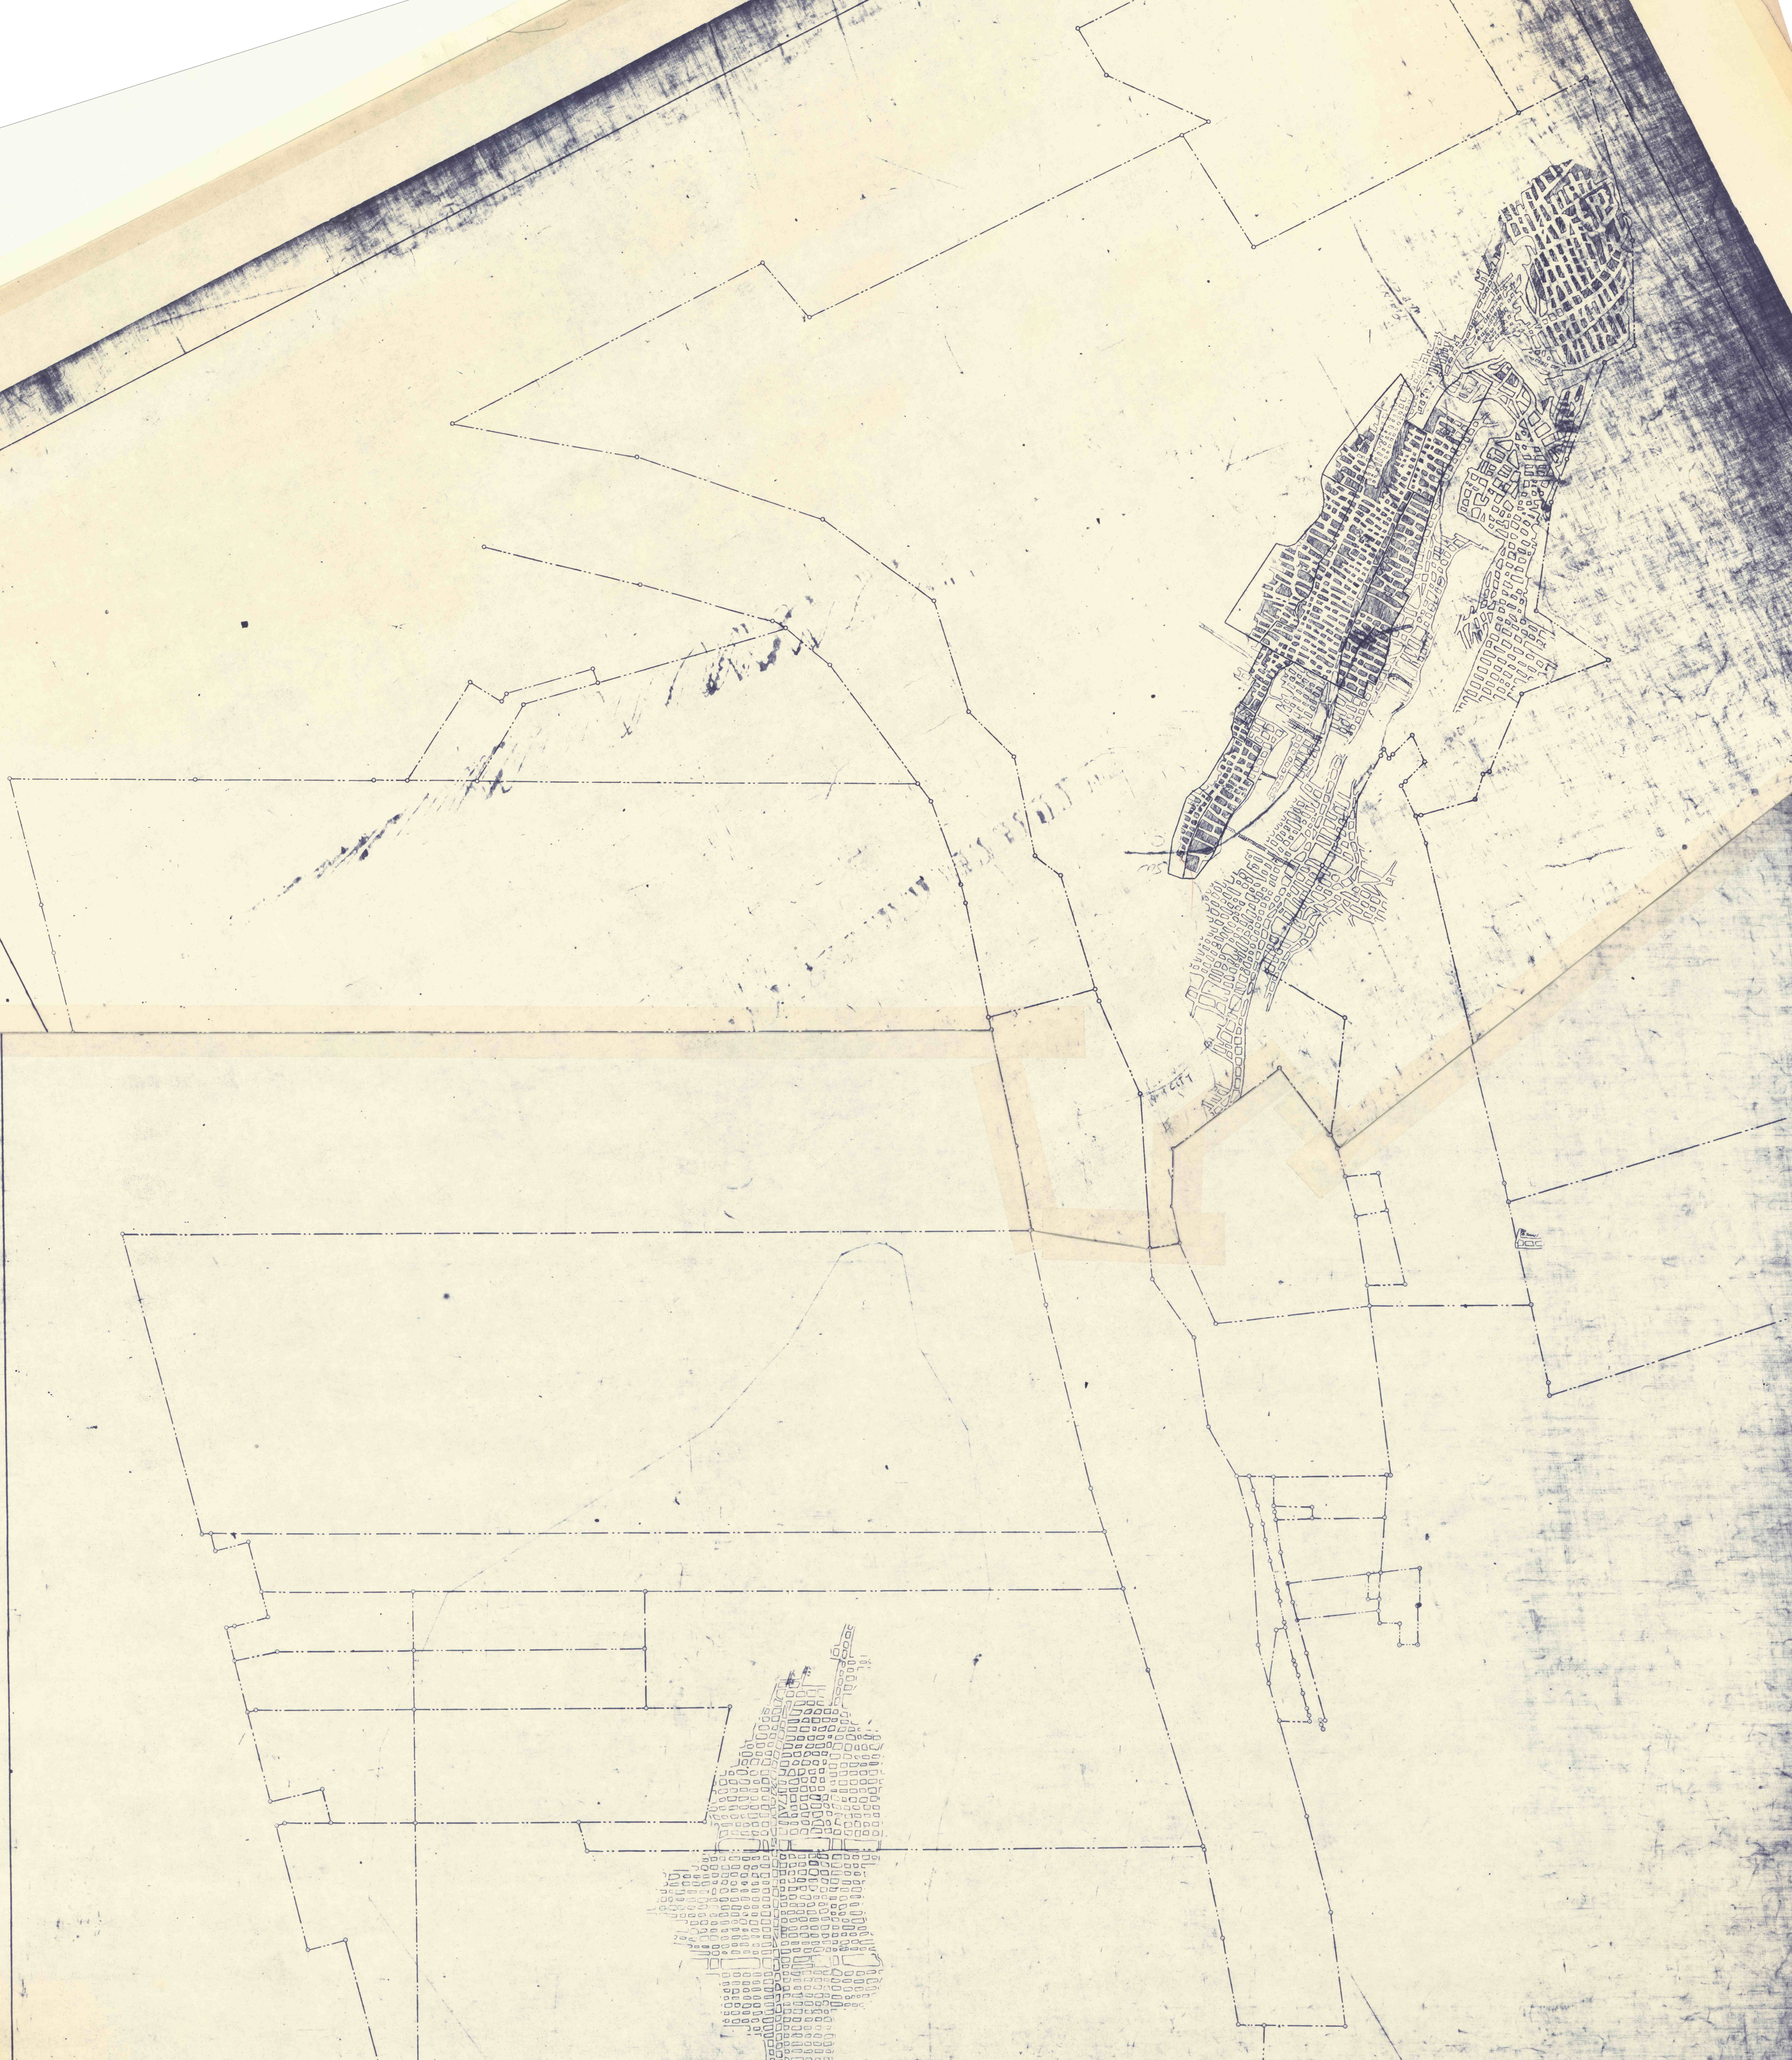

*Dorrance*  
SNAKE ISLAND