


EXTENSION OF MINE WORKINGS
APPLIED HERE ON BY
ON

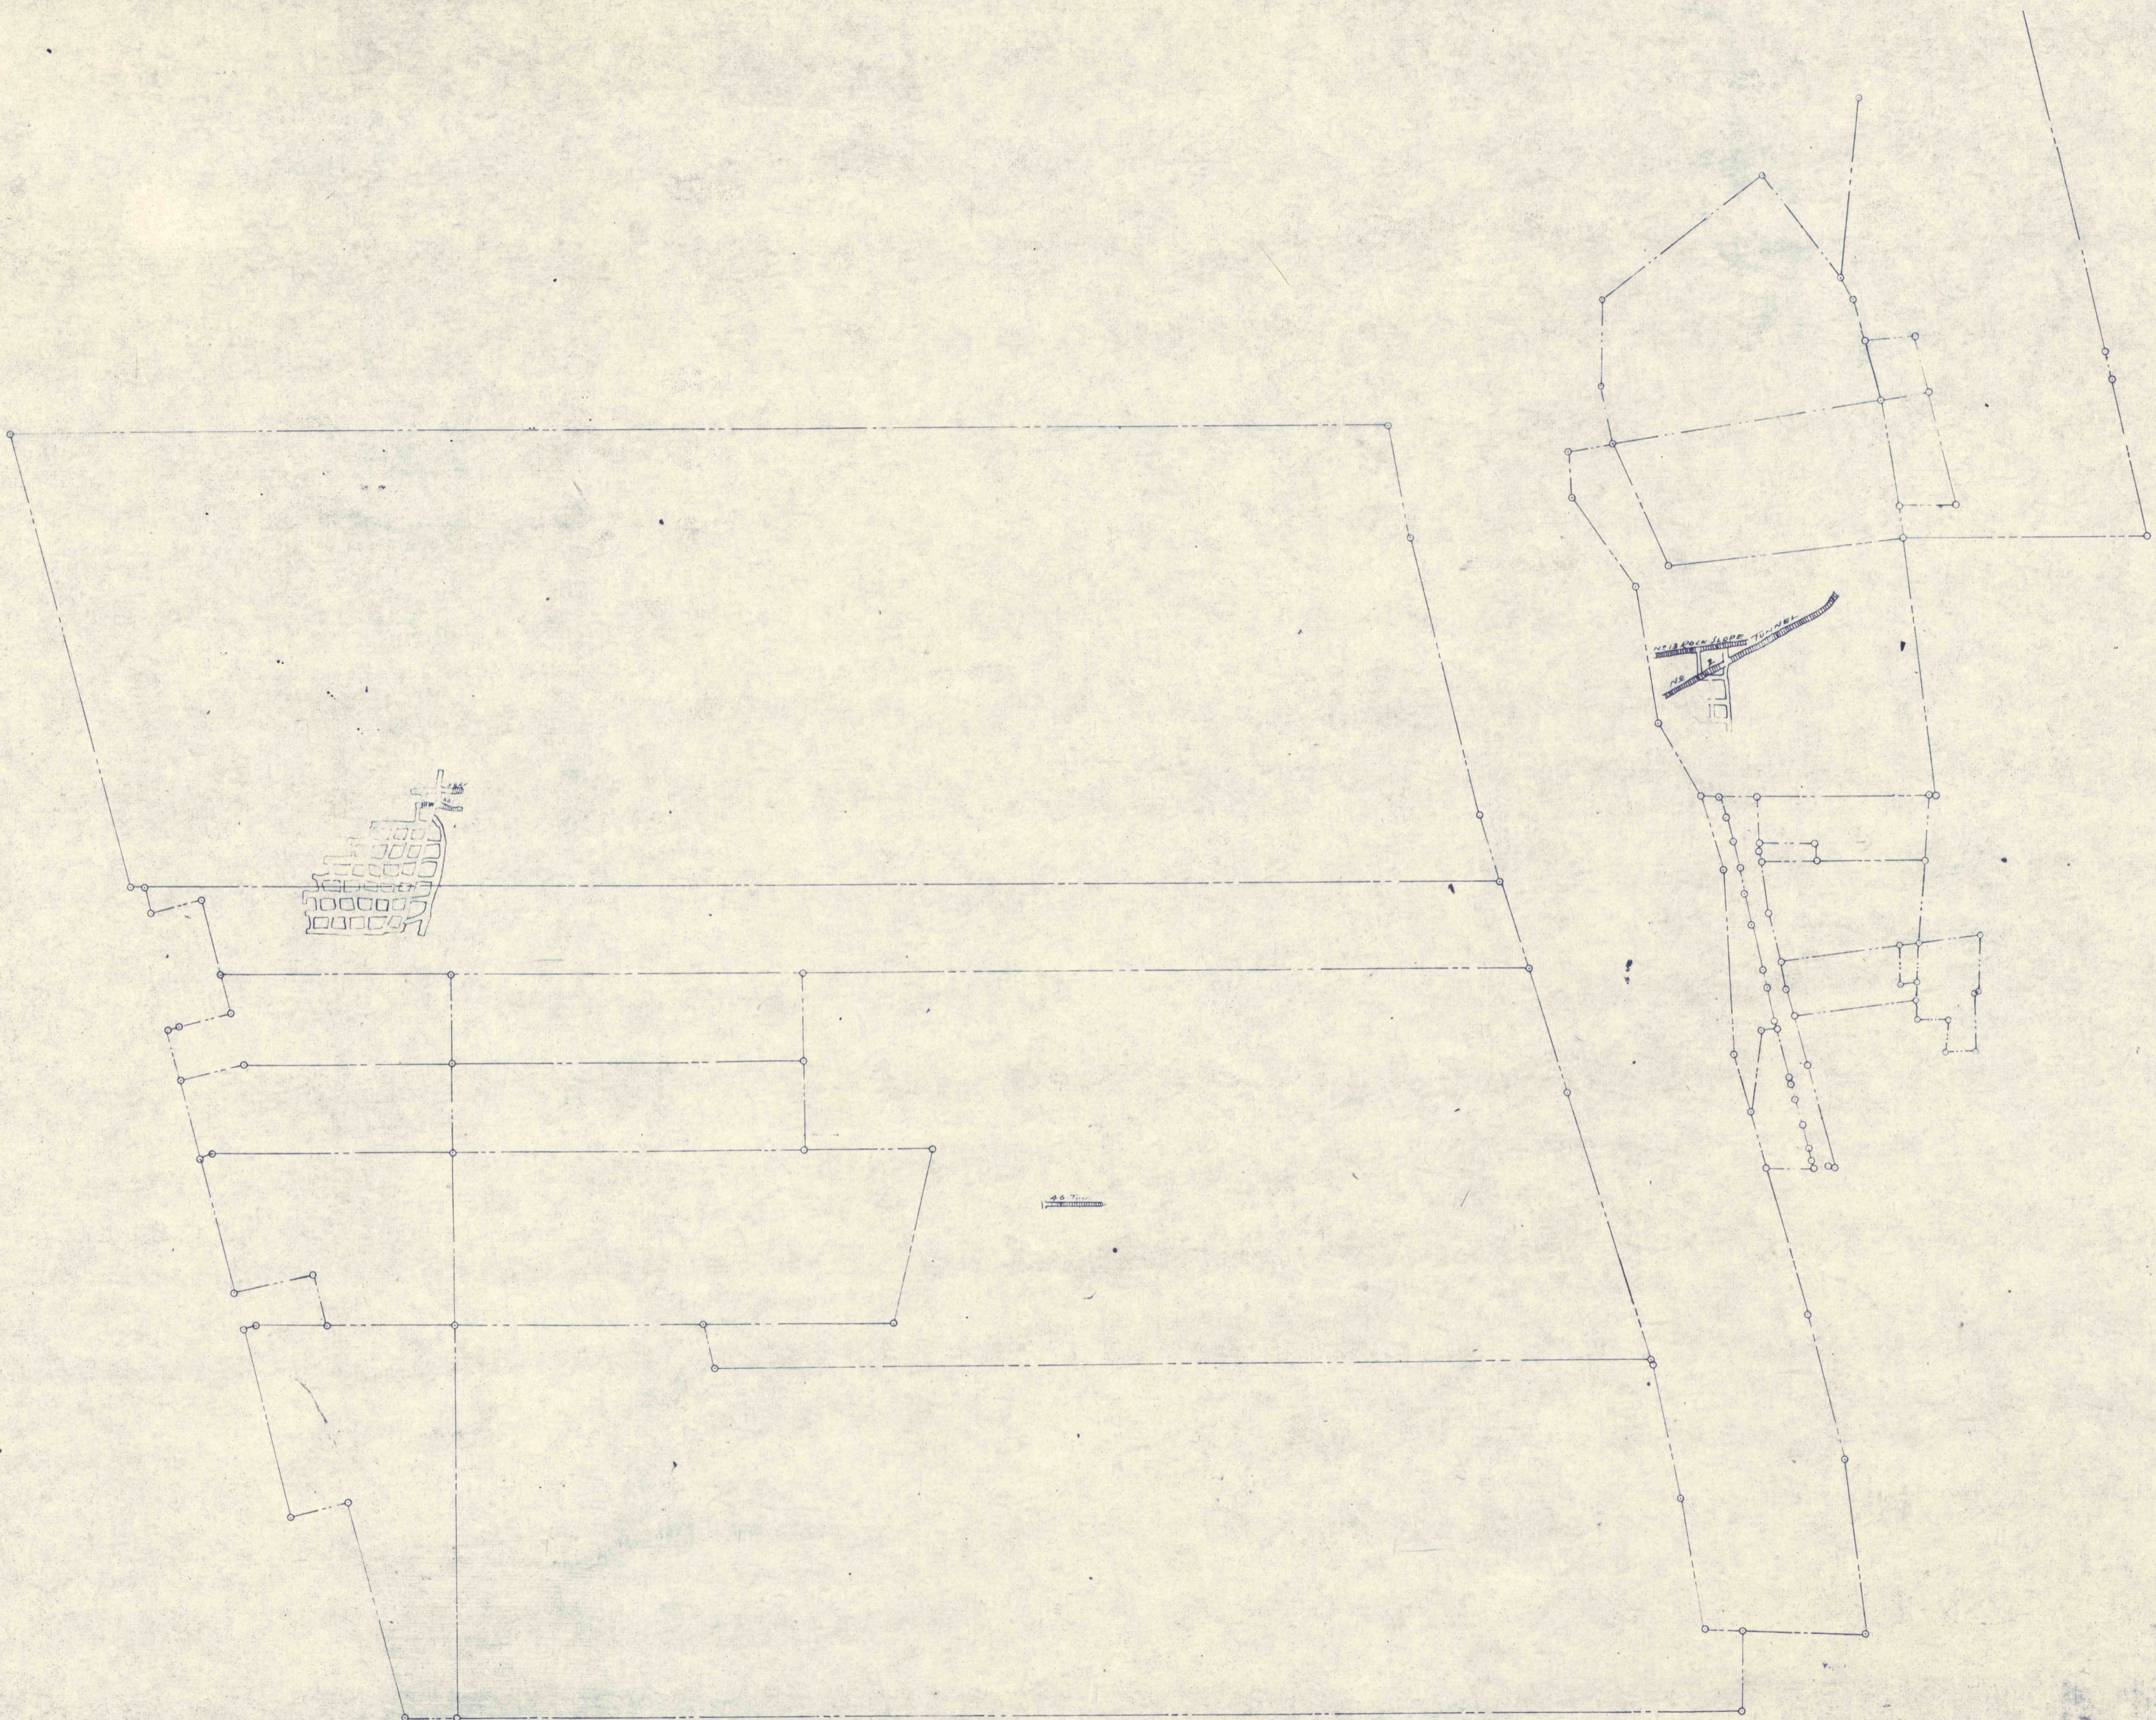

Darrigo
TOP ROSS

LAST POSTING FILLING ROBBING