


18+50

Sta. 19+00

Sta. 18+00

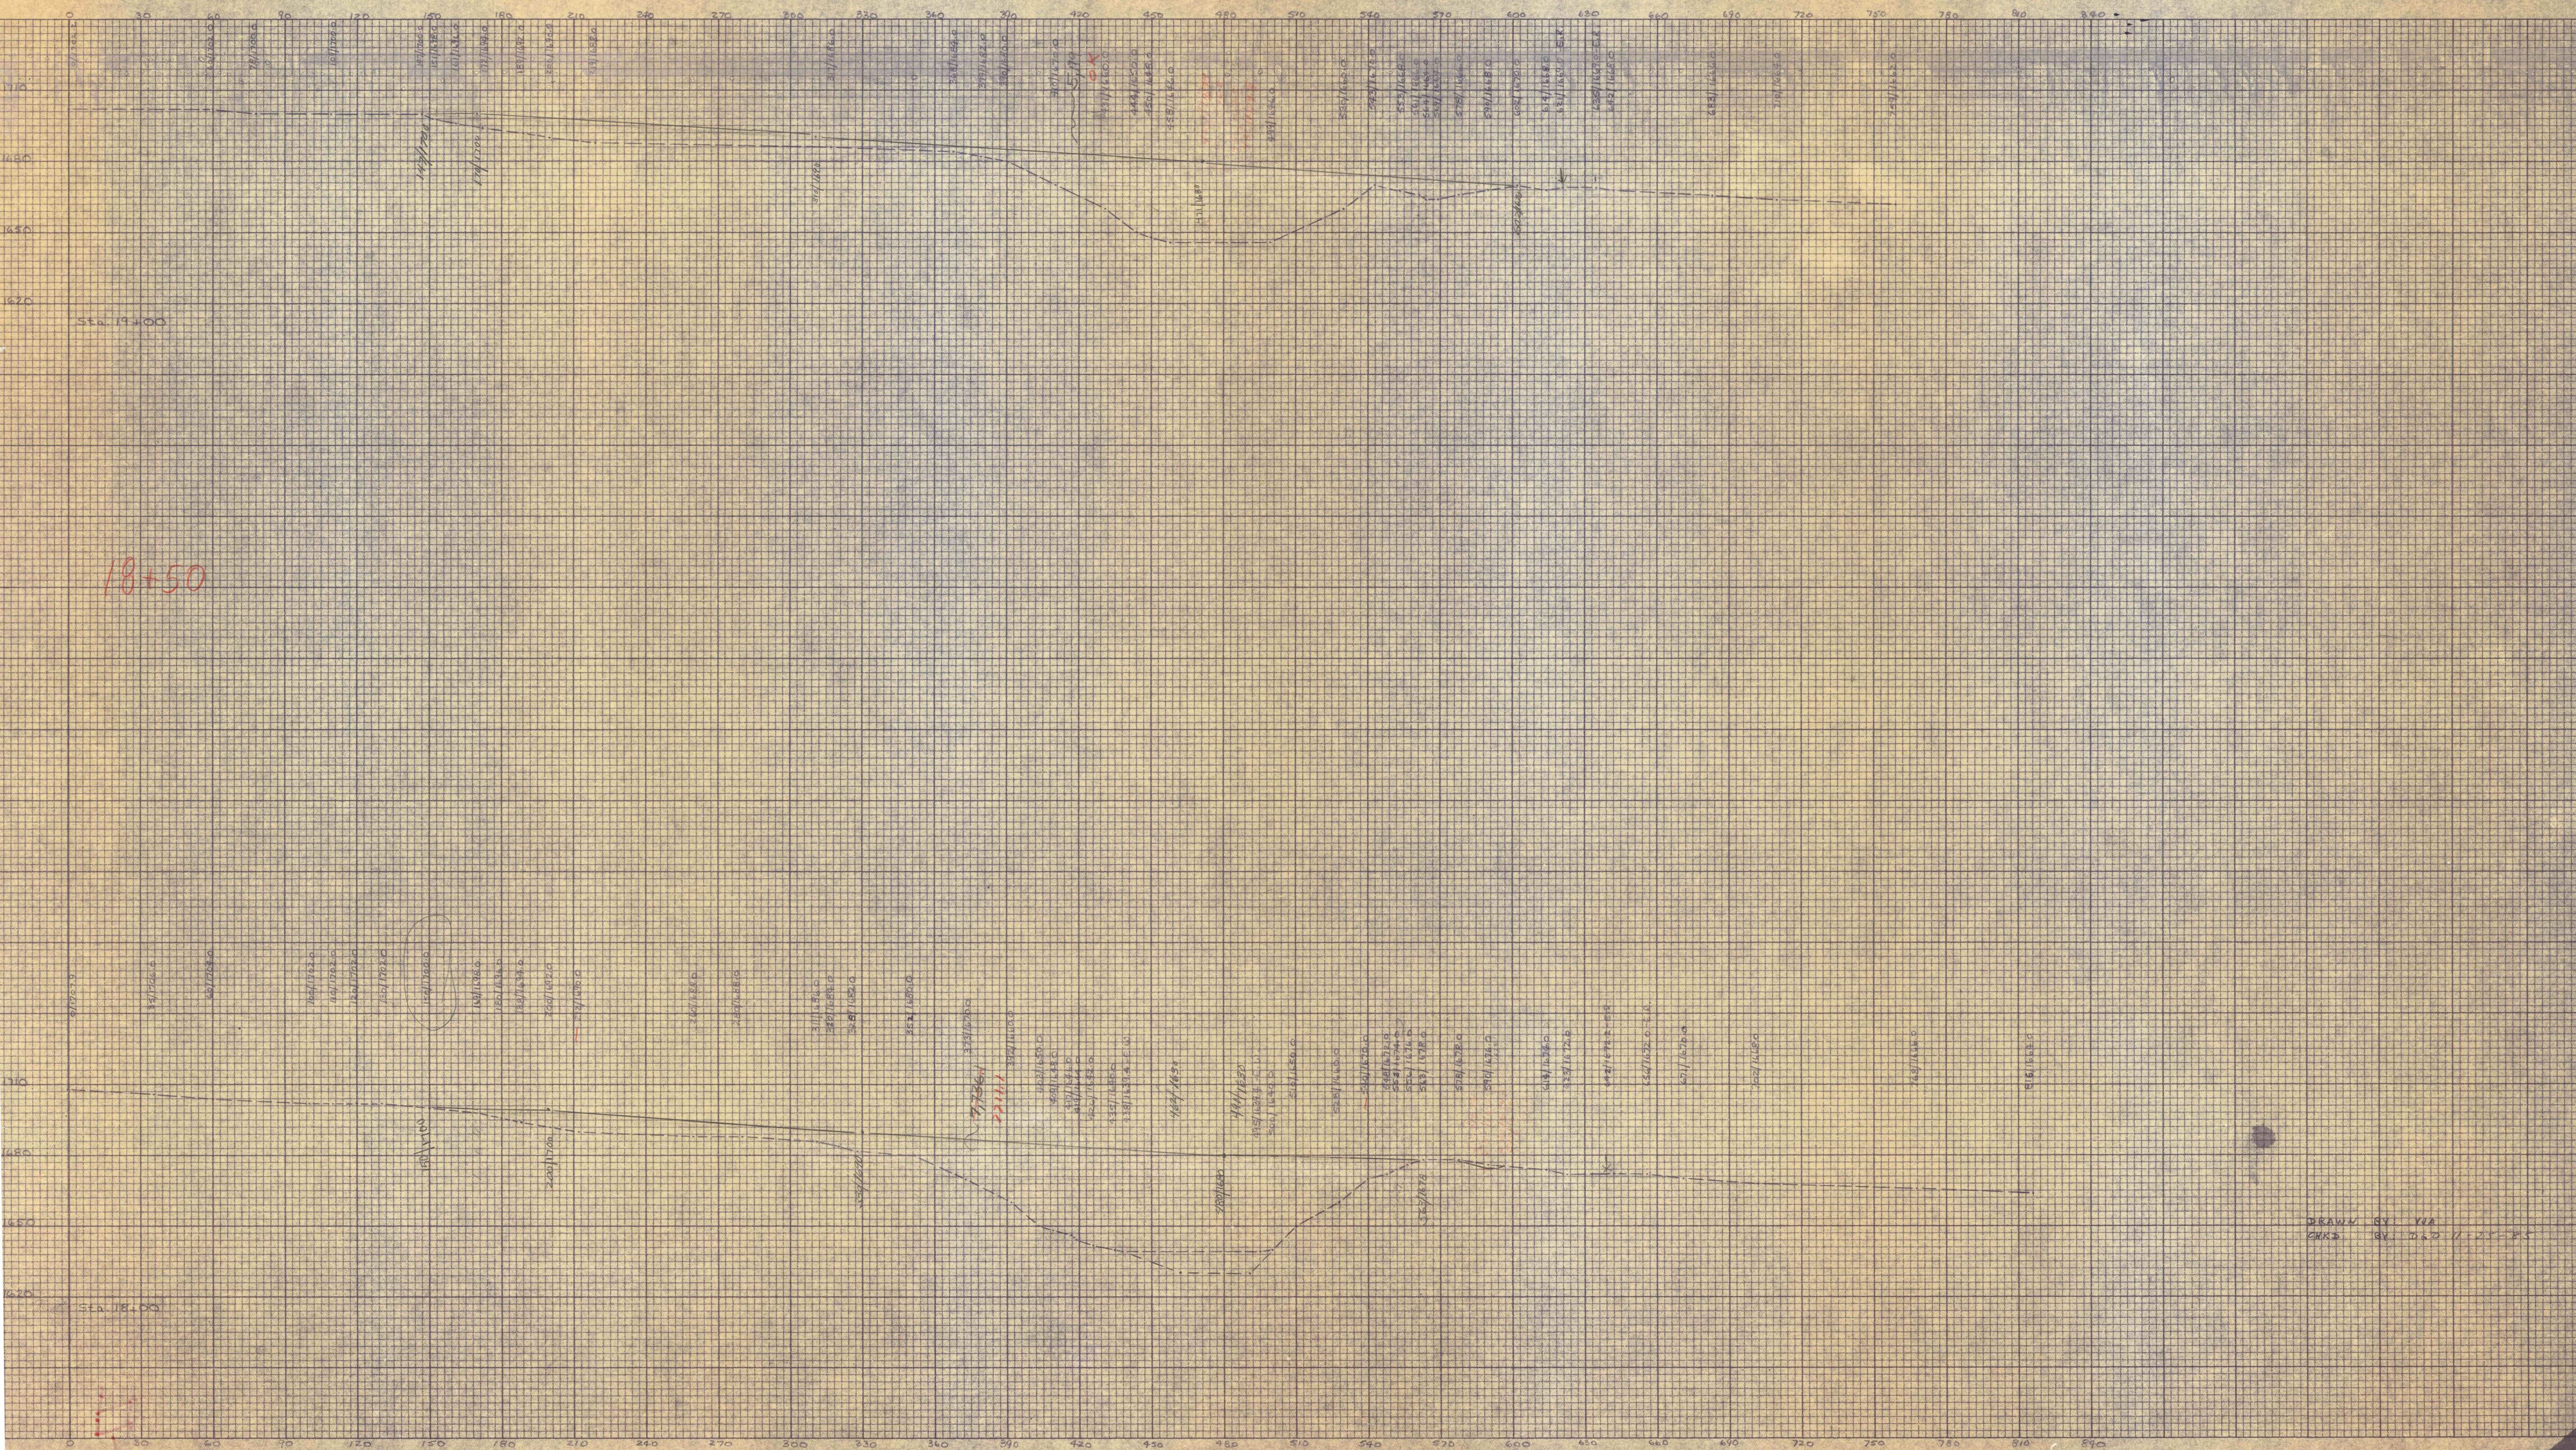

DRAWN BY: YJA
CHKD BY: WSD 11-25-25