

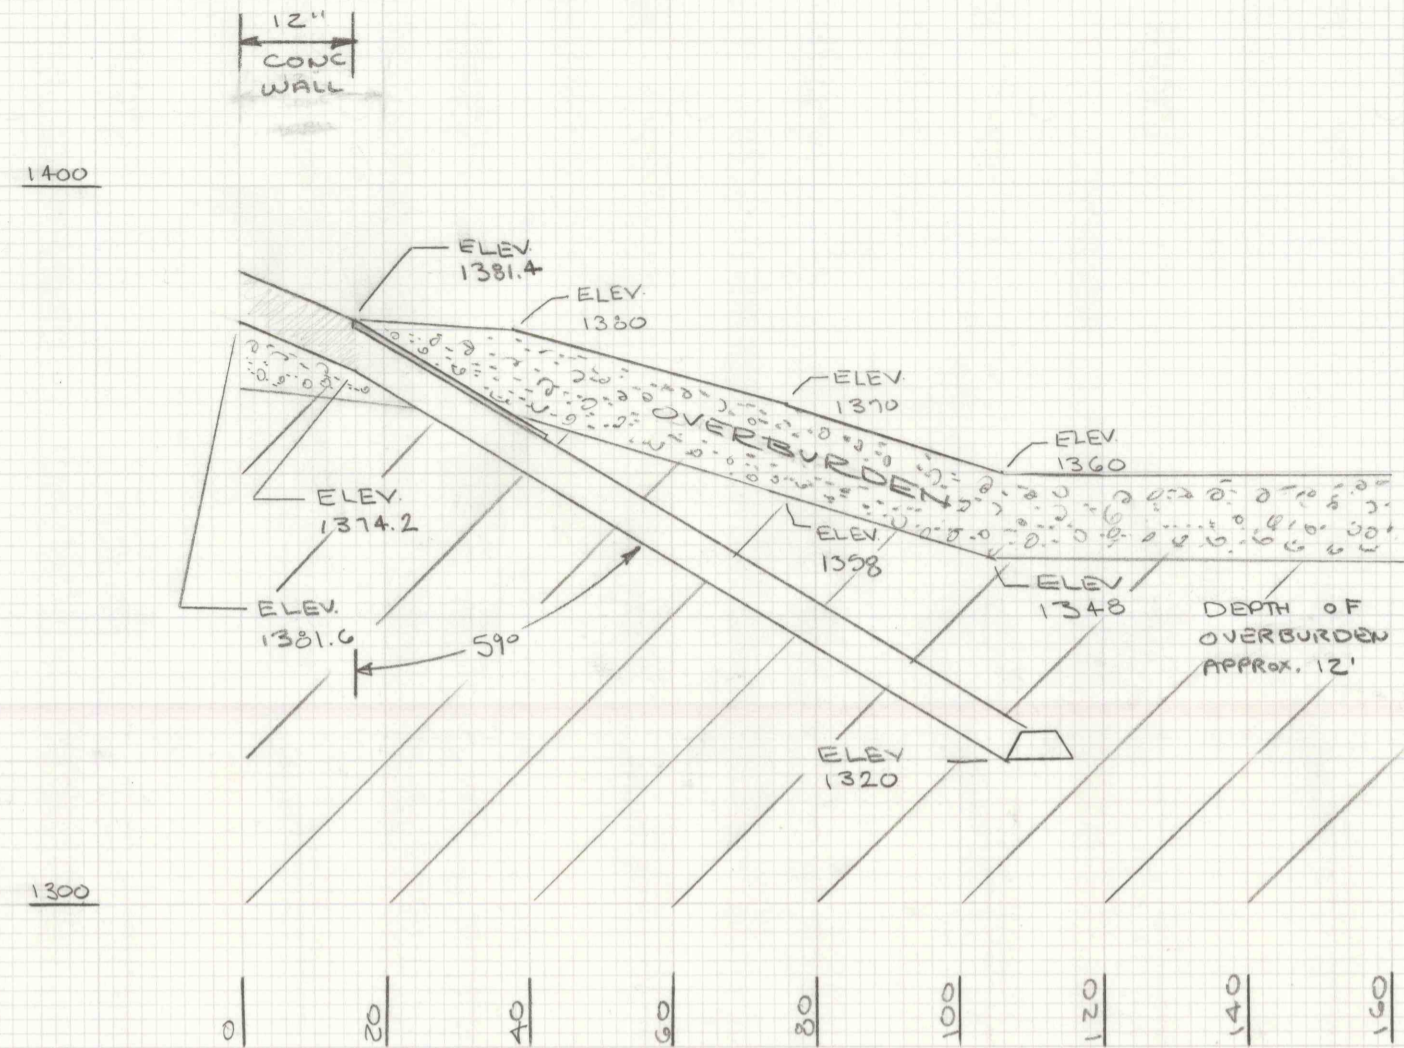



WATER LEVEL TUNNEL  
12' X 8' OPENING  
(LOOKING WEST)  
SCALE: 1" = 50'

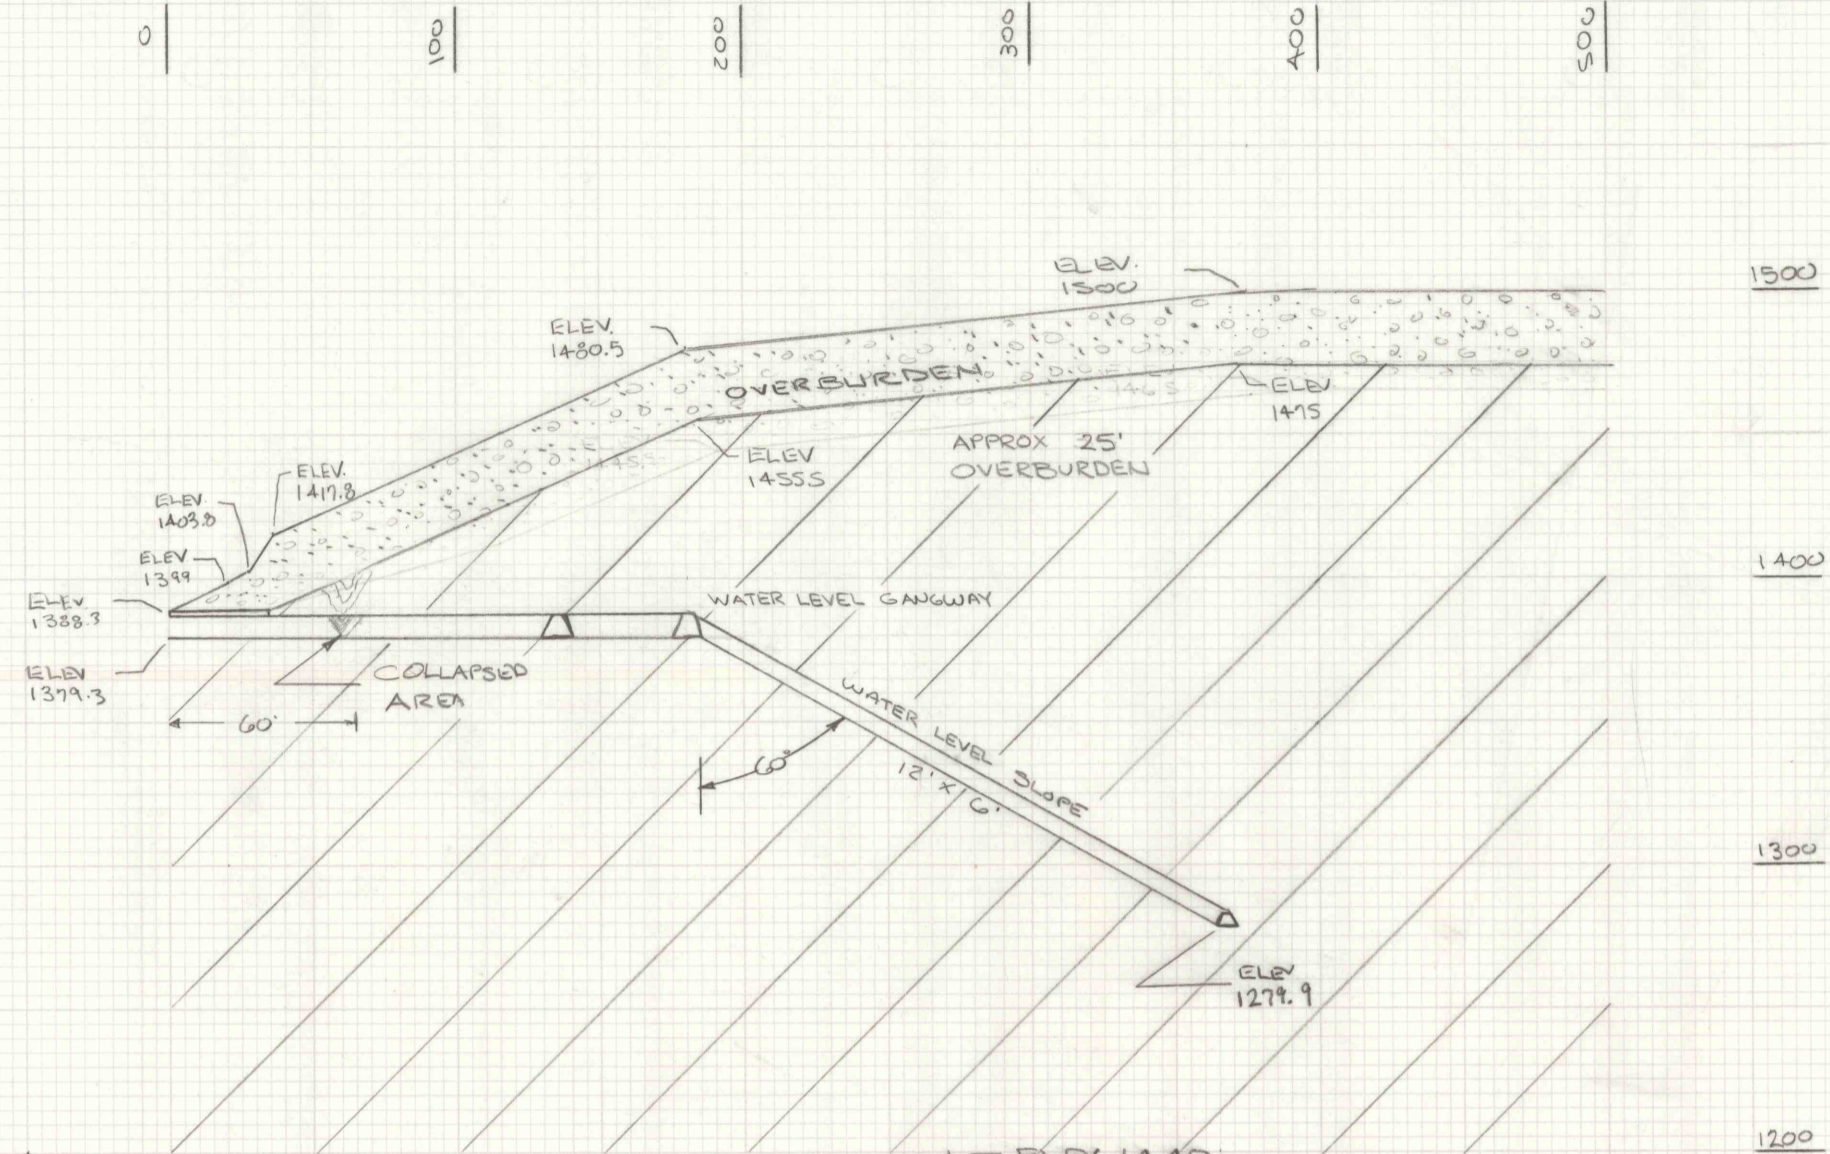

MULEWAY  
4' X 6' OPENING  
(LOOKING NORTH)  
SCALE: 1" = 20'

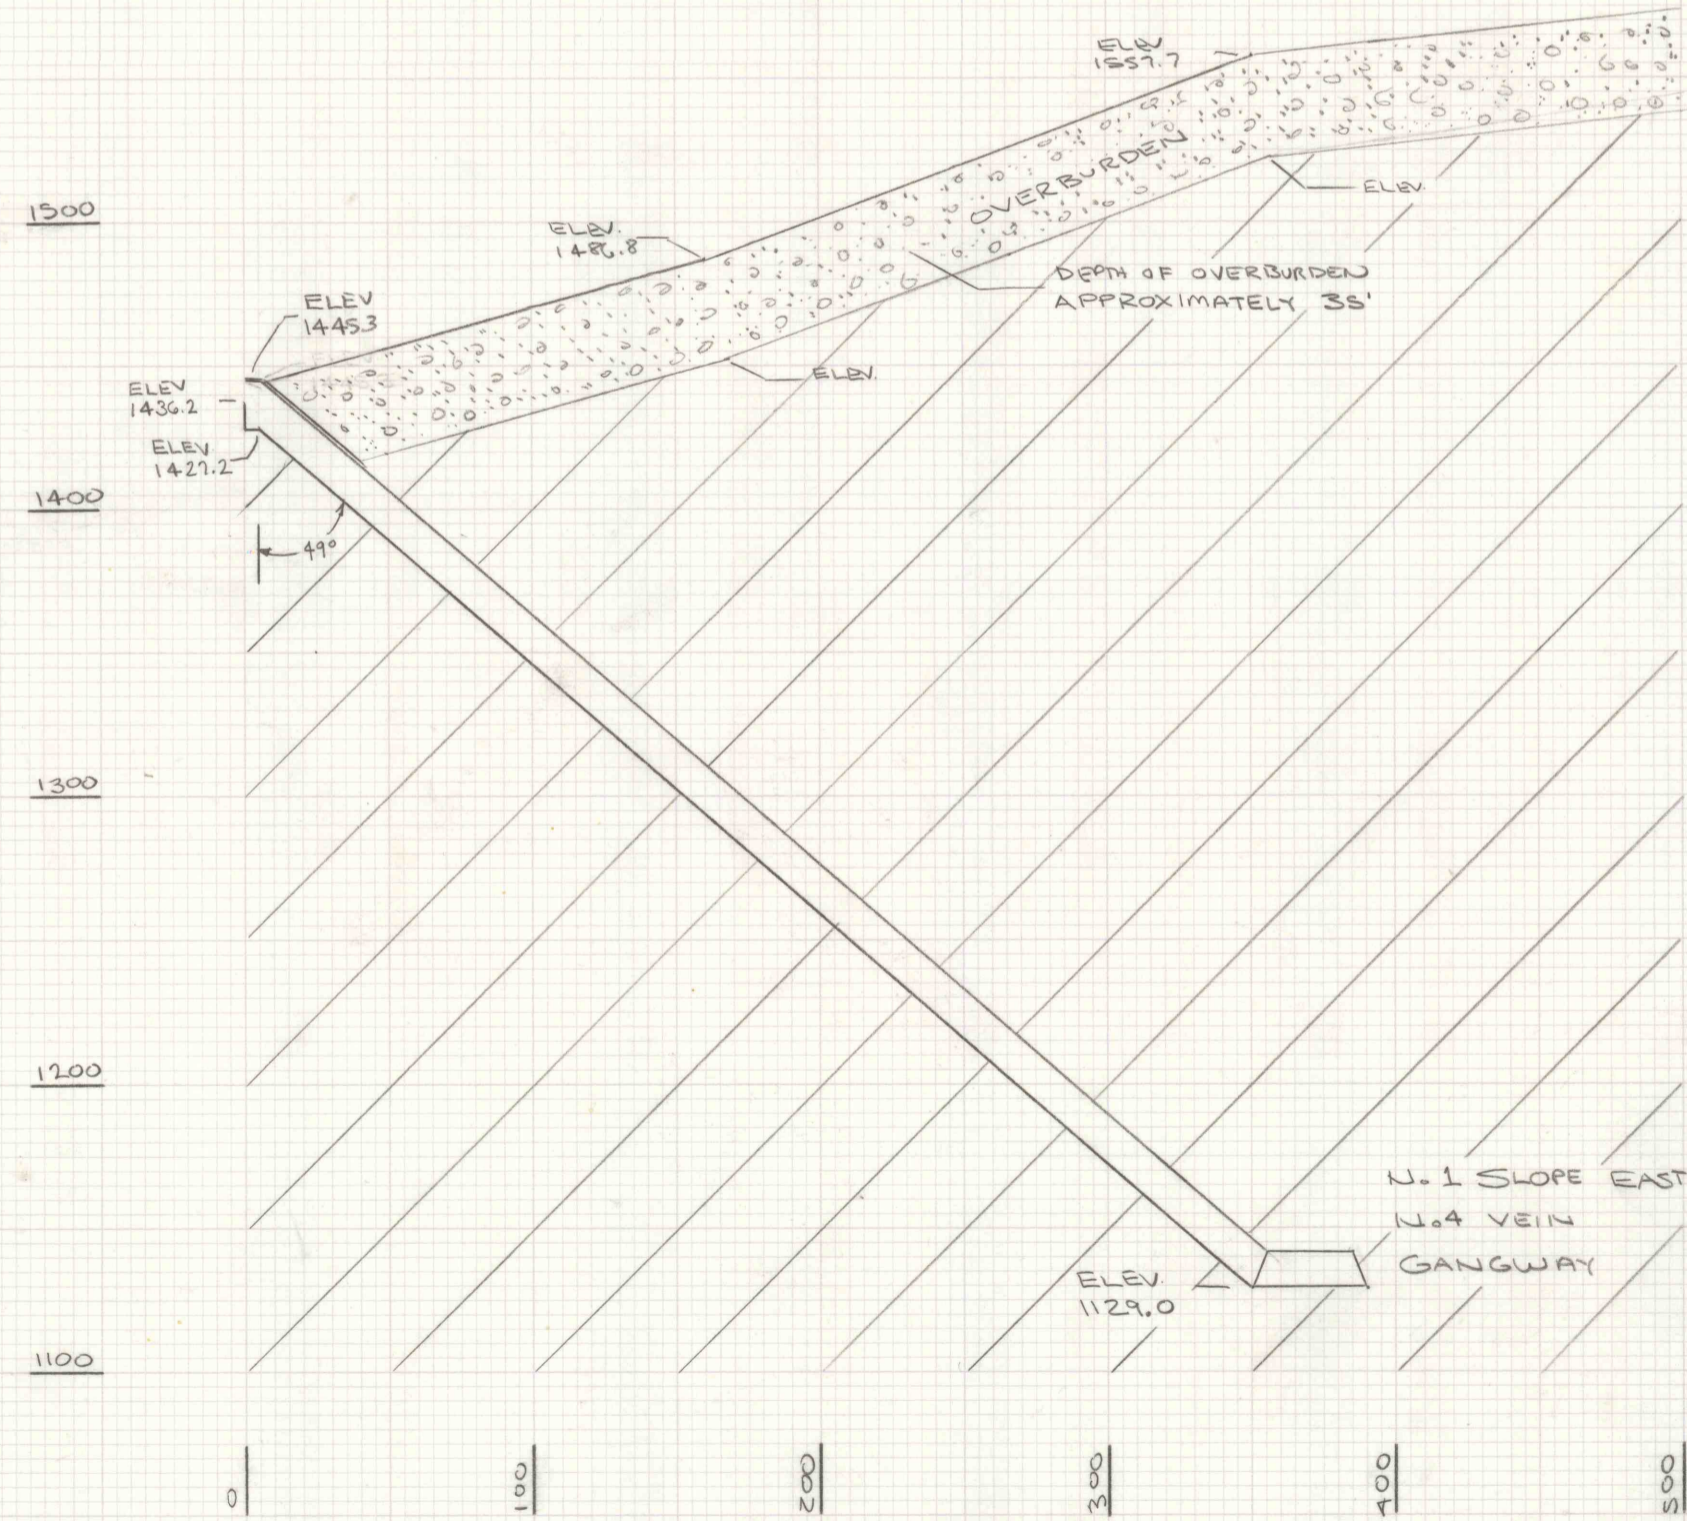

AIRHOLE  
13' X 13' OPENING  
(LOOKING WEST)  
SCALE: 1" = 50'

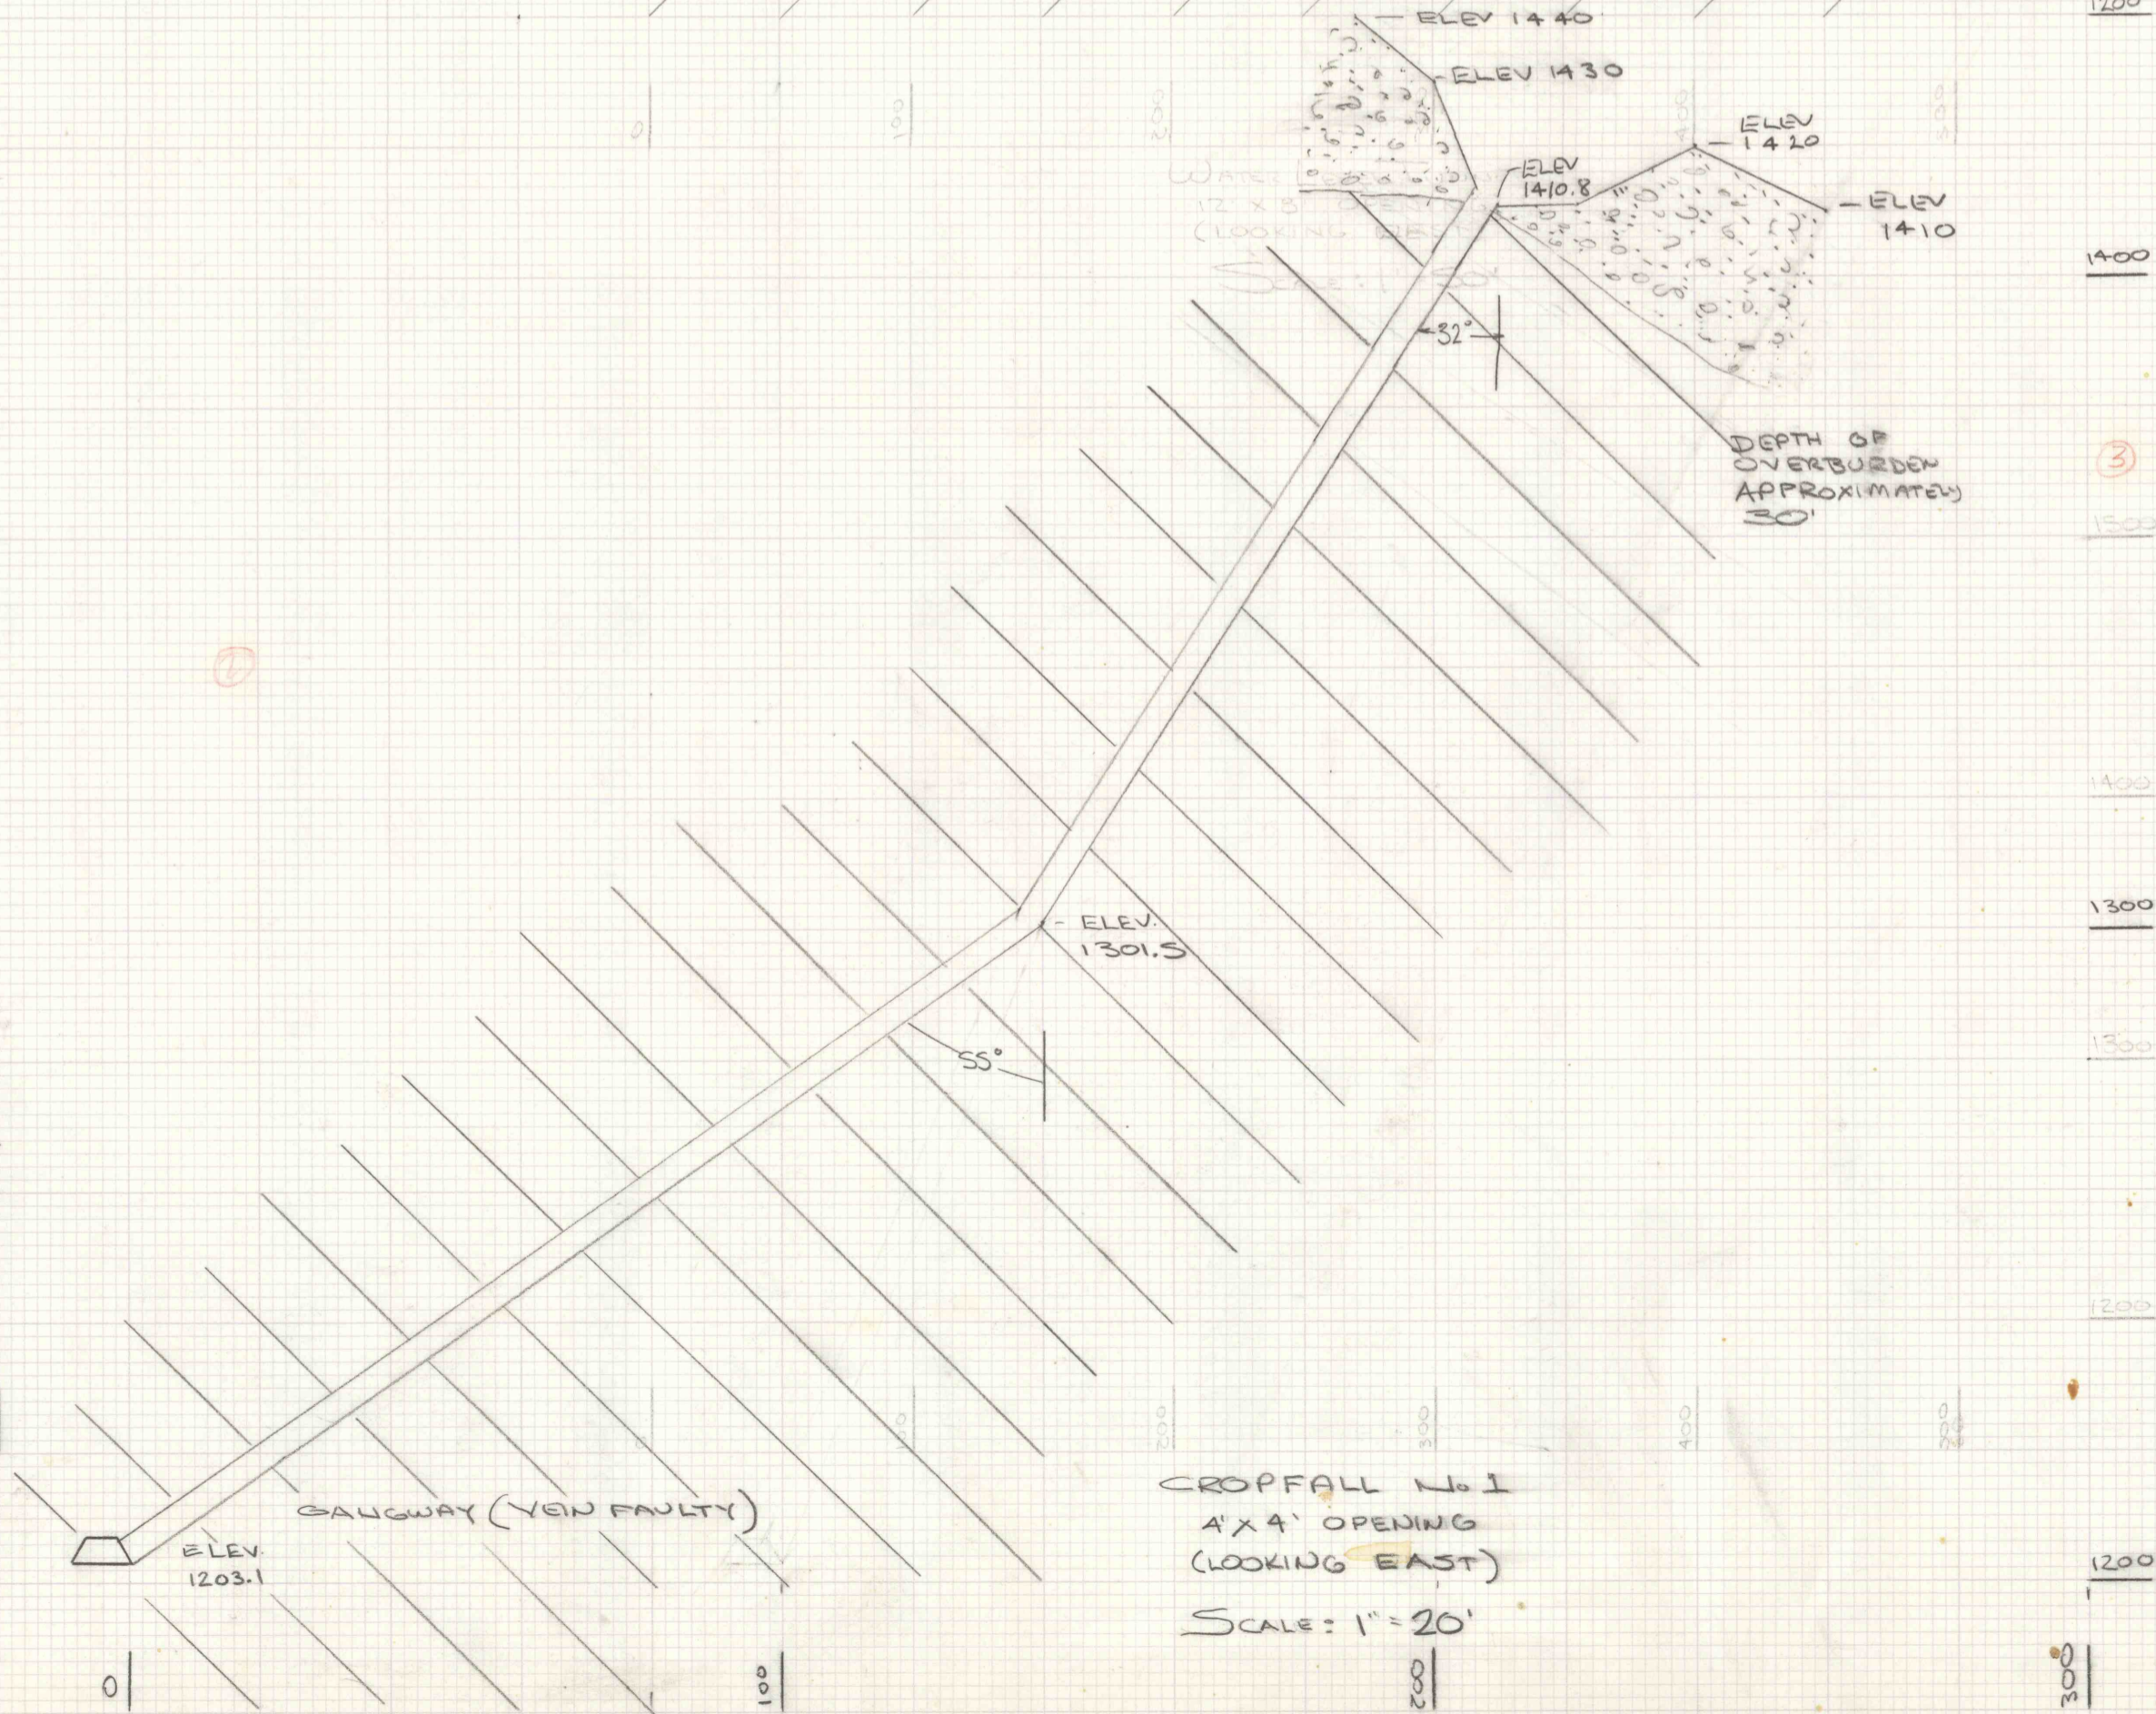

CROPFALL No 1  
4' X 4' OPENING  
(LOOKING EAST)  
SCALE: 1" = 20'