


PROFILE ALONG CROPPAL No 1

SCALE: VERT 1"=10'
HORIZ 1"=10'

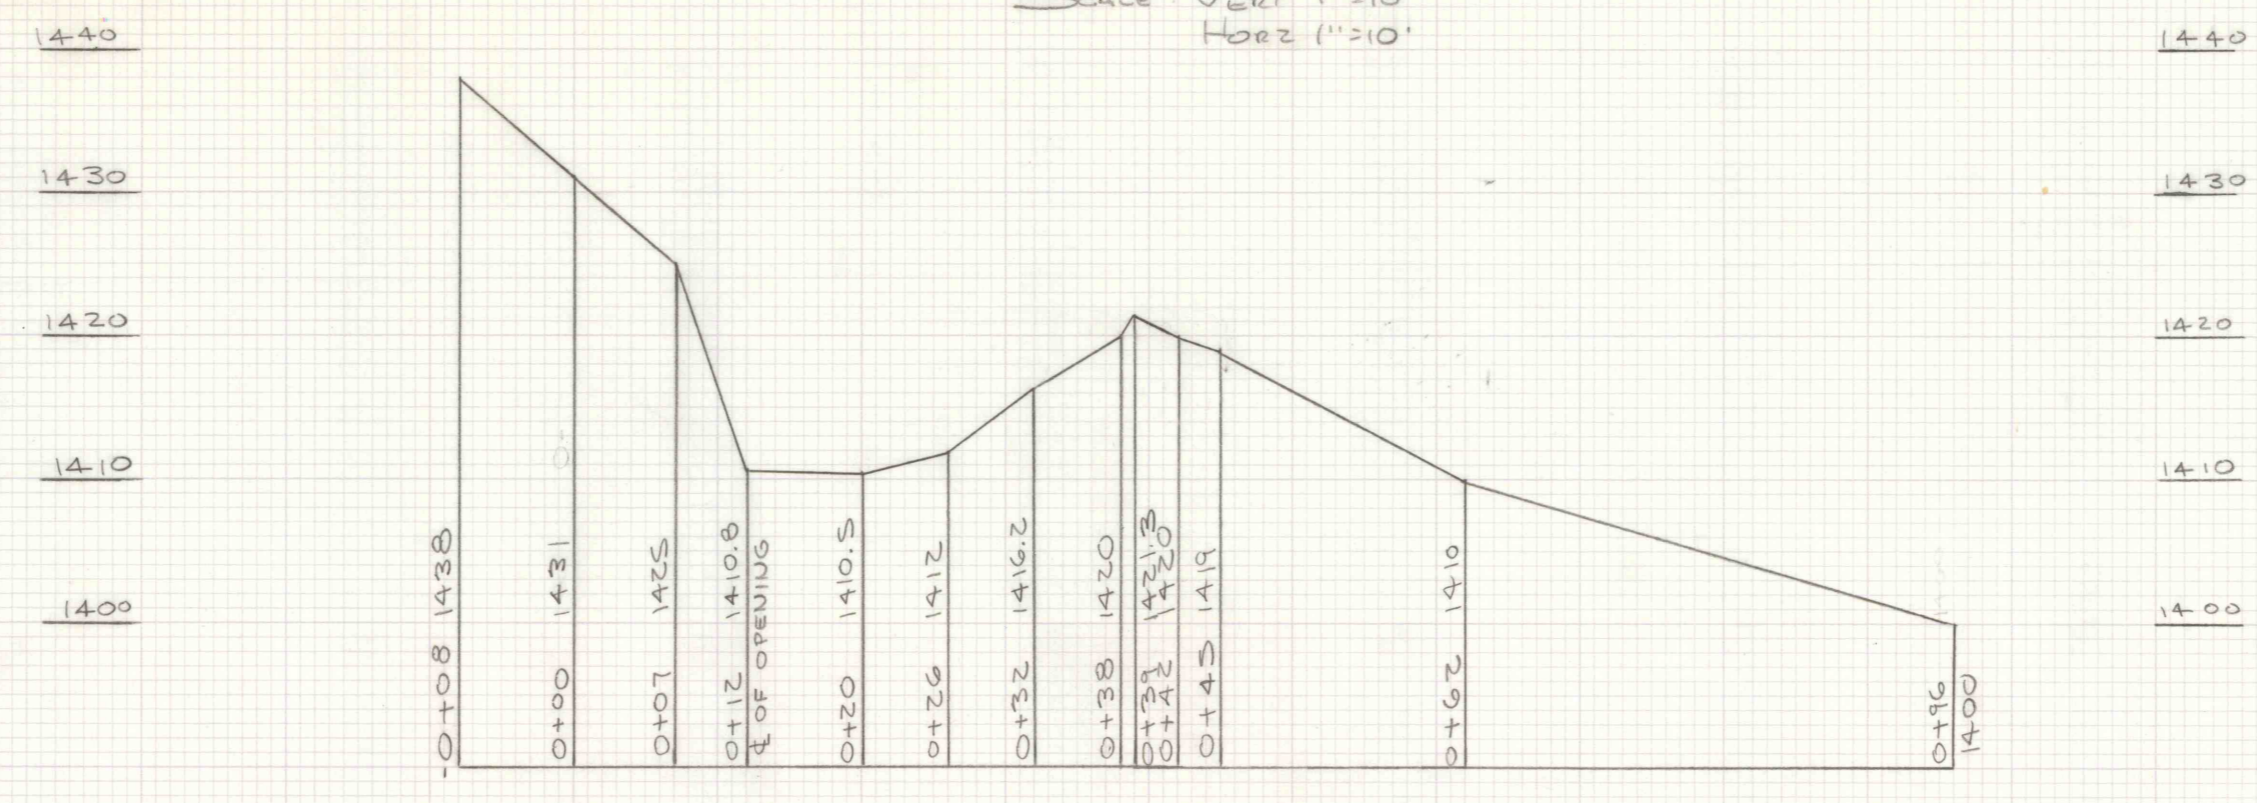

CROSS SECTIONS THROUGH
CROPPAL No 1
SCALE: VERT 1"=10'
HORIZ 1"=10'

