


③  
COMMONWEALTH  
OF  
PENNSYLVANIA

②  
GMP  
LAND CO

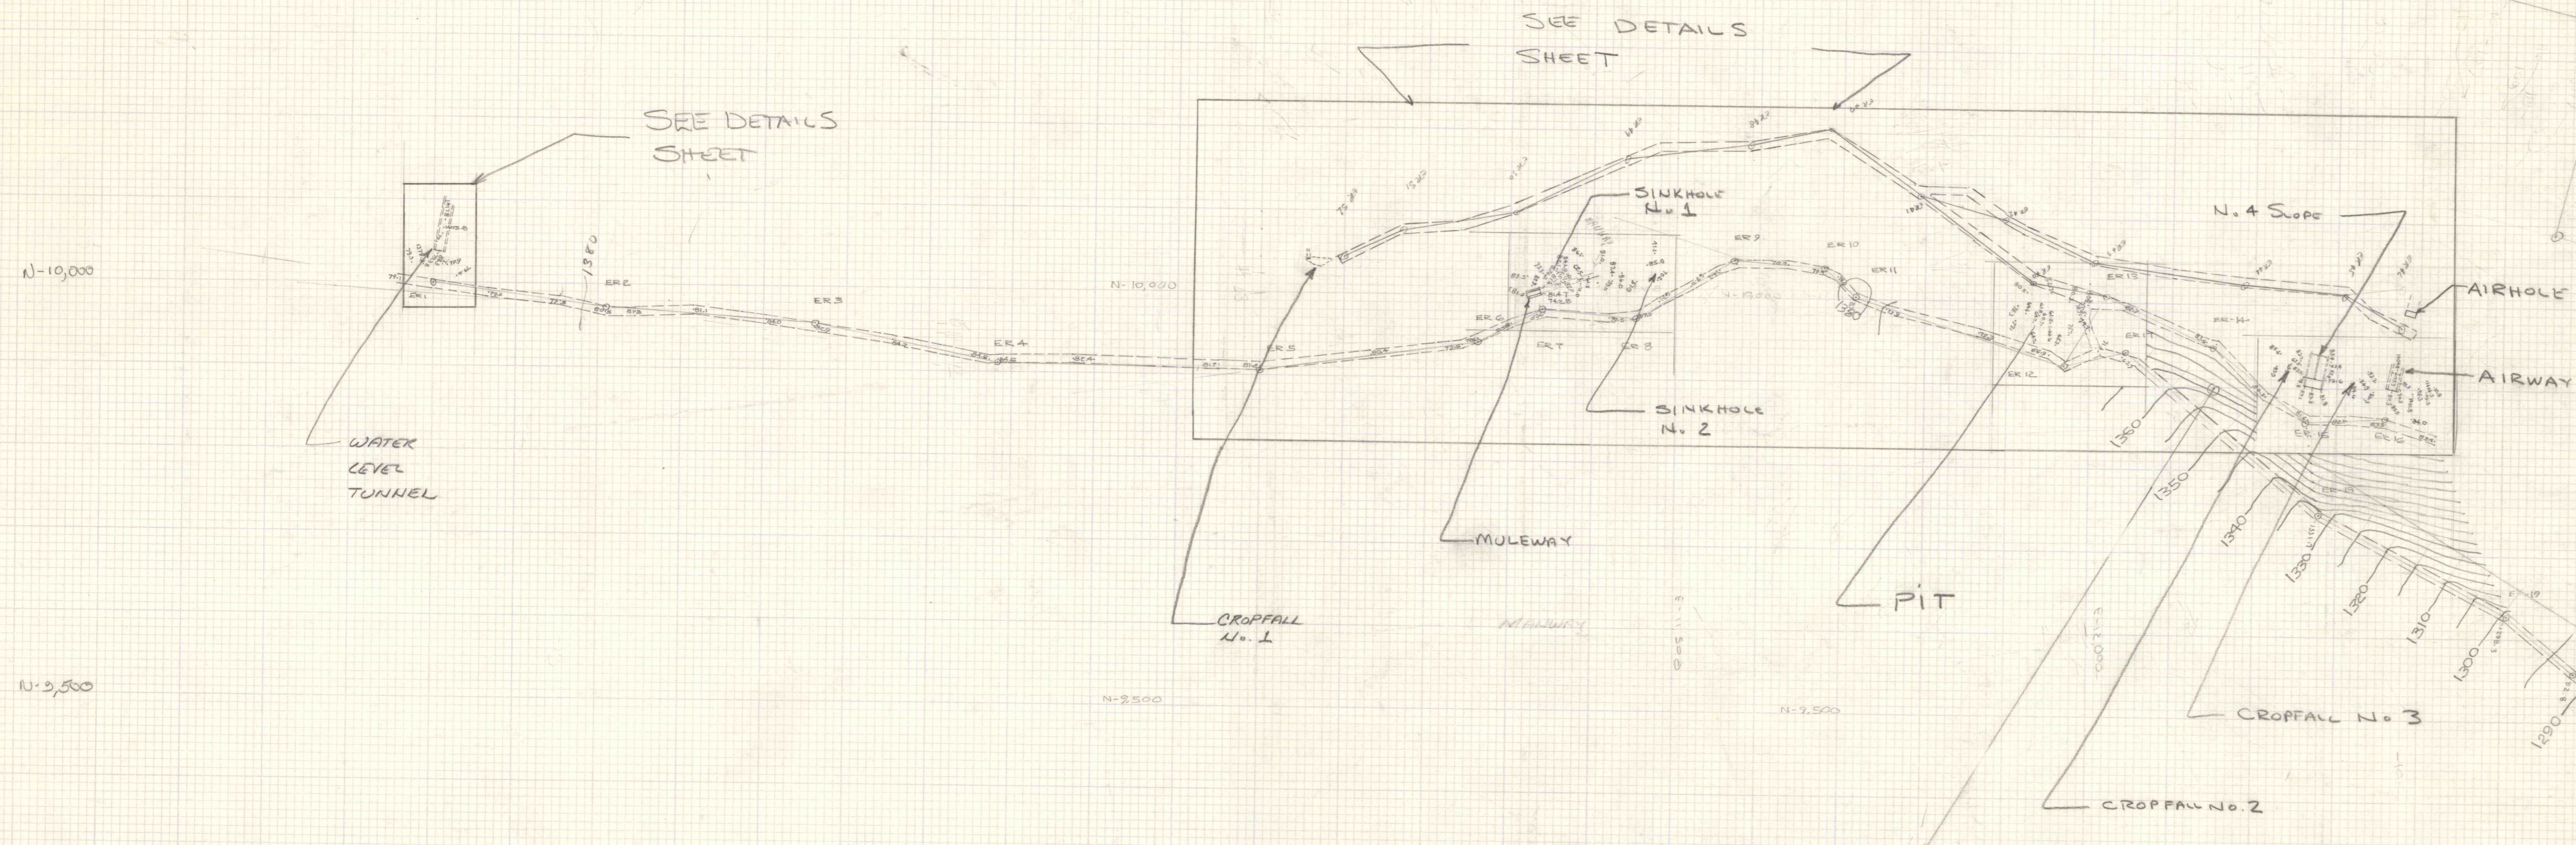

③  
COMMONWEALTH  
OF  
PENNSYLVANIA

②  
GMP  
LAND CO

②  
GMP  
LAND CO

②  
GMP  
LAND CO

