


9-2
9-1
TAYLOR BORO SECTION
NEW CO. VEIN
SLIDE - N96-1

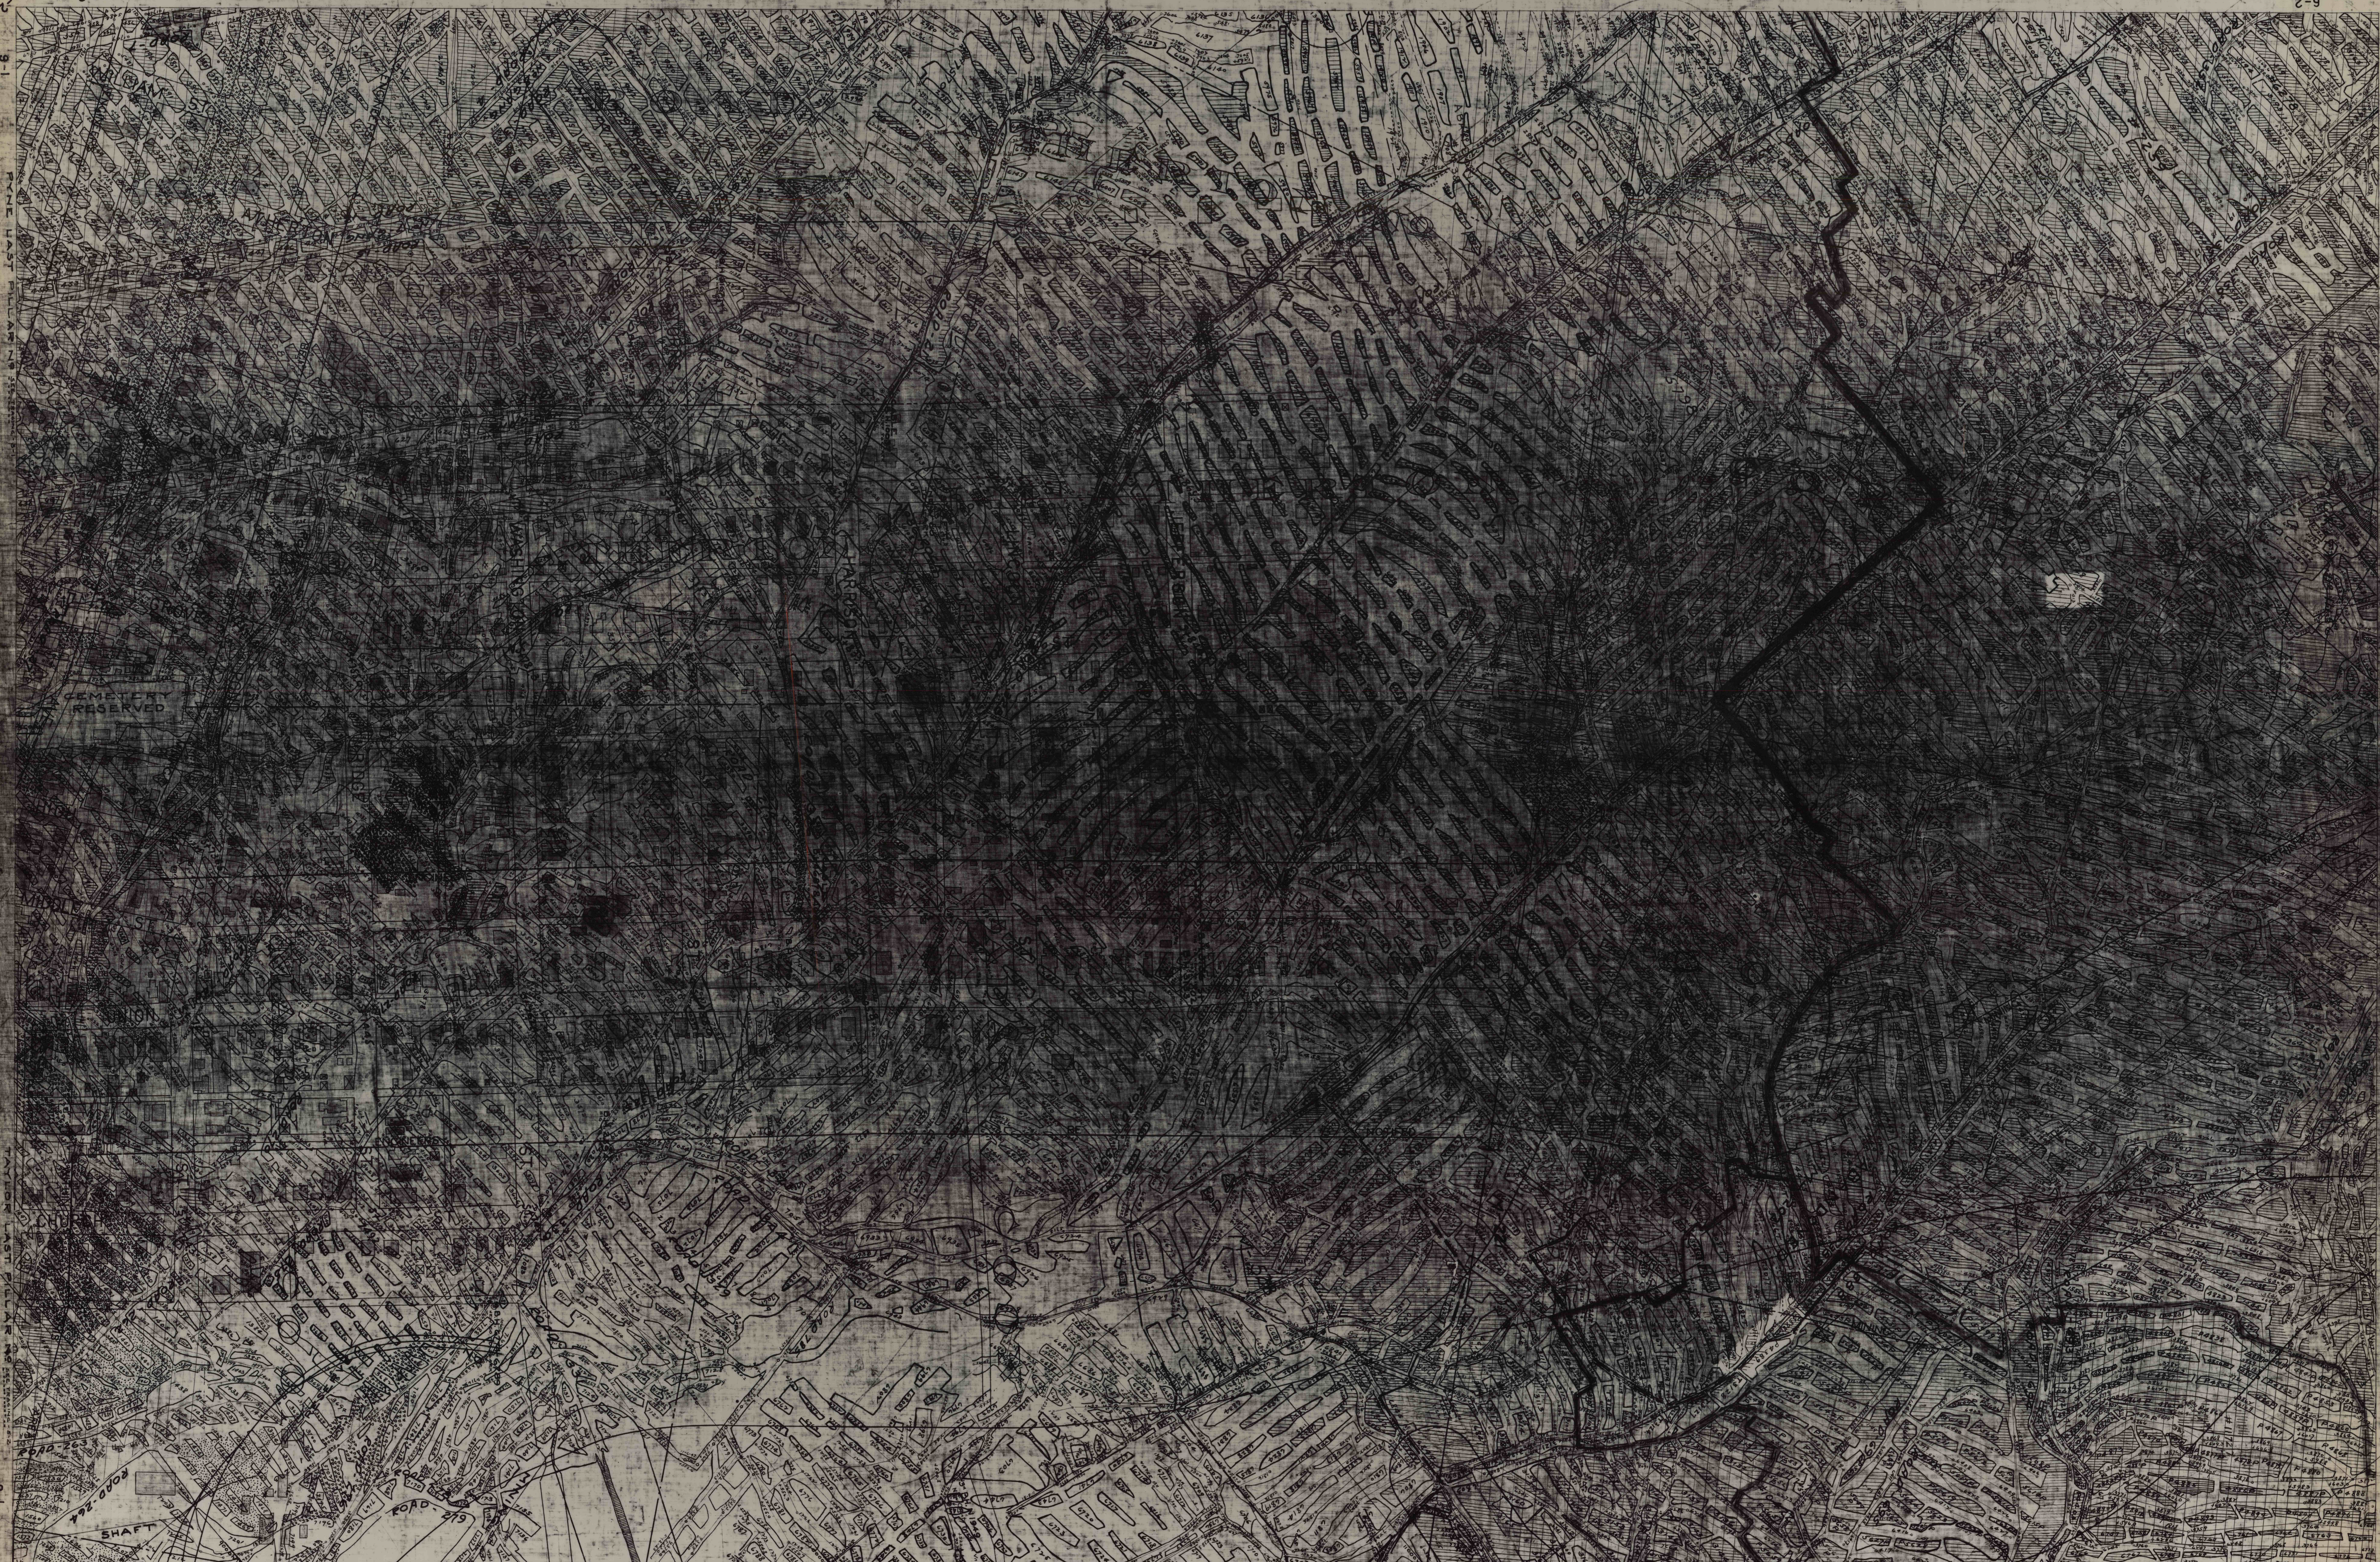

9-2
9-1
TAYLOR BORO SECTION
NEW CO. VEIN
SLIDE - N96-1

8-2
8-1

8-2
8-1