

LUDWIG VON STORCH

C E M E T E R Y

L. I. & C. CO.

WATSON

SLOAN

AMHURST

CORNELL

ST. ANN

JOSEPH

GRIFFIN

BRYN MAWR

DARTMOUTH


LOCUST

HENRY KNAPP

ELM

SLOAN AIR SHAFT  
AIR SHAFT  
TO STOOT  
+ 864.5  
SLOAN SHAFT  
+ 839.4 TOP CONC.

BH 5153  
12" CABLE  
SURF. TO CLARK  
BH 5747  
18" CABLE  
SURF. TO CLARK  
SLOAN WATER SHAFT  
SURF. ELEV. +826.6

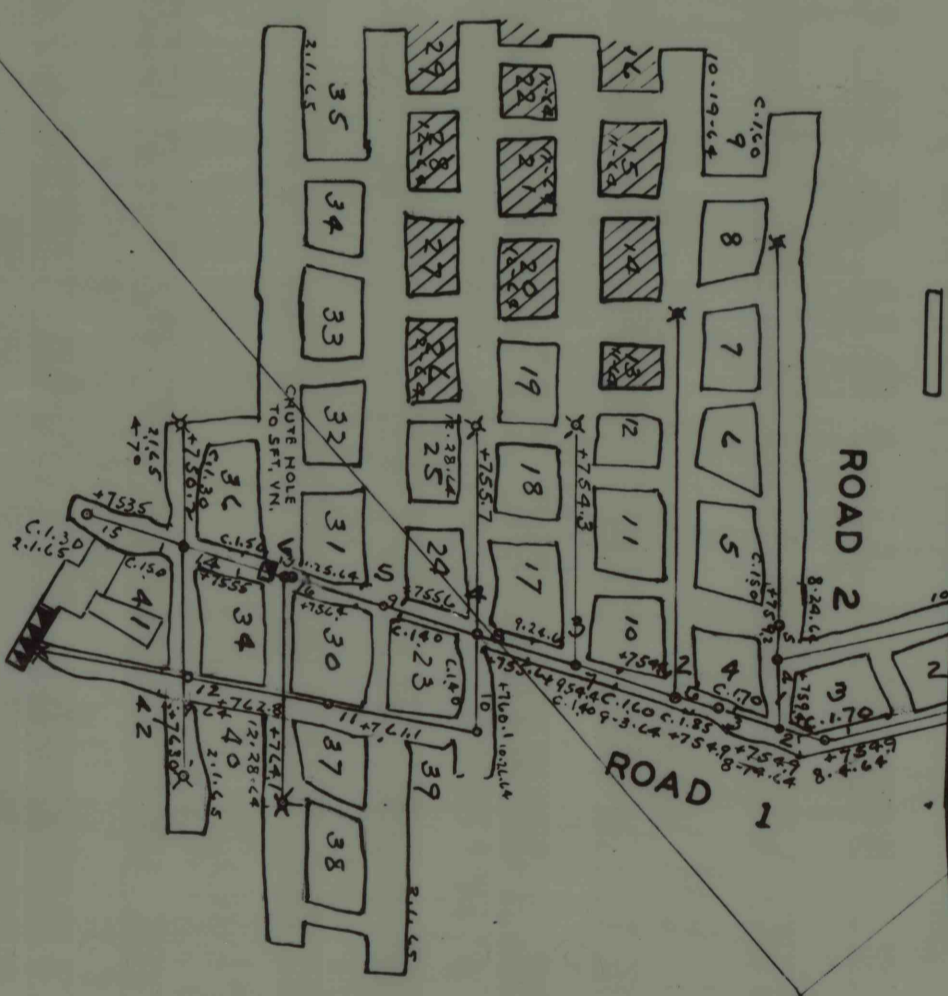

ROAD 1  
ROAD 2

No. 133 SLOPE

No. 192 DRIFT

WATER SHAFT SECTION  
TOP 4 FOOT VEIN

