


HYDE PARK FOUR FOOT "TOP"

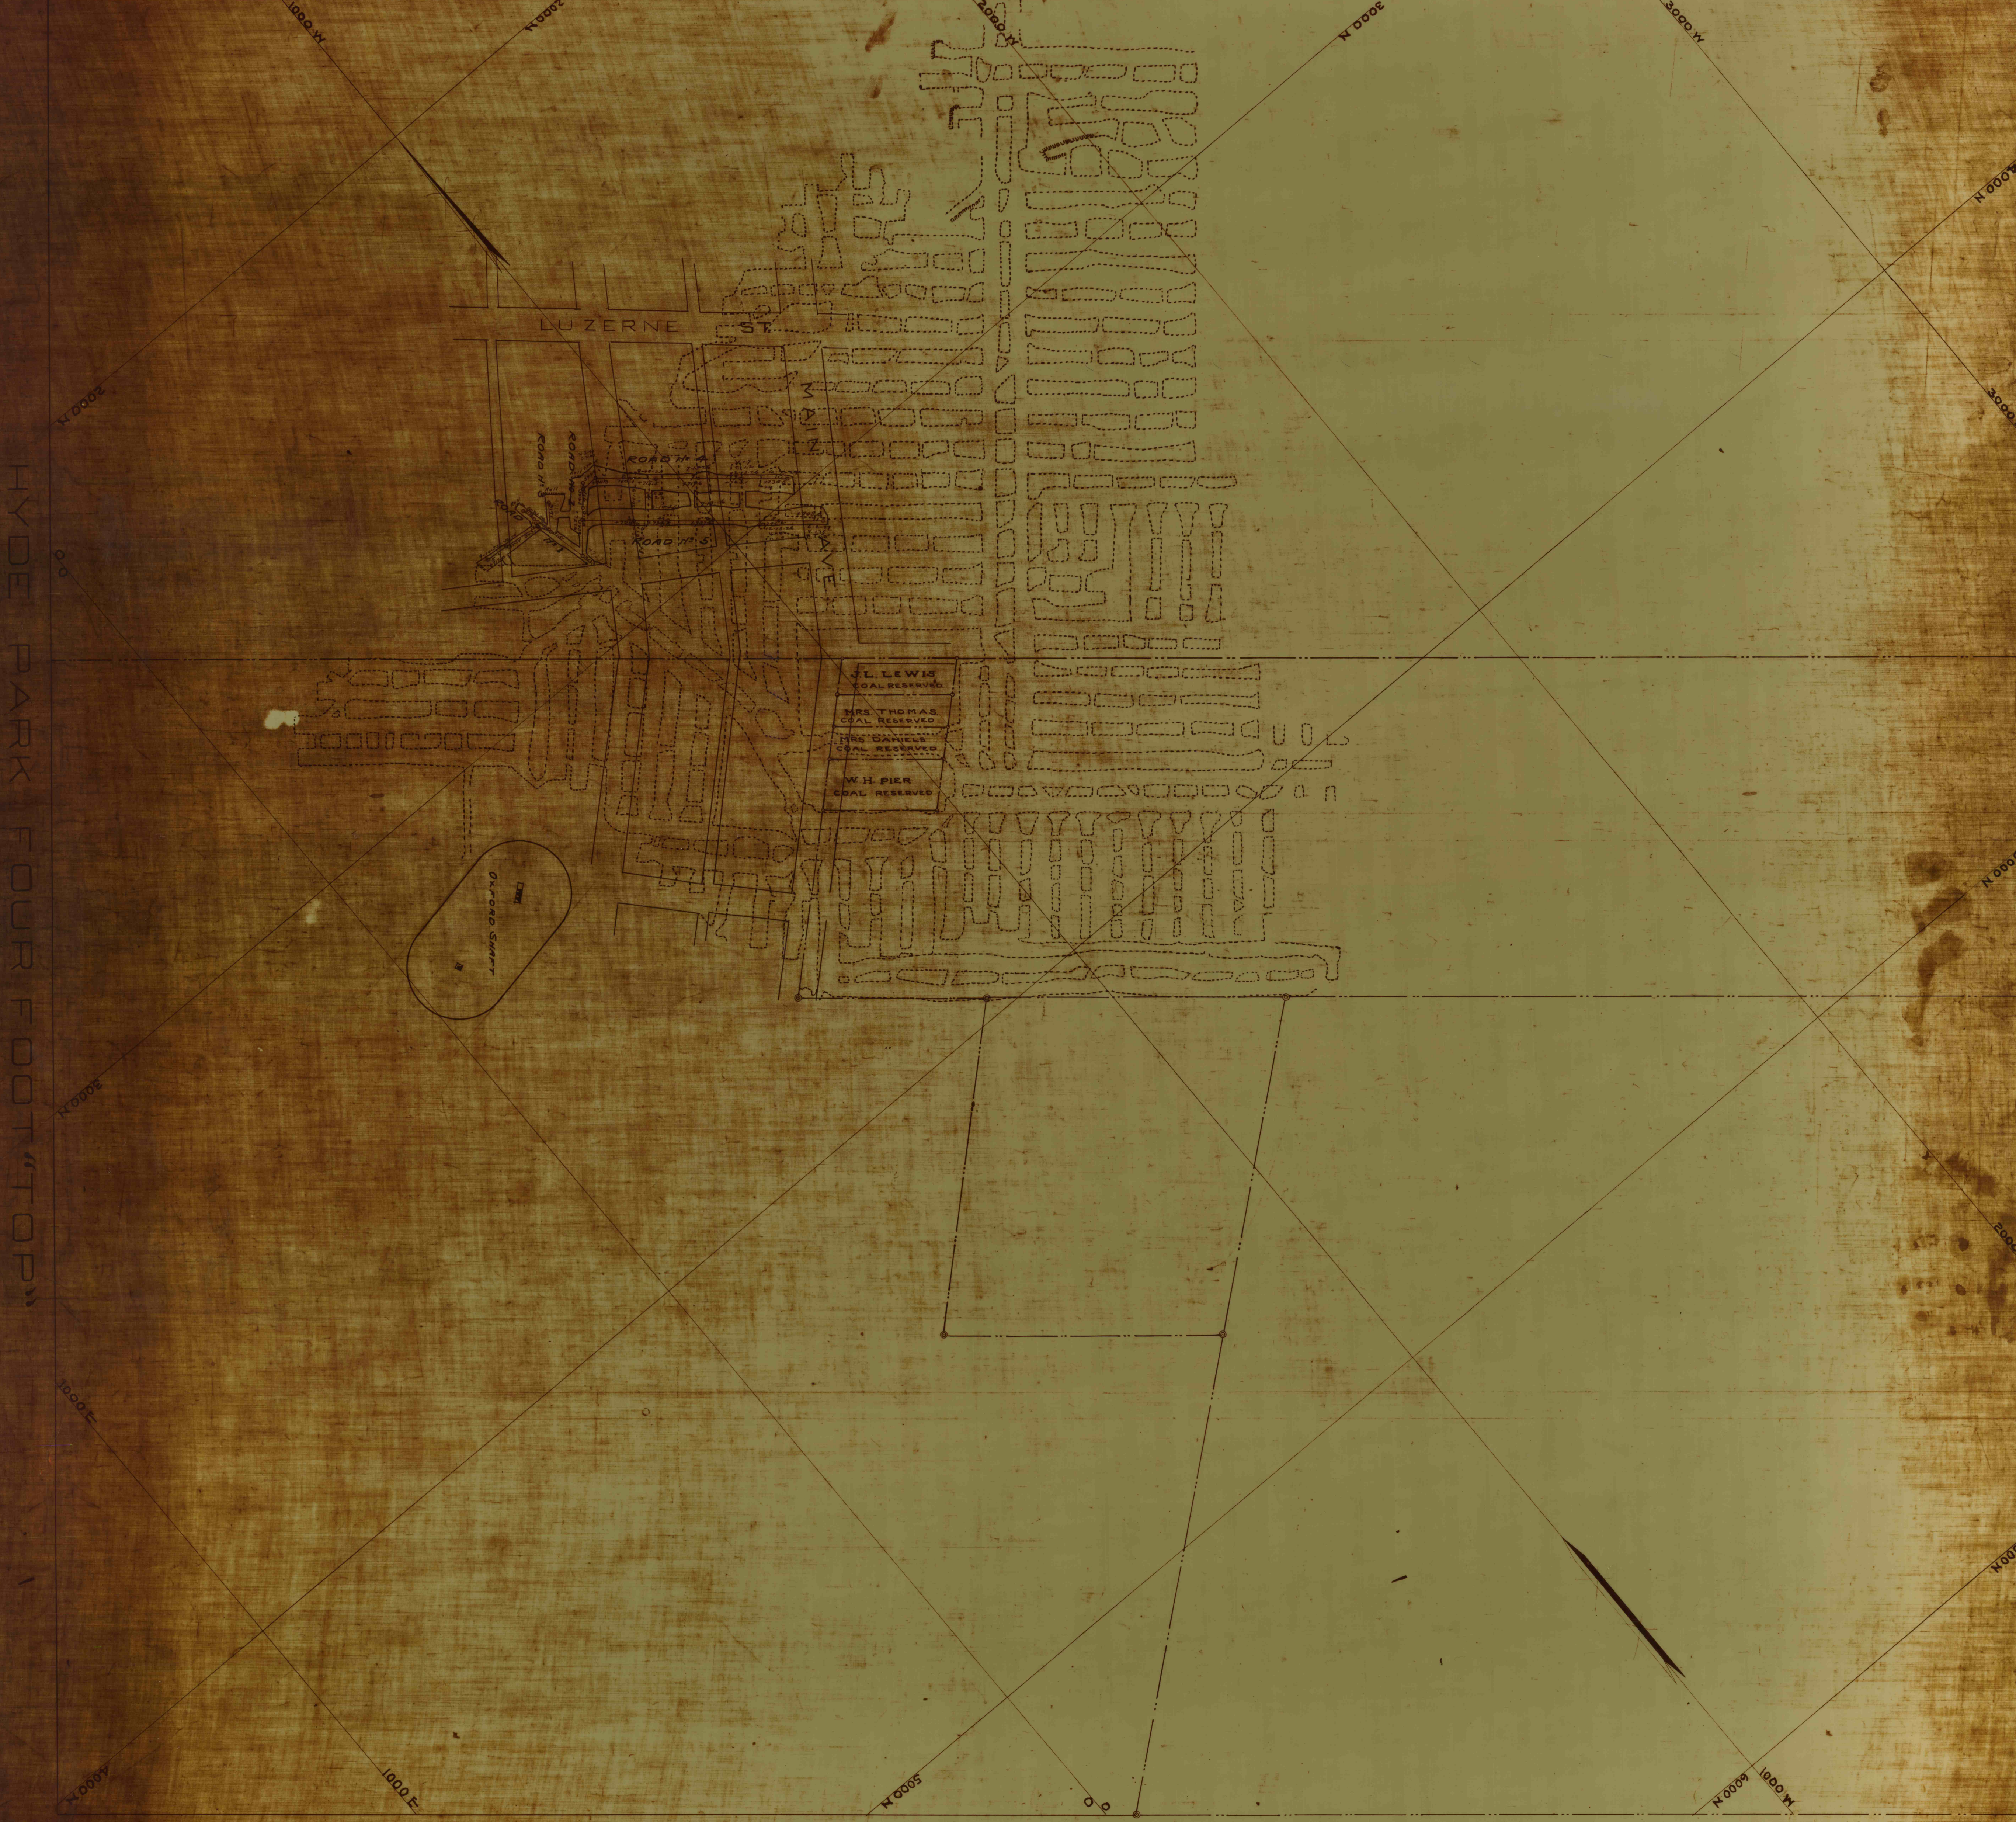

LUZERNE ST

ROAD N. 4

ROAD N. 5

J.L. LEWIS
COAL RESERVE
MRS. THOMAS
COAL RESERVE
MRS. DANIELS
COAL RESERVE
W.H. PIER
COAL RESERVE

DIPLOMA SMANT

