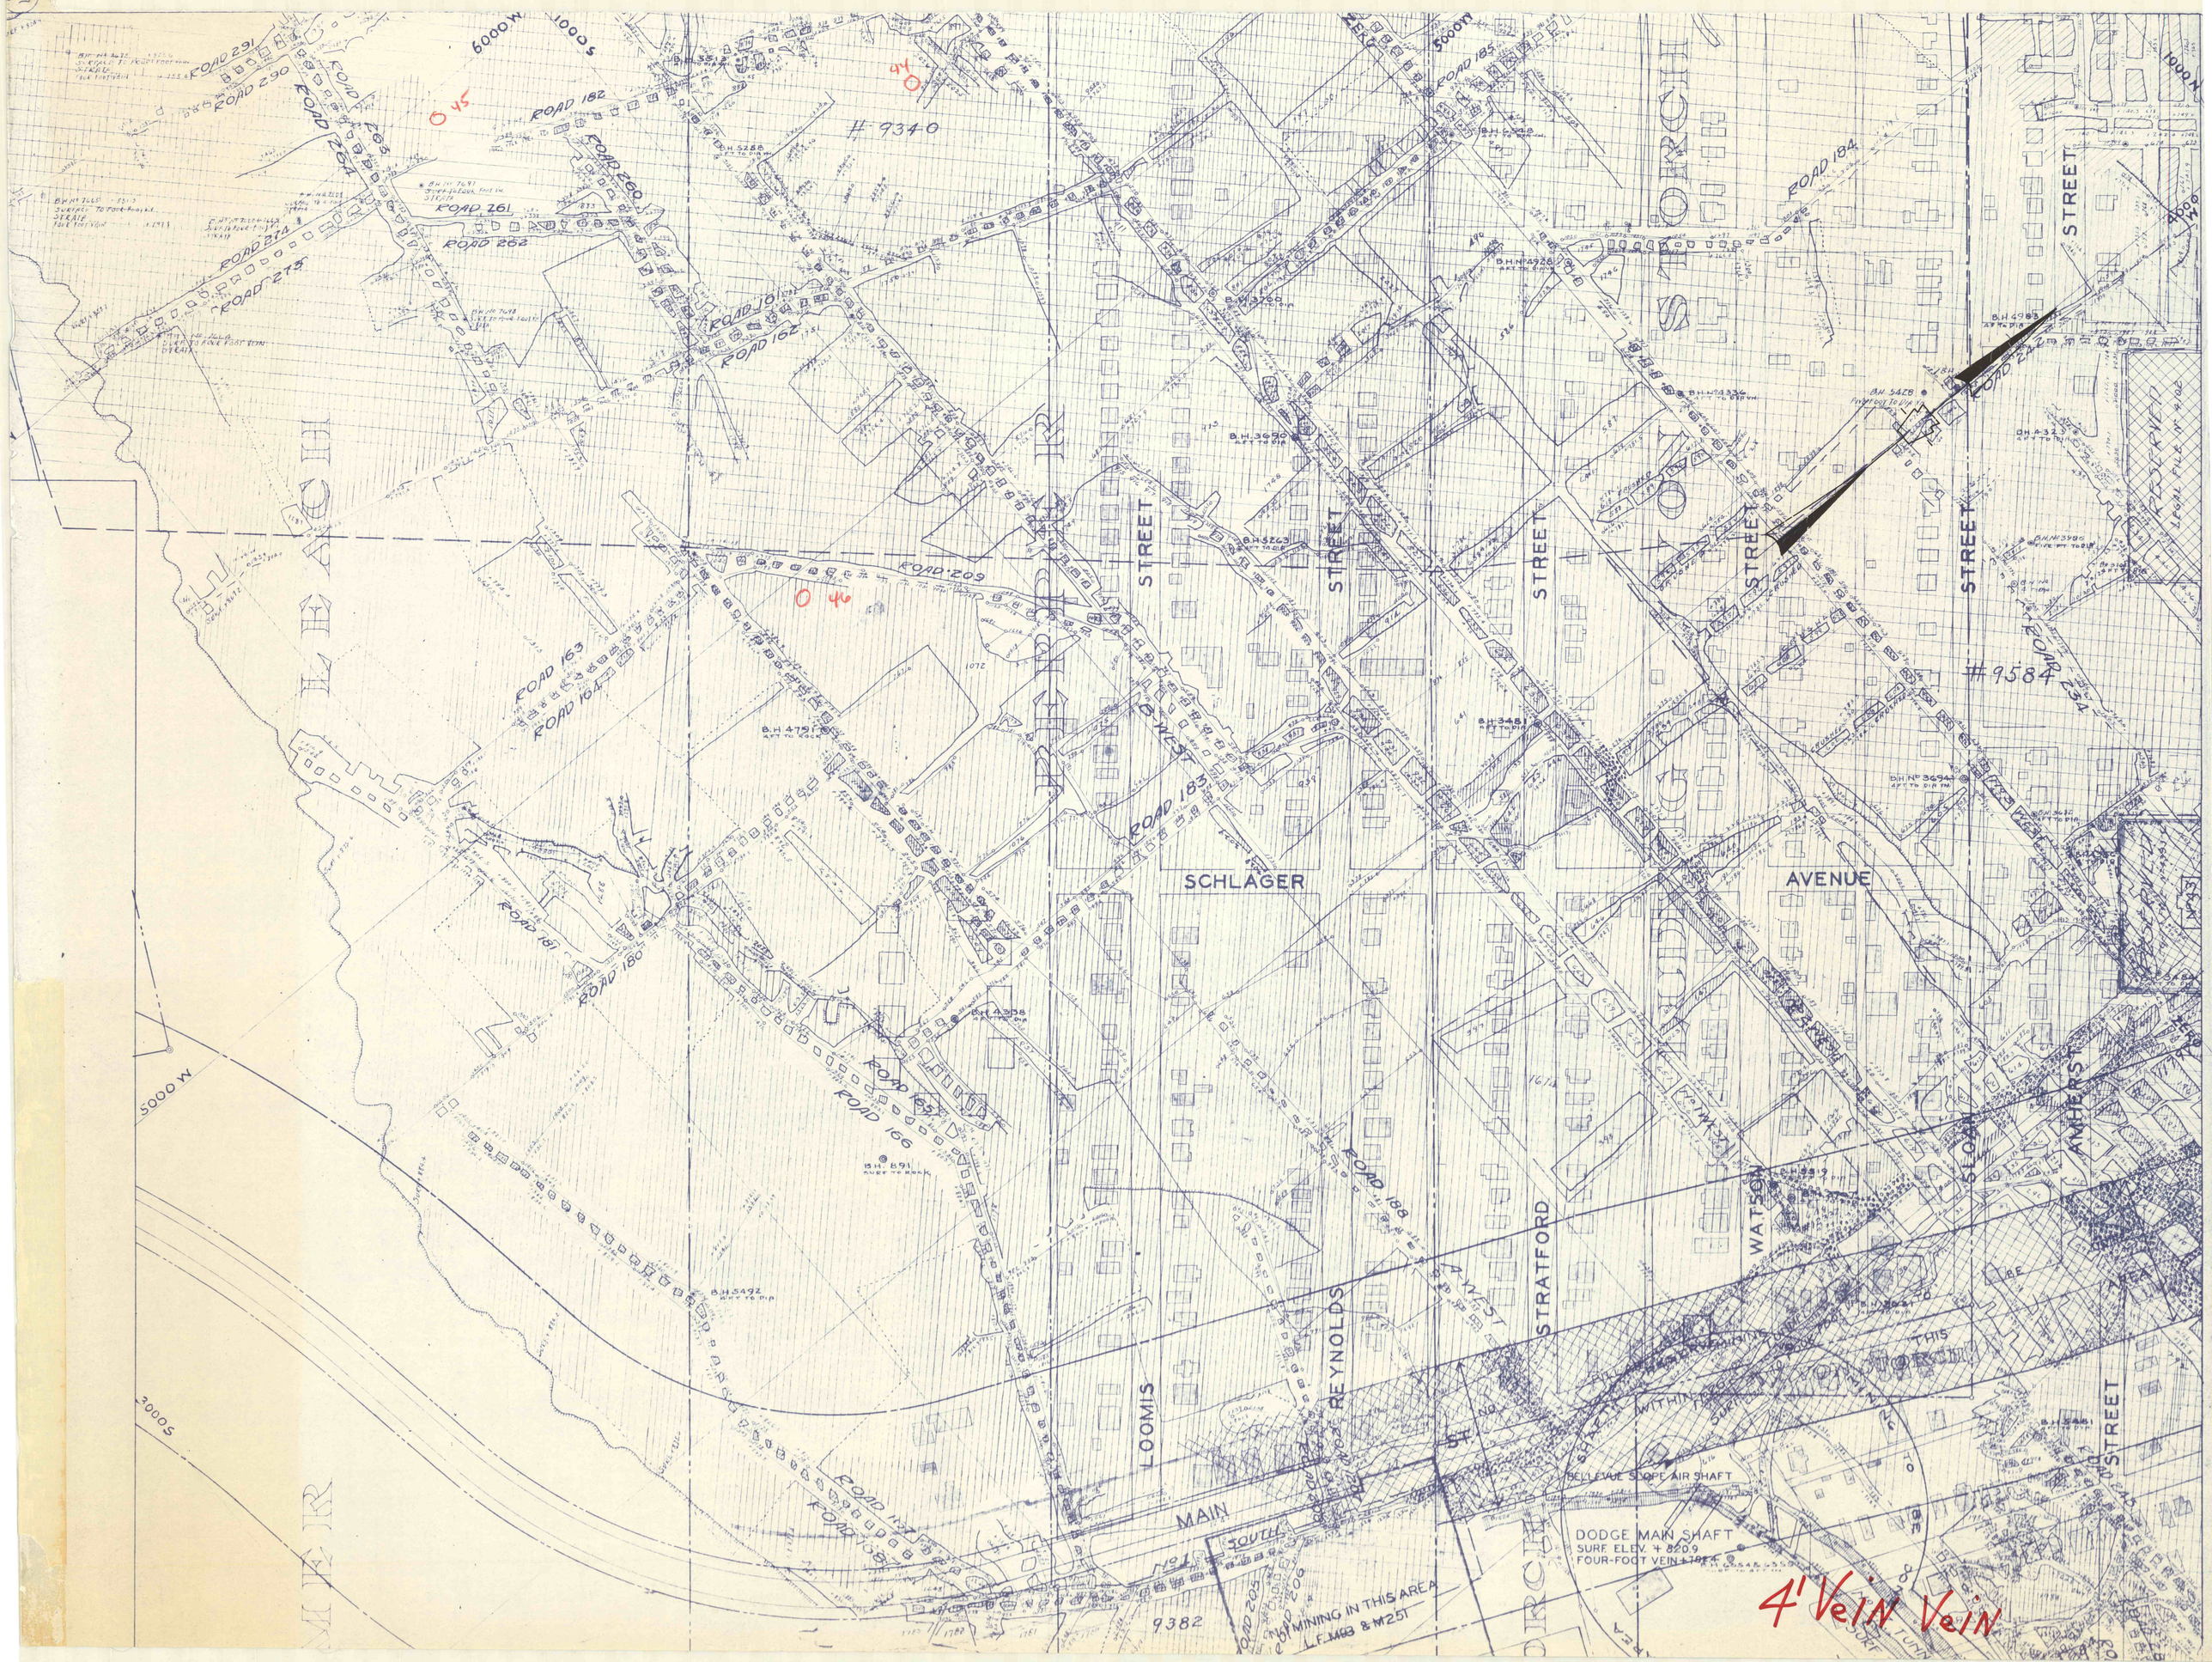
SCHLAGER
AVENUE
STREET
STRATFORD
WATSON
LOOMIS
REYNOLDS
AMHERST
MAIN
SOUTH
BELLEVUE SLOPE AIR SHAFT
DODGE MAIN SHAFT
SURF ELEV + 8209
FOUR-FOOT VEIN
NO MINING IN THIS AREA
L.F. M63 & M251
4' Vein Vein
#9340
#9584
9382
ROAD 182
ROAD 183
ROAD 184
ROAD 185
ROAD 188
ROAD 189
ROAD 209
ROAD 234
ROAD 261
ROAD 262
ROAD 263
ROAD 264
ROAD 290
ROAD 291
ROAD 274
ROAD 273
ROAD 162
ROAD 163
ROAD 164
ROAD 165
ROAD 166
ROAD 180
ROAD 181
6000 W
5000 W
3000 S
1000 S
1000 N