


H

W. H. H. H. H.

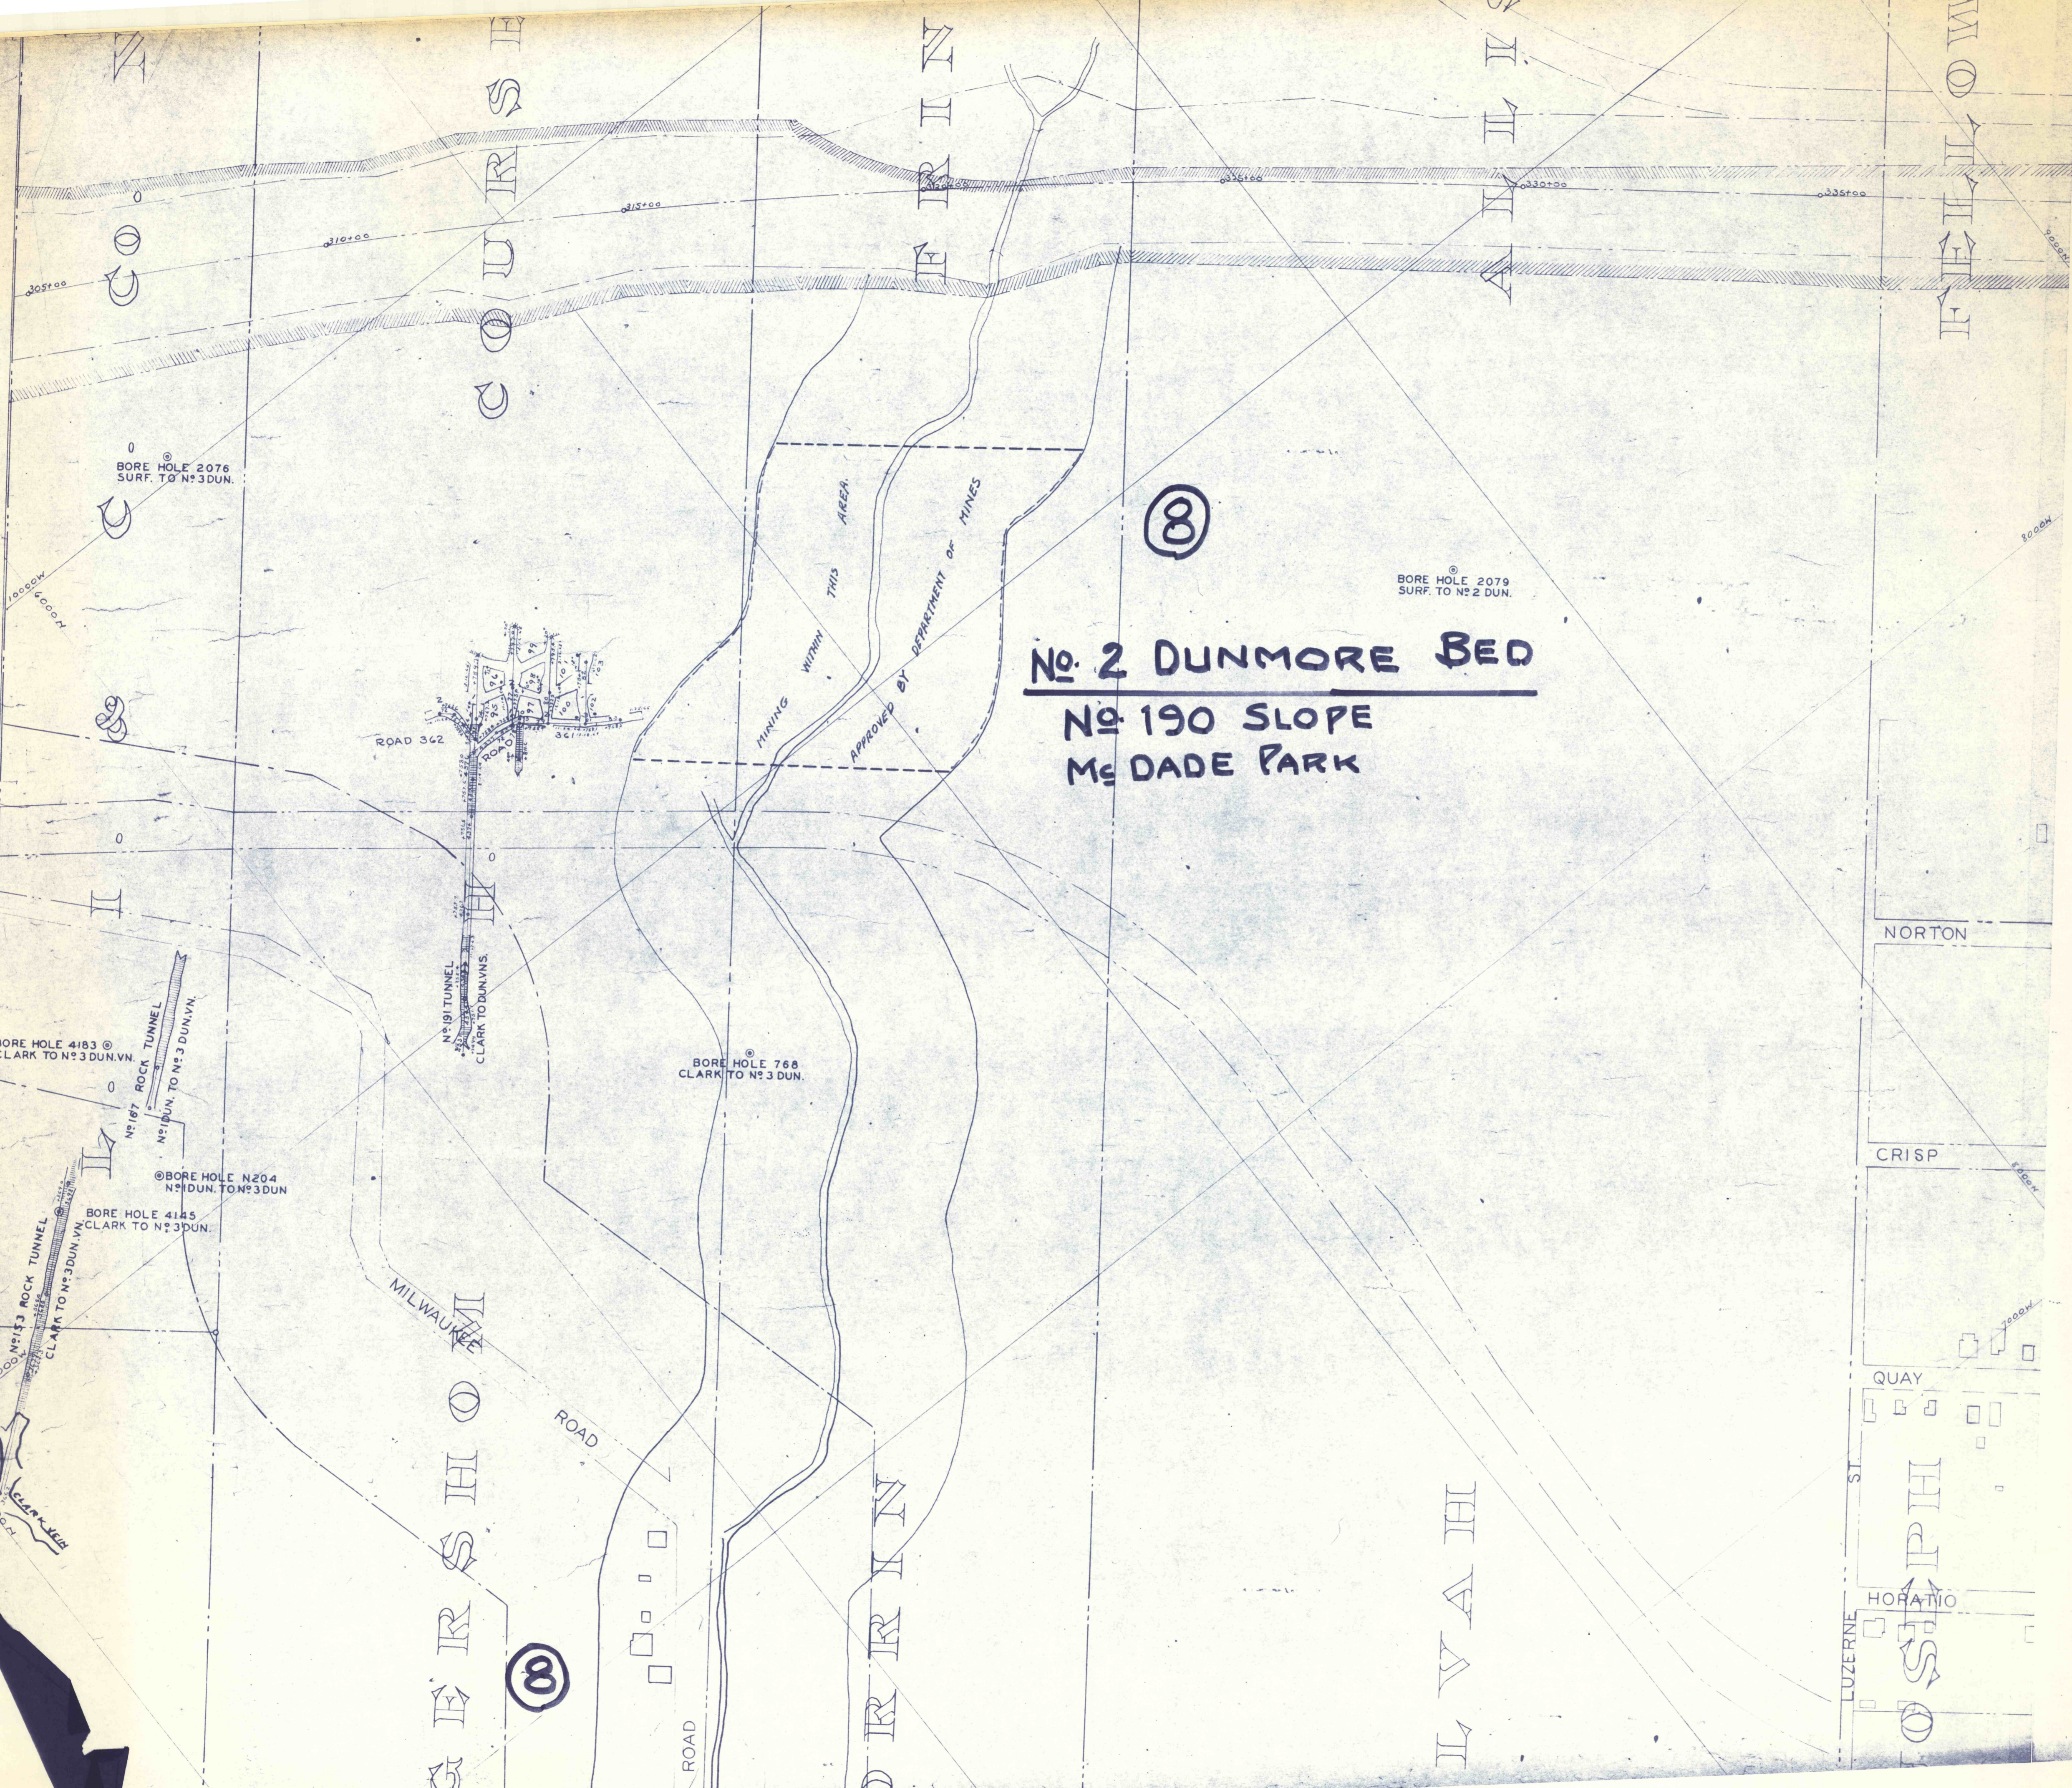

⑧

No. 2 DUNMORE BED

No. 190 SLOPE

ME DADE PARK

MINING WITHIN THIS AREA APPROVED BY DEPARTMENT OF MINES

NORTON

CRISP

QUAY

HORATIO

LUZERNE ST

⑧

⑧

⑧

No. 2 DUNMORE BED

H