

H

Geological Column


H

Rock 1-5

Rock 1-5

3a

ROCK BED
NO. 190 SLOPE
MCDADE PARK

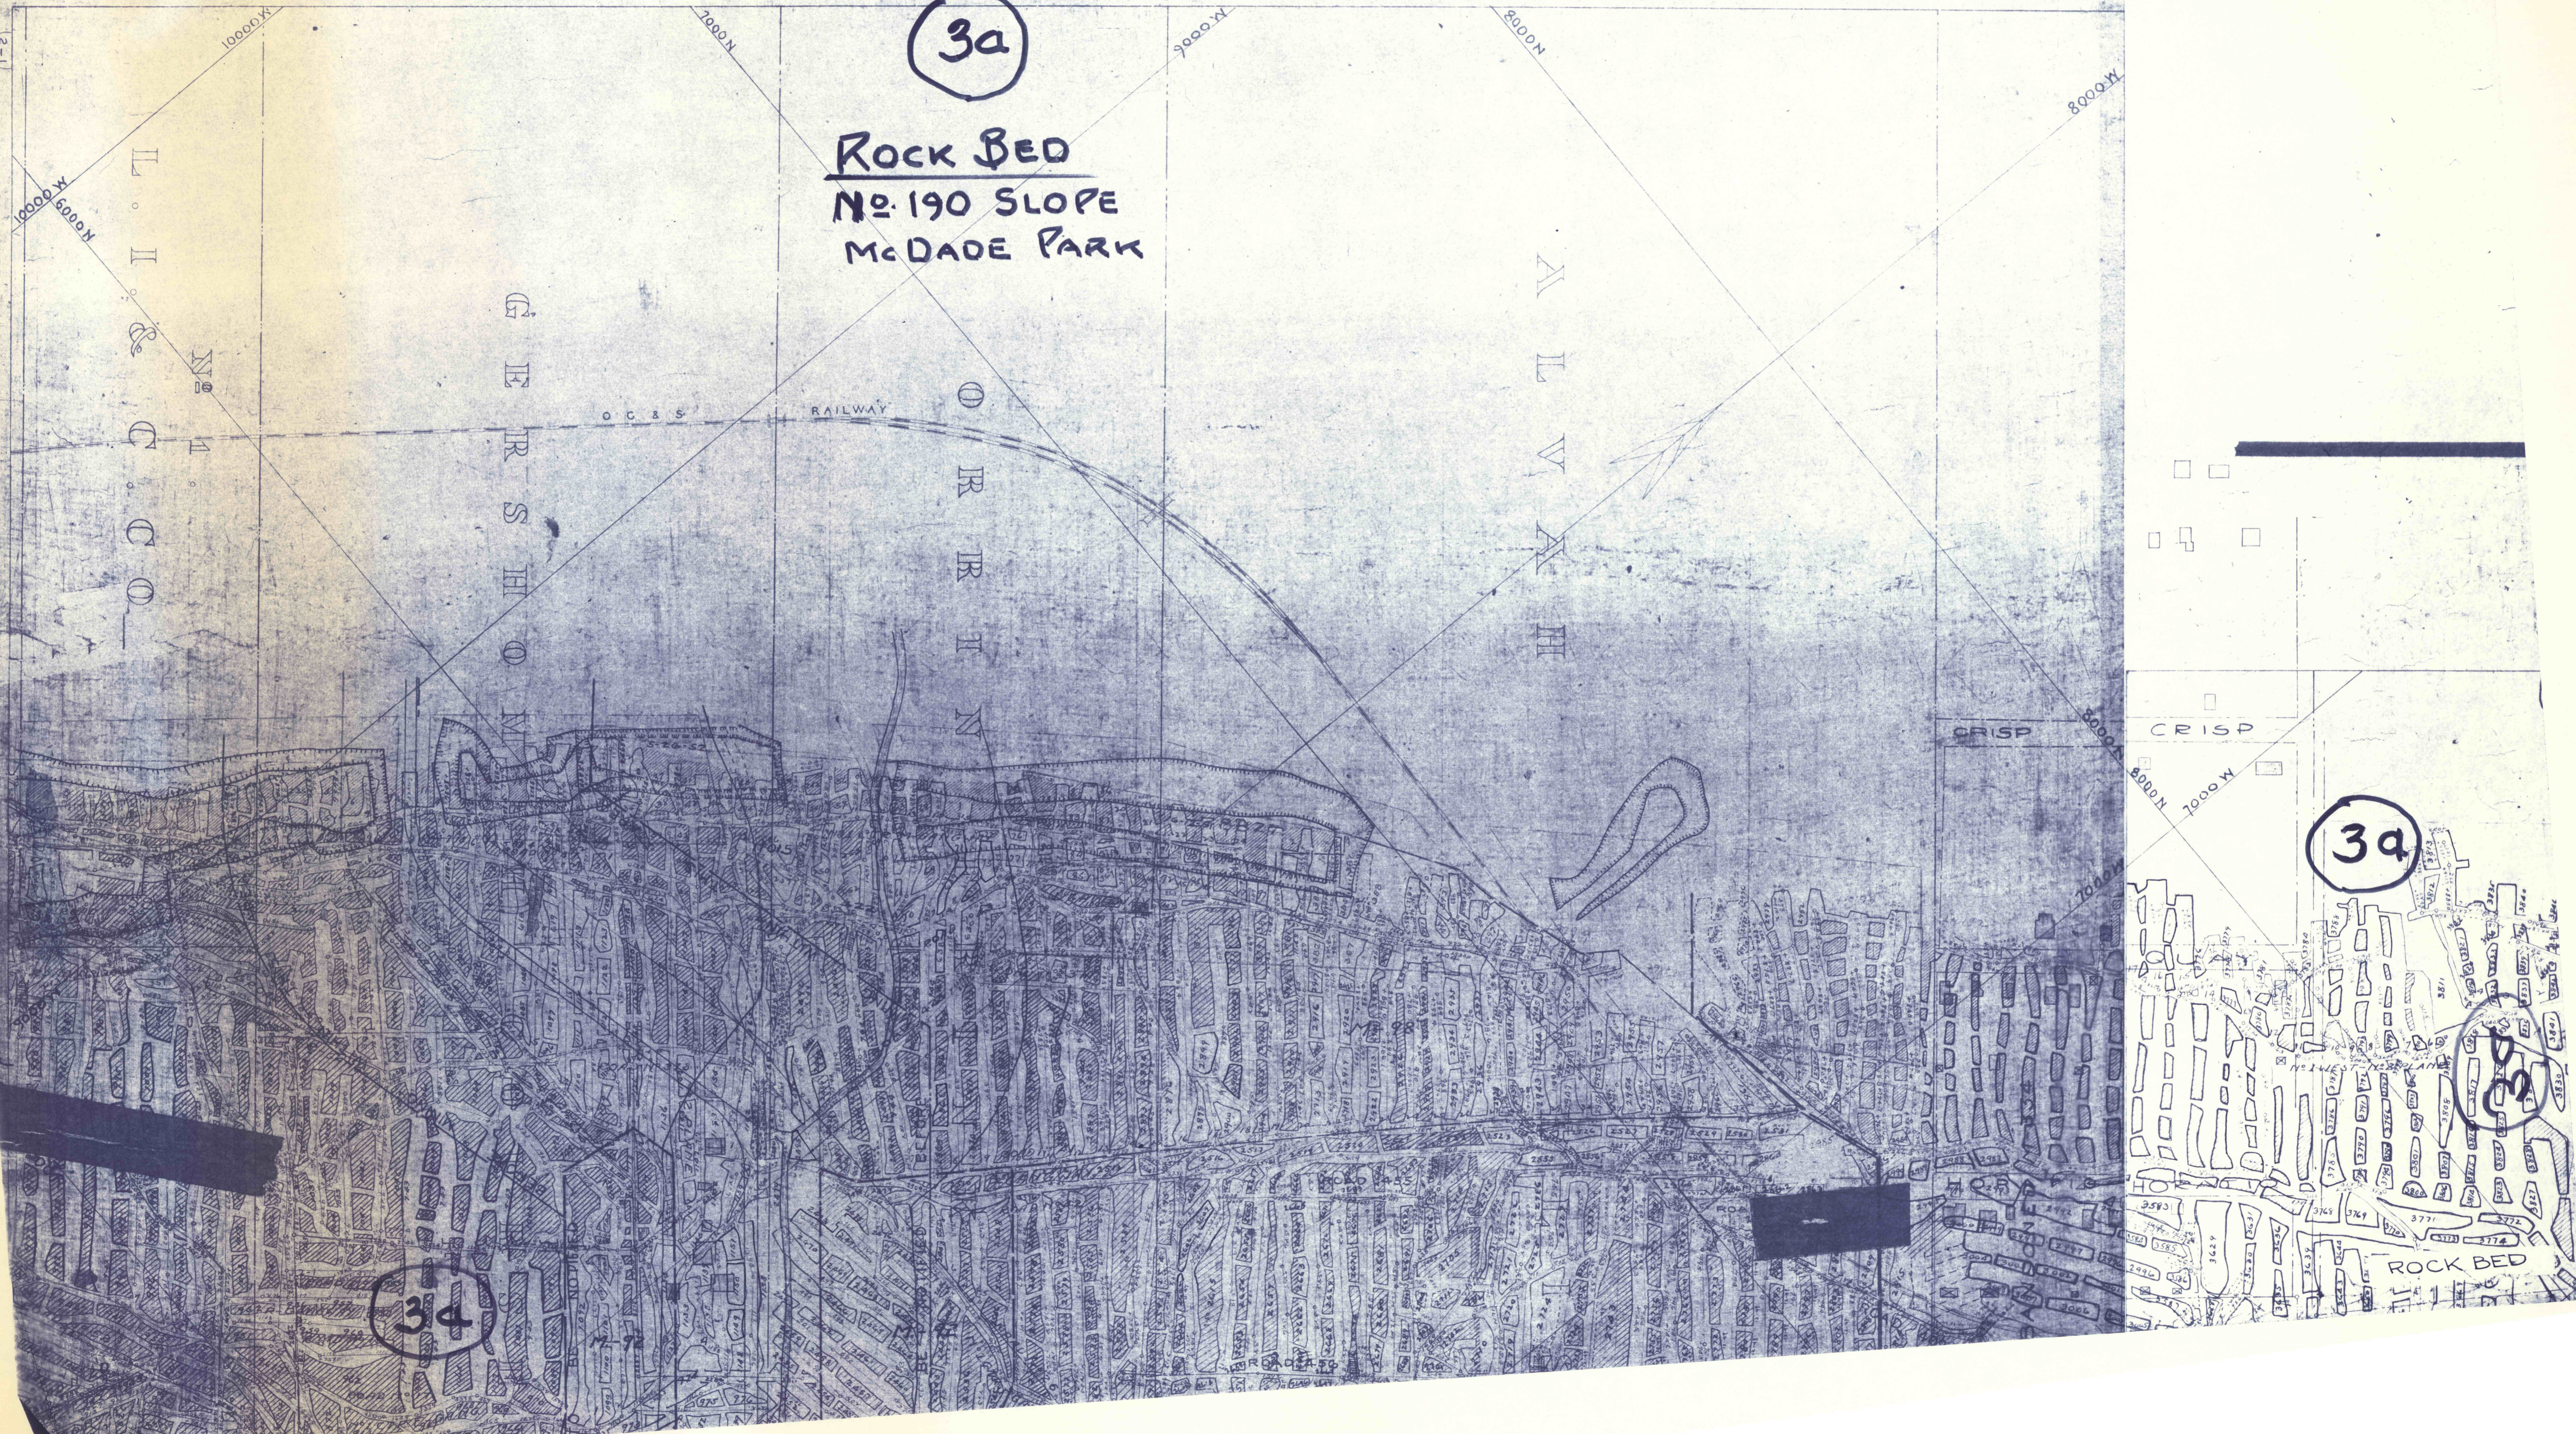

34

3a

ROCK BED