


4

BIG BED
No. 190 SLOPE
Mc DADE PARK

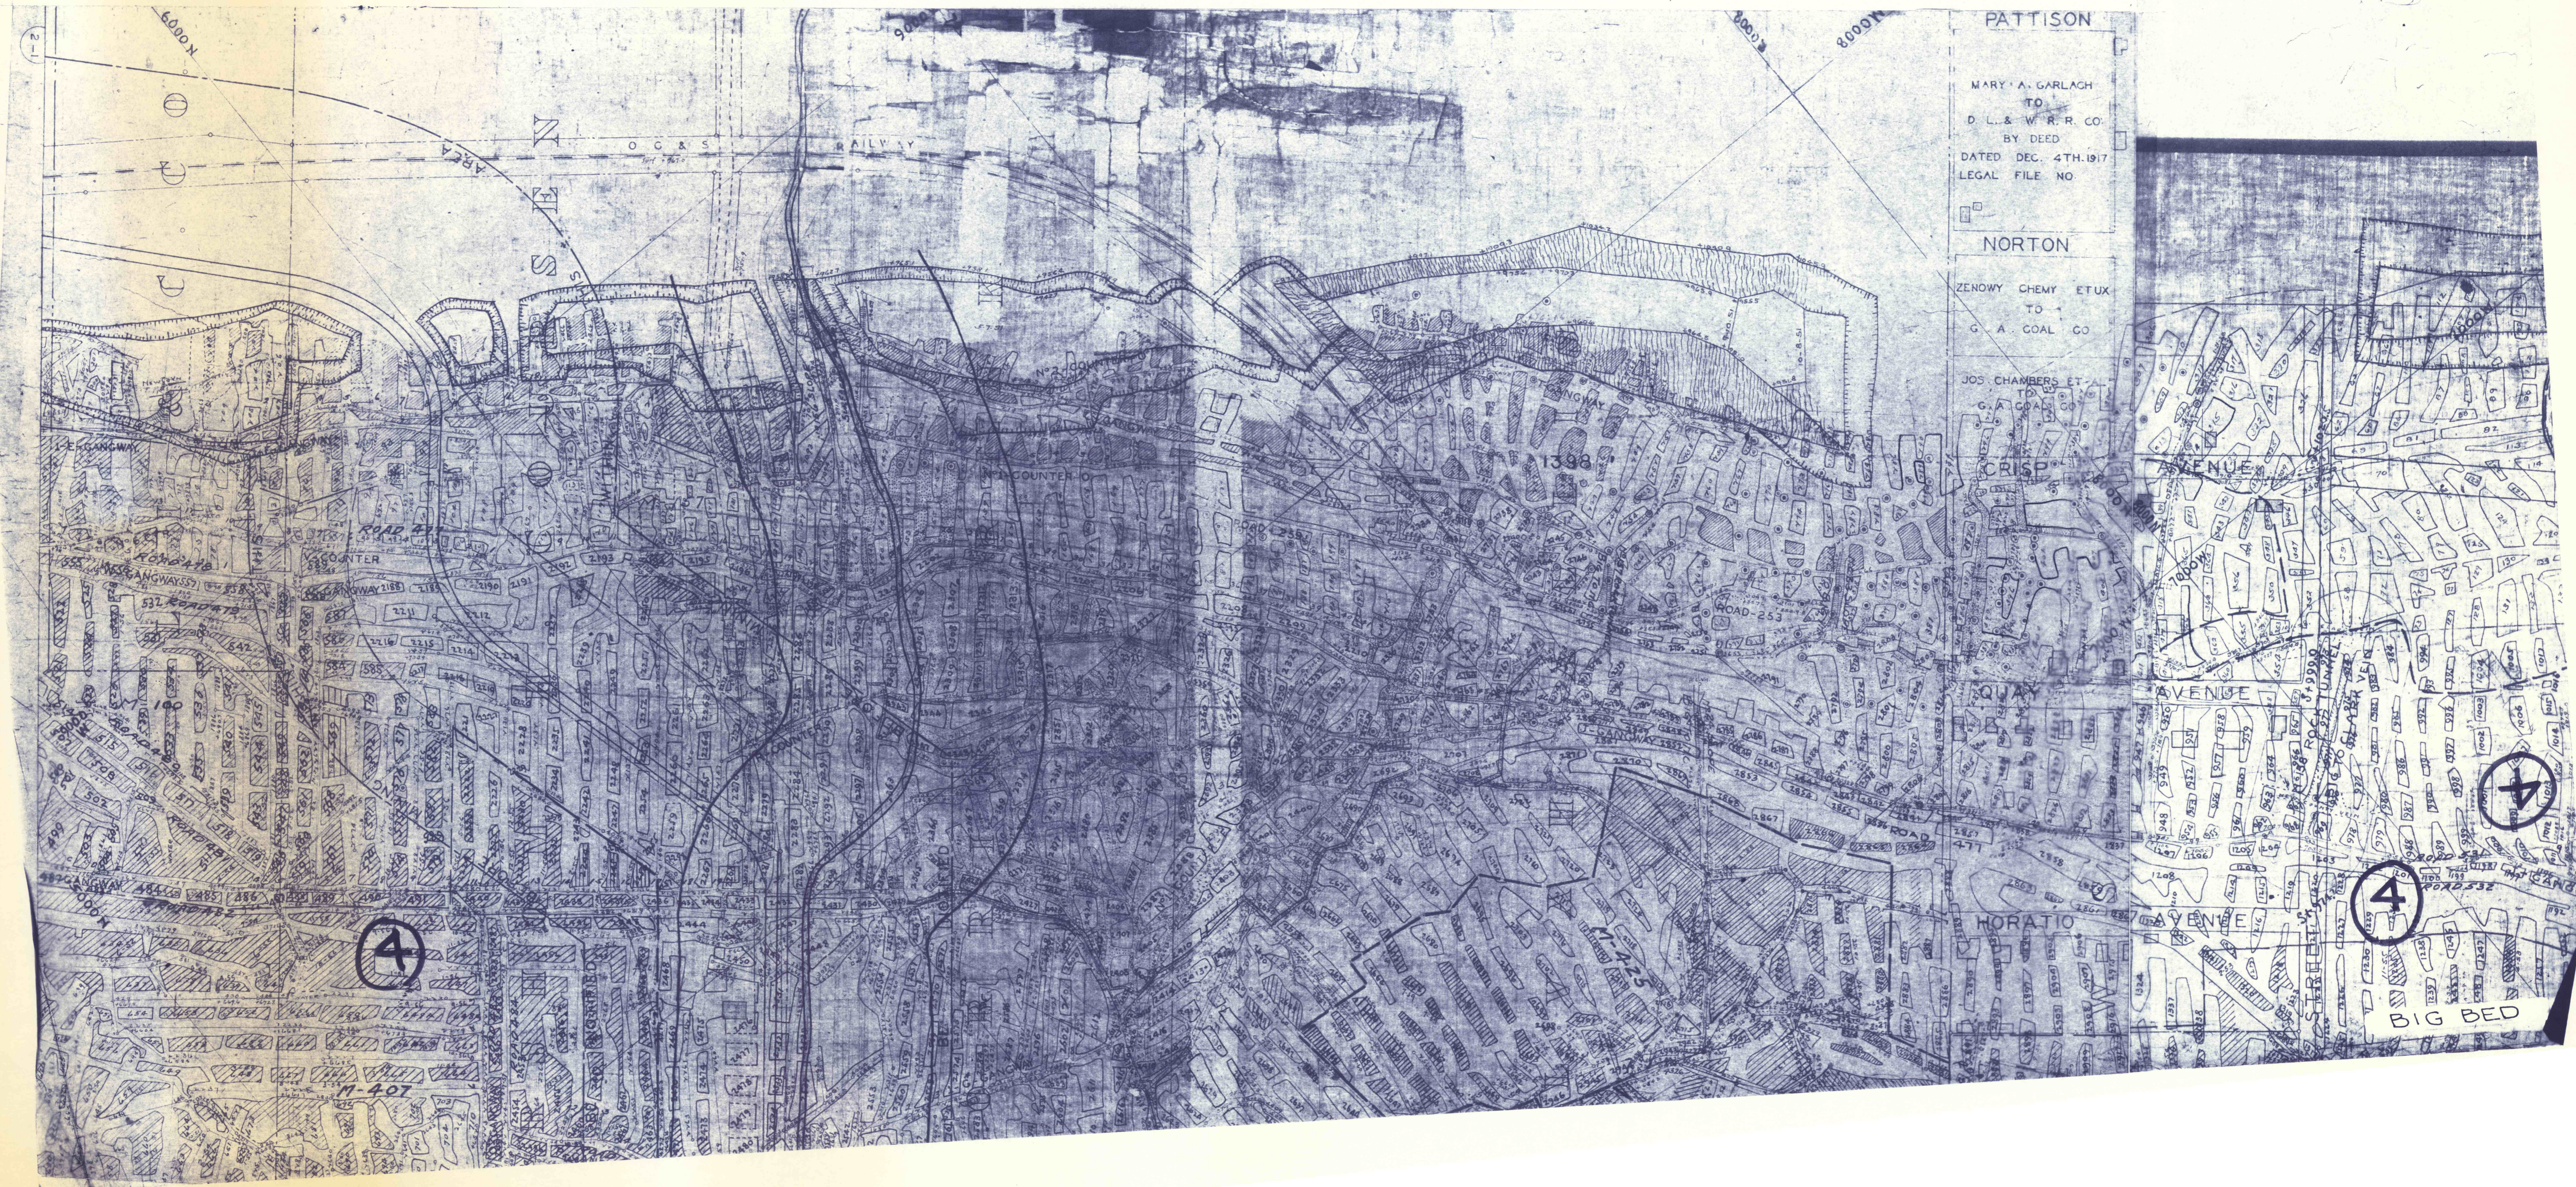

PATTISON
MARY A. GARLACH
TO
D. L. & W. R. R. CO.
BY DEED
DATED DEC. 4TH. 1917
LEGAL FILE NO.

NORTON
ZENOWY CHEMY ET UX
TO
G. A. GOAL CO.

JOS CHAMBERS ET
TO
G. A. GOAL CO.

4

BIG BED