



334

T. VANSTORCH.

334

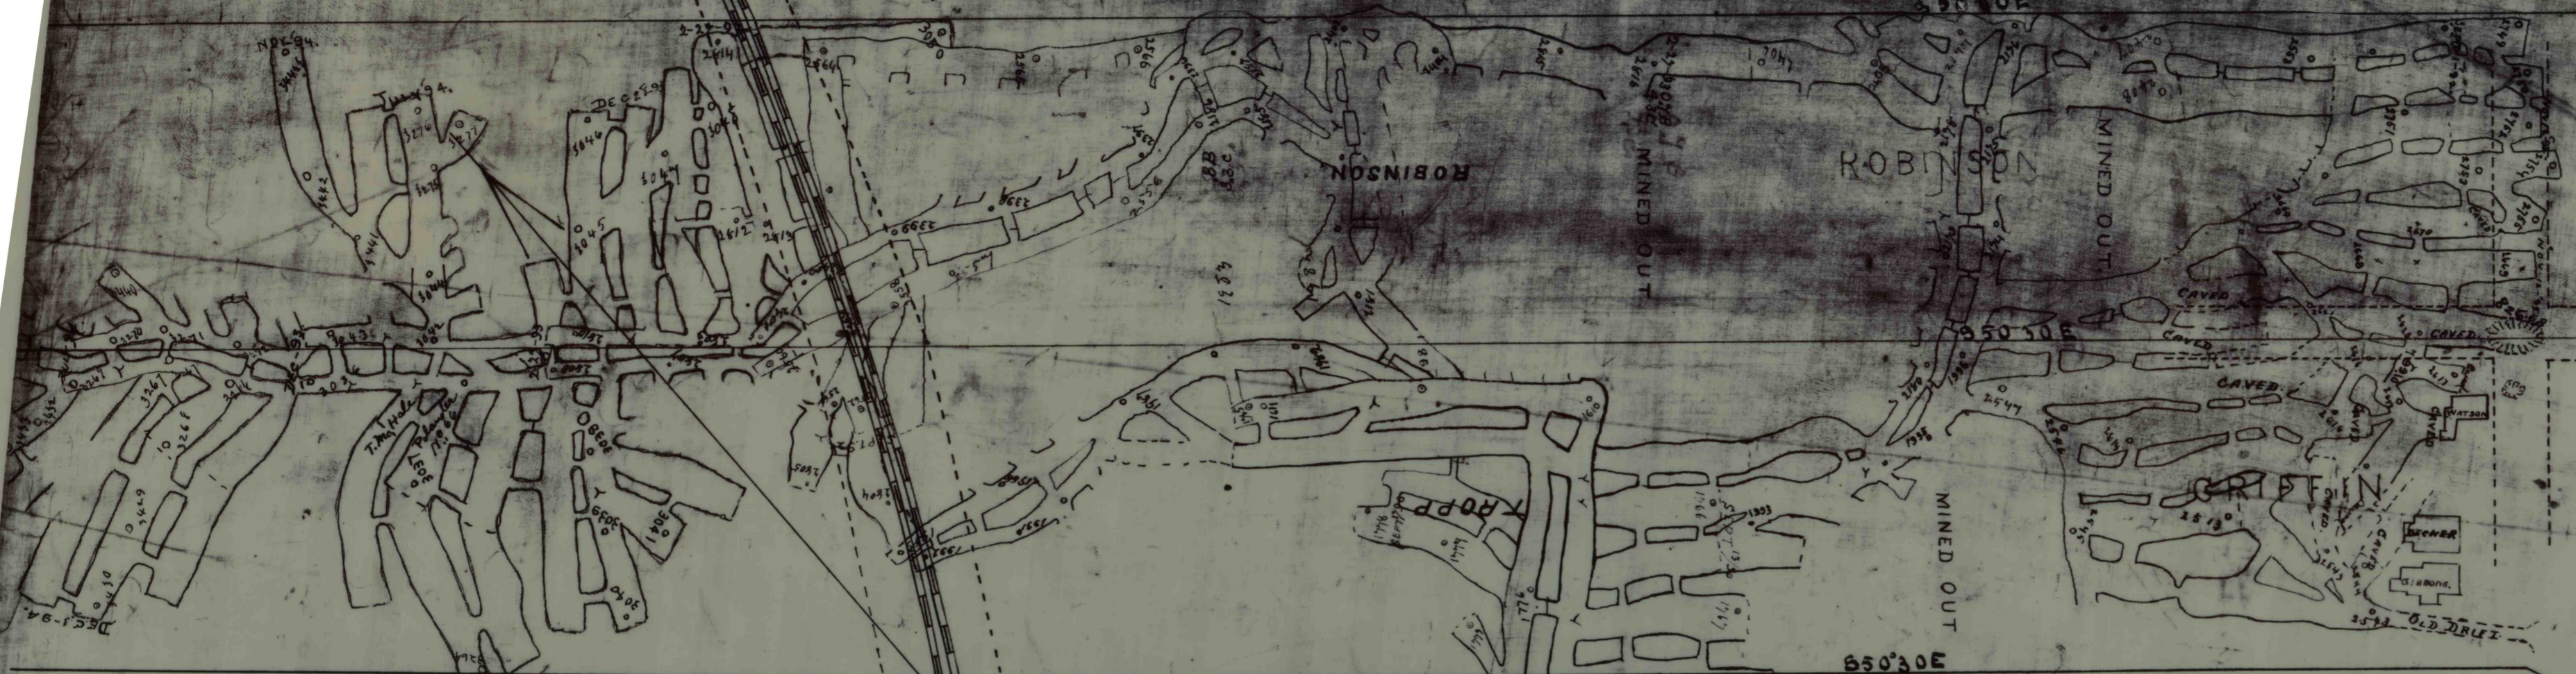

D. L. & W. R. R. Co.

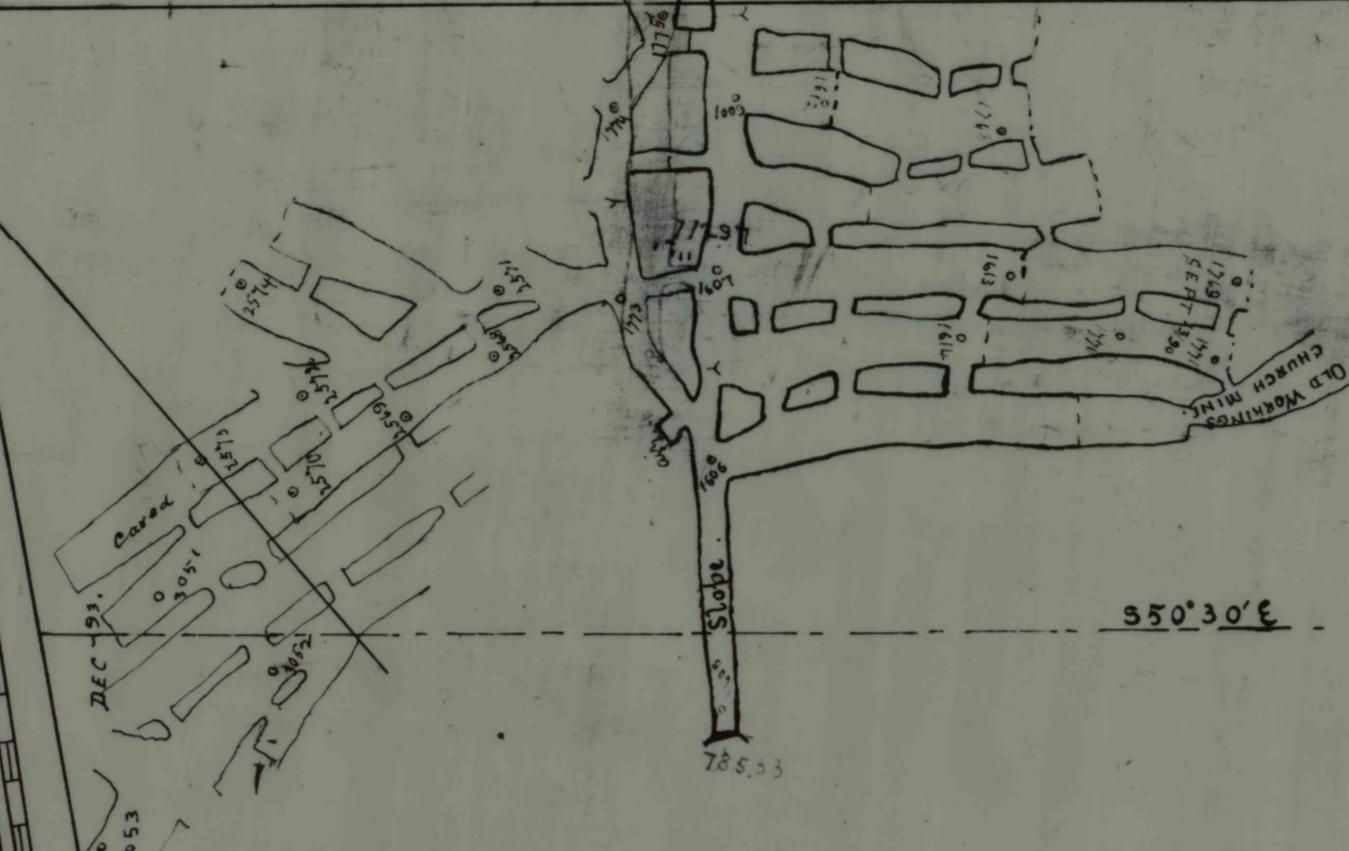

55°30'E

5.1 MI. FT. VEIN

646'30E

WORKINGS IN
THE FIVE FOOT VEIN
OF THE
PROVIDENCE C. CO.
SURVEYS EXTENDED TO WORKINGS
BY J. T. REESE



W I N T O N

PROVIDENCE COAL CO
334