
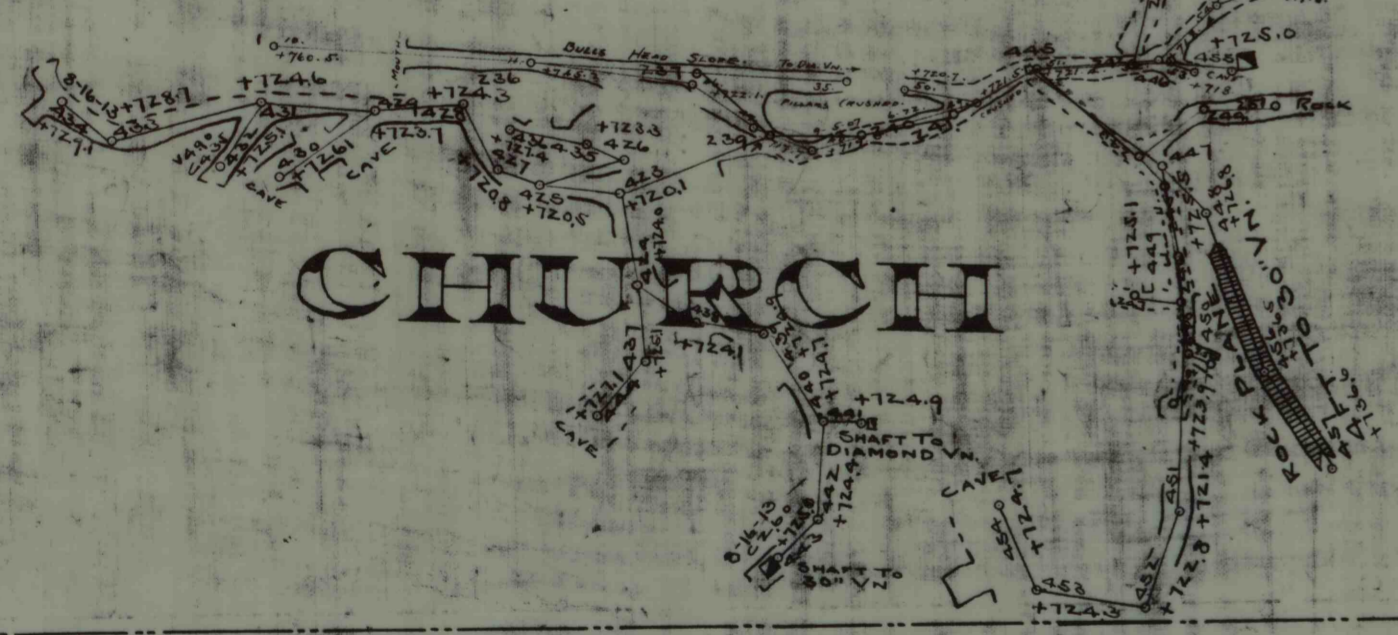


Copied from Map by H. L. Harding

NASSAU

CHURCH

KELSEY

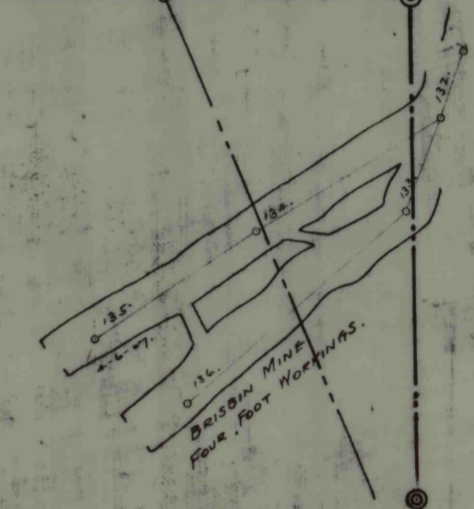

WAY IN FEE

+811.5 SUR