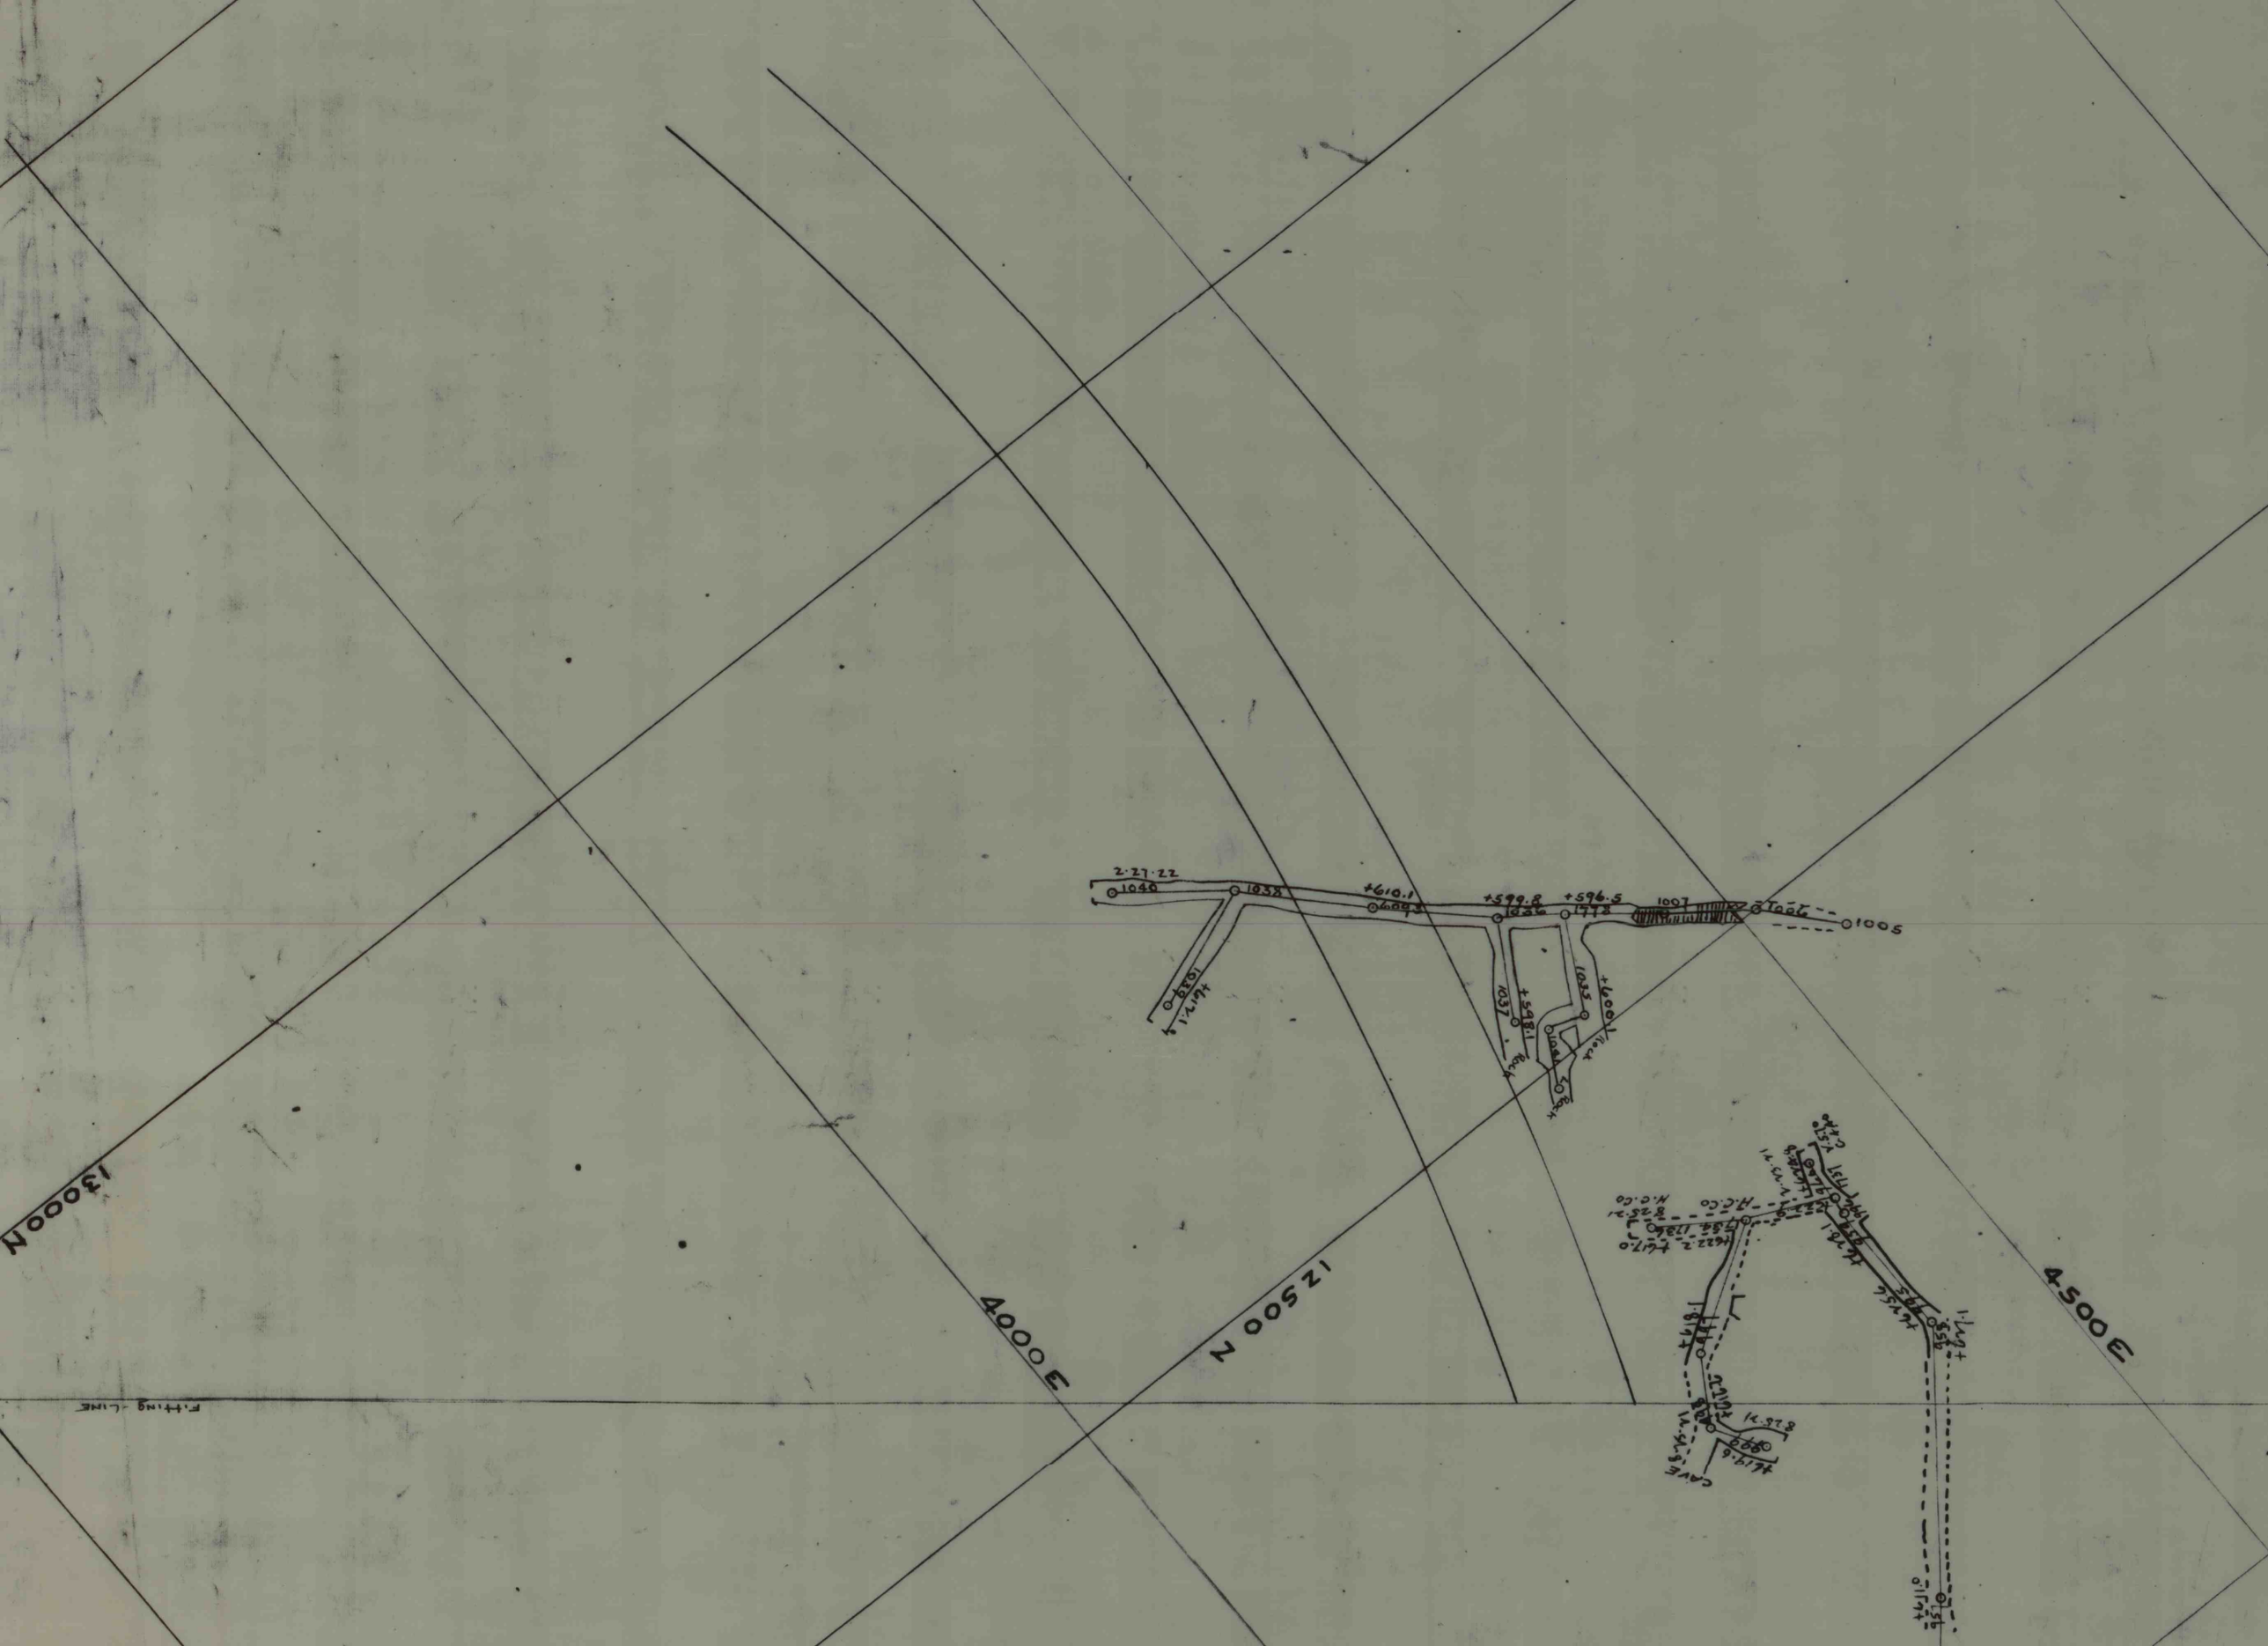
13000N
4000E
12500N
4500E
FITTING LINE
1040
1038
+610.1
+599.8
+596.5
1007
1005
1039
1037
1033
1034
1032
1035
1036
