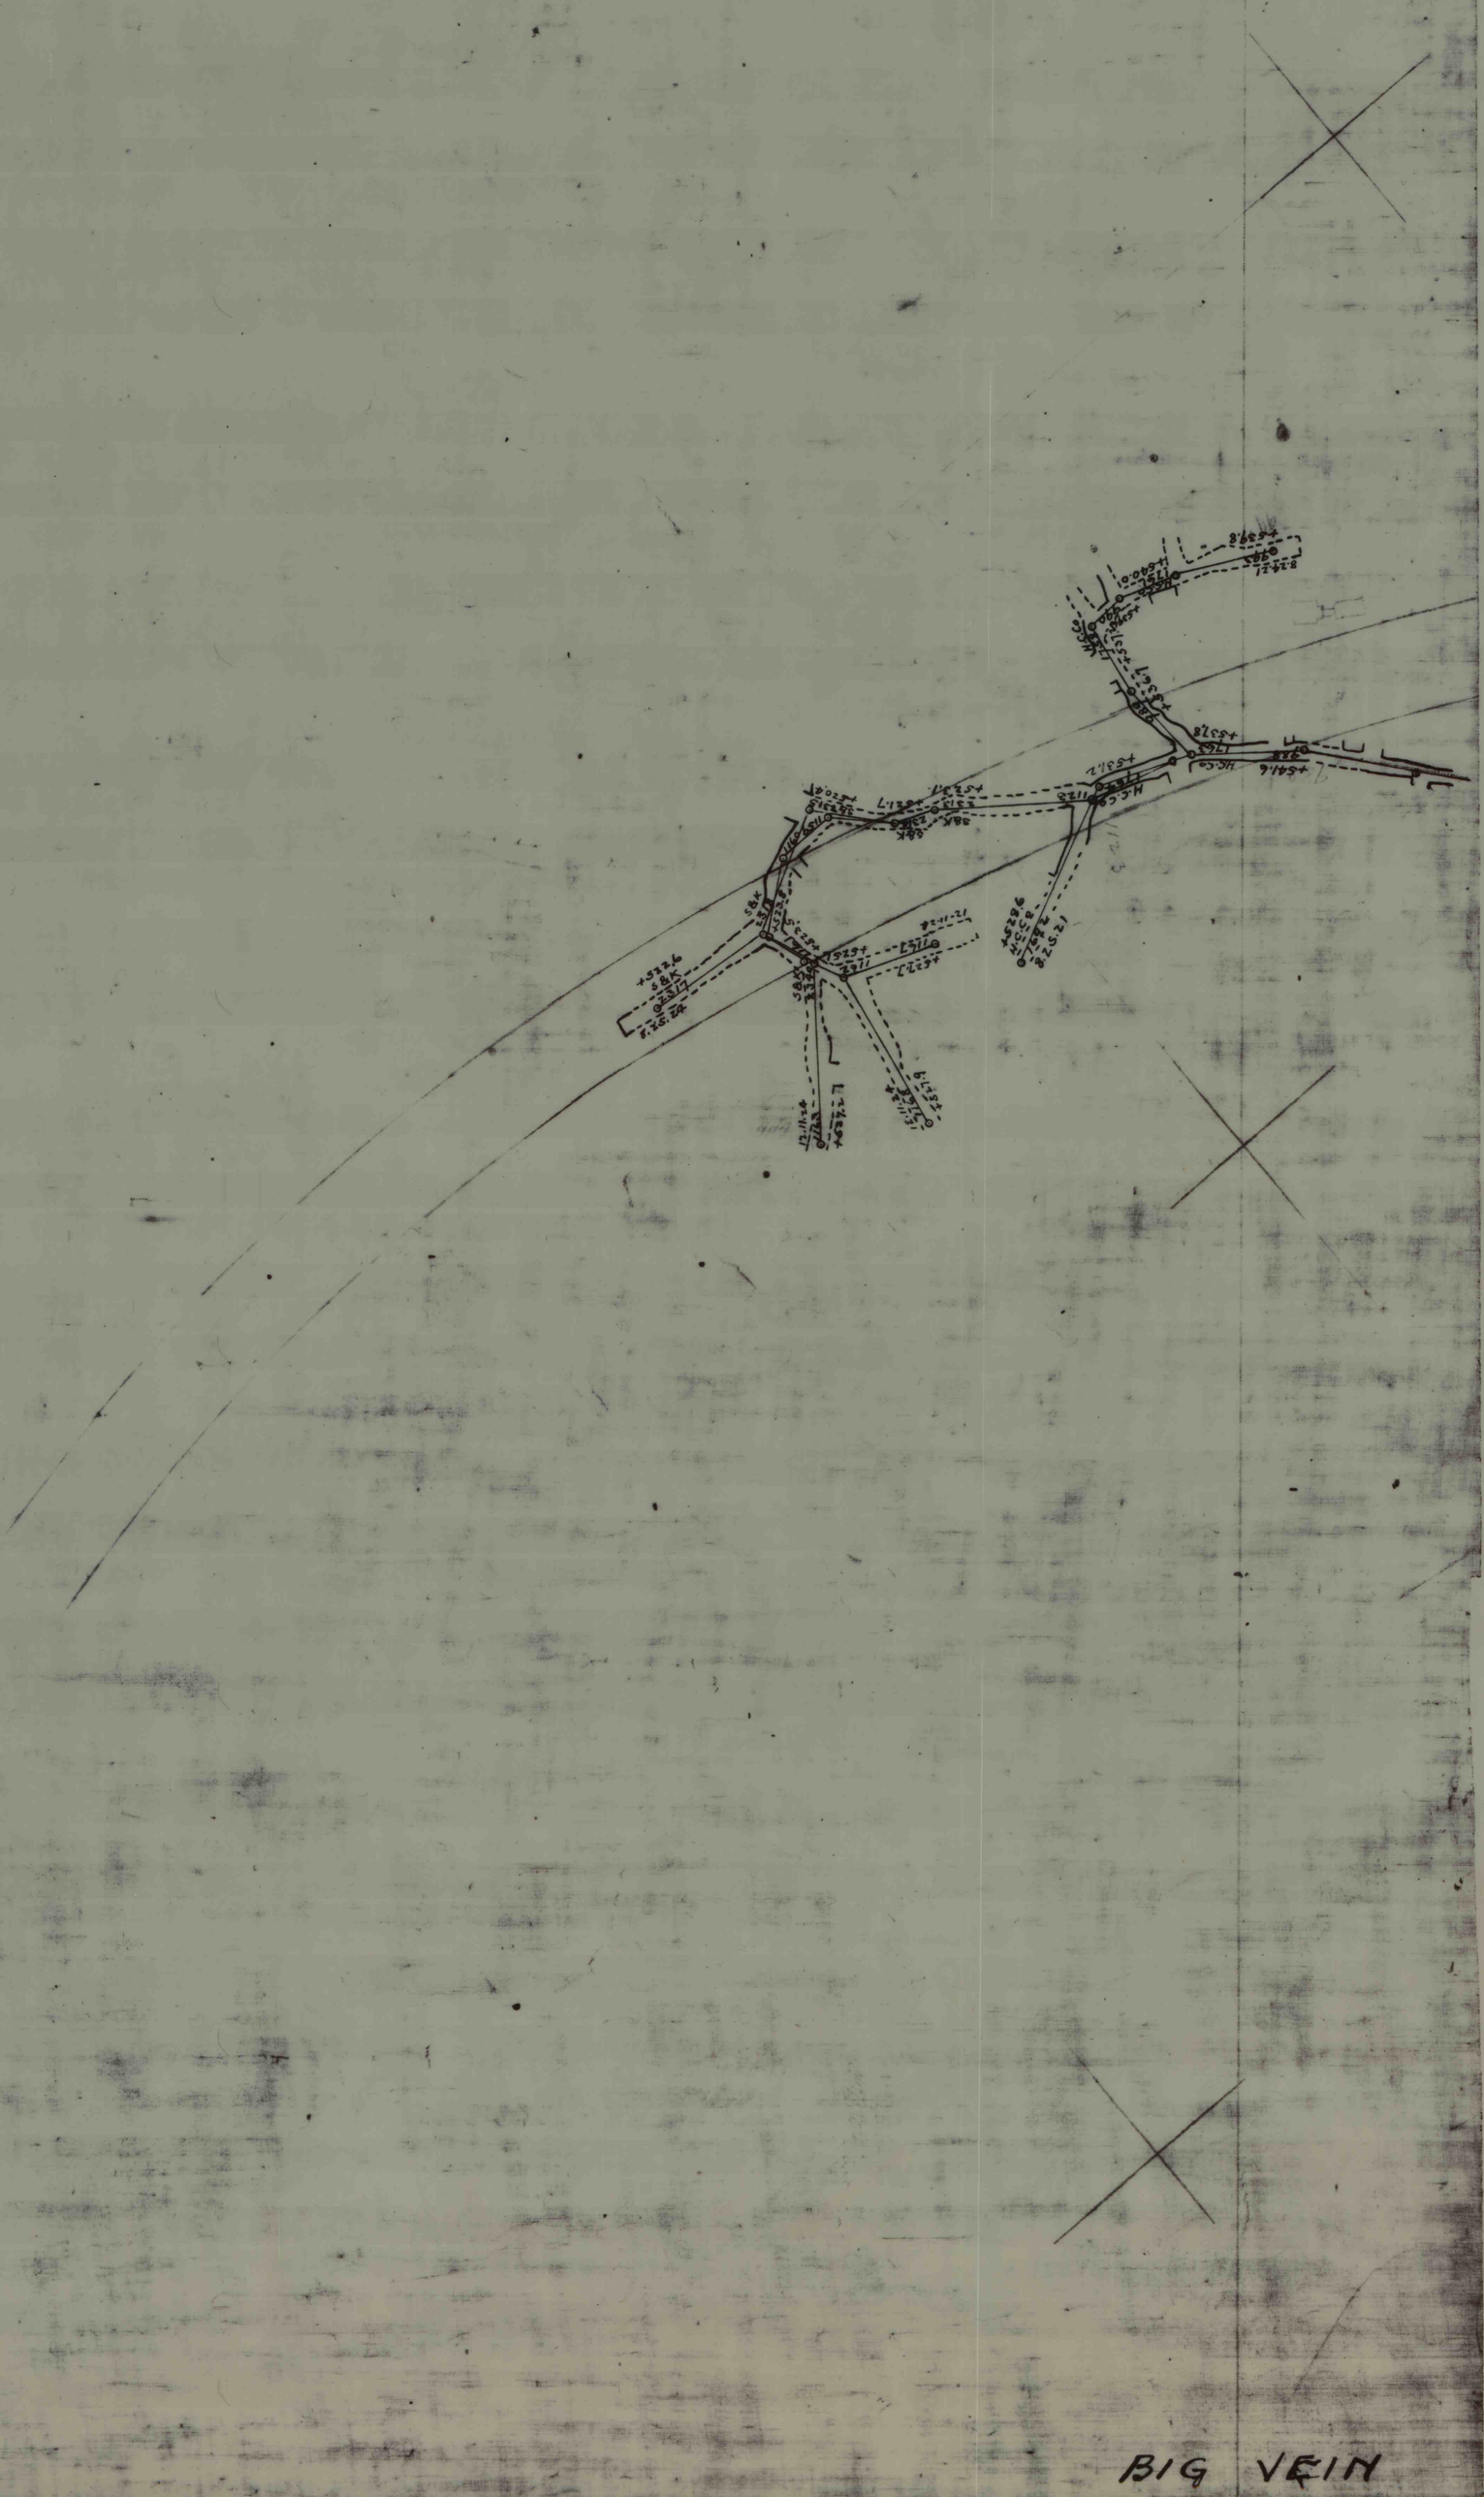

BIG VEIN