

D. W. & W.

D. W. & W.

D. W. & W.


D. & H. Co.

Earl & Griffin

Tract

Tract

Coal Co.

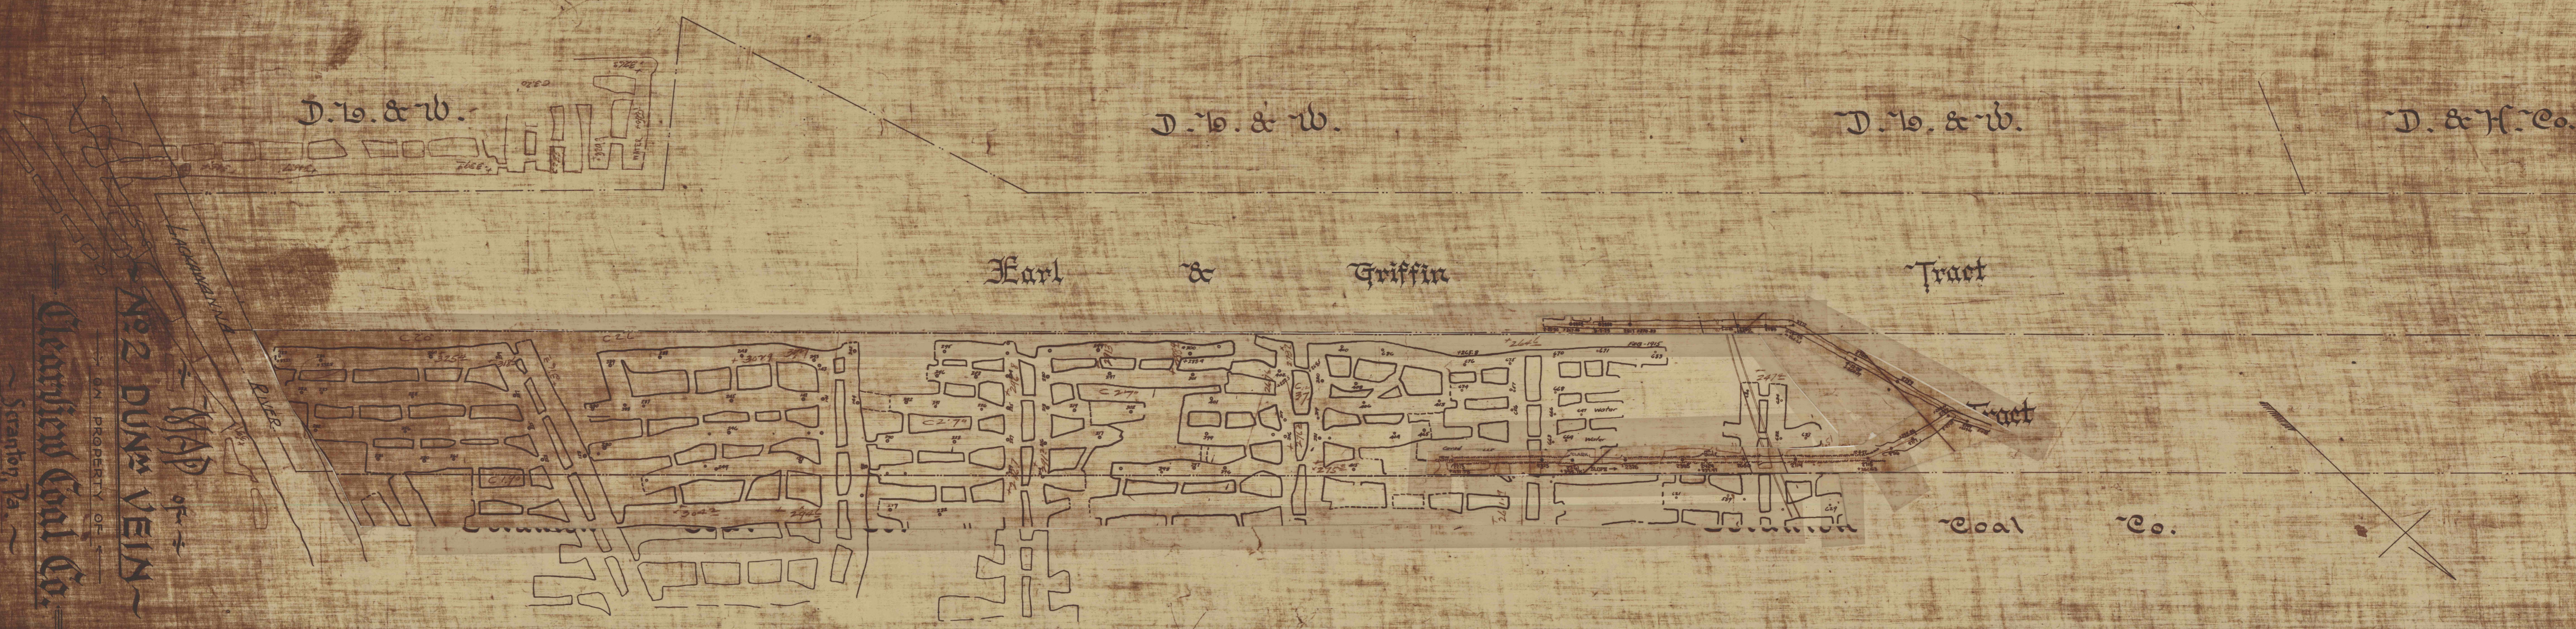

ON PROPERTY OF
 Scranton, Pa.

SCALE 100 FT.