


D. W. & W.

D. W. & W.

D. W. & W.

D. & H. Co.

Earl & Griffin Tract

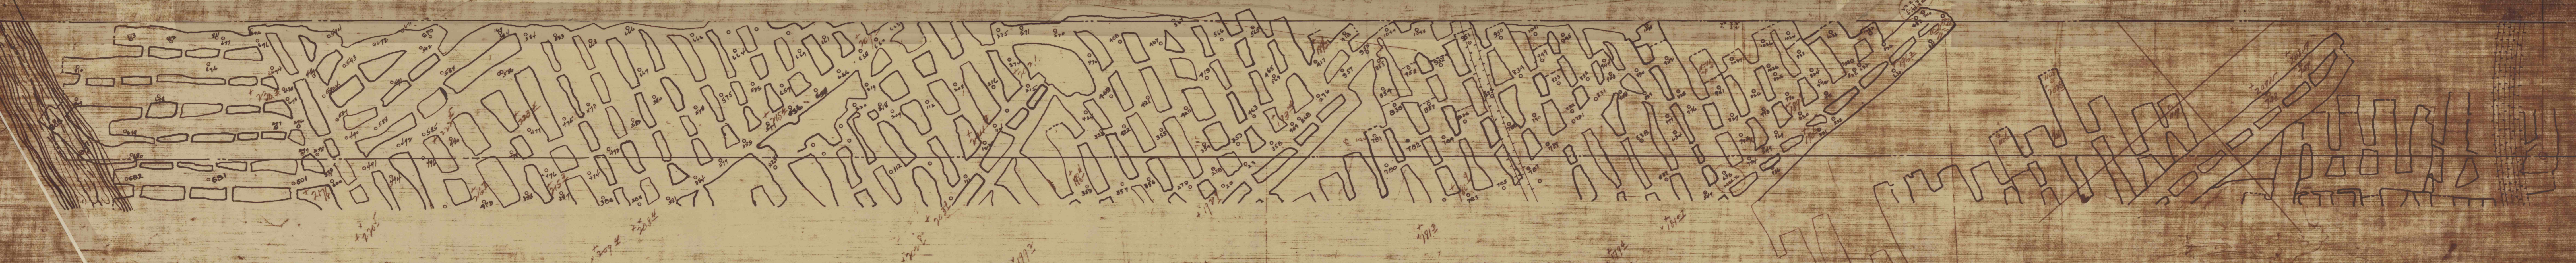

Property line Diamond rectangles 1/4 1/2 3/4 1/8 Inclusive

West Edge Shaft 207 1/2

ON PROPERTY OF  
 Swanton, Pa.  
 No. 3 DUNS VEIN  
 MAP OF  
 Georffrey Coal Co.

SCALE 100 FT.