

TRACING NO. 8

GEORGE VEIN  
NO. 1 VEIN

TRACING NO. 8



JOHN K. VALLANCE

SUS. C. CO. No 6

COLL. CO.

ANNAN  
SUSQUEHANNA

D. ROMBACH

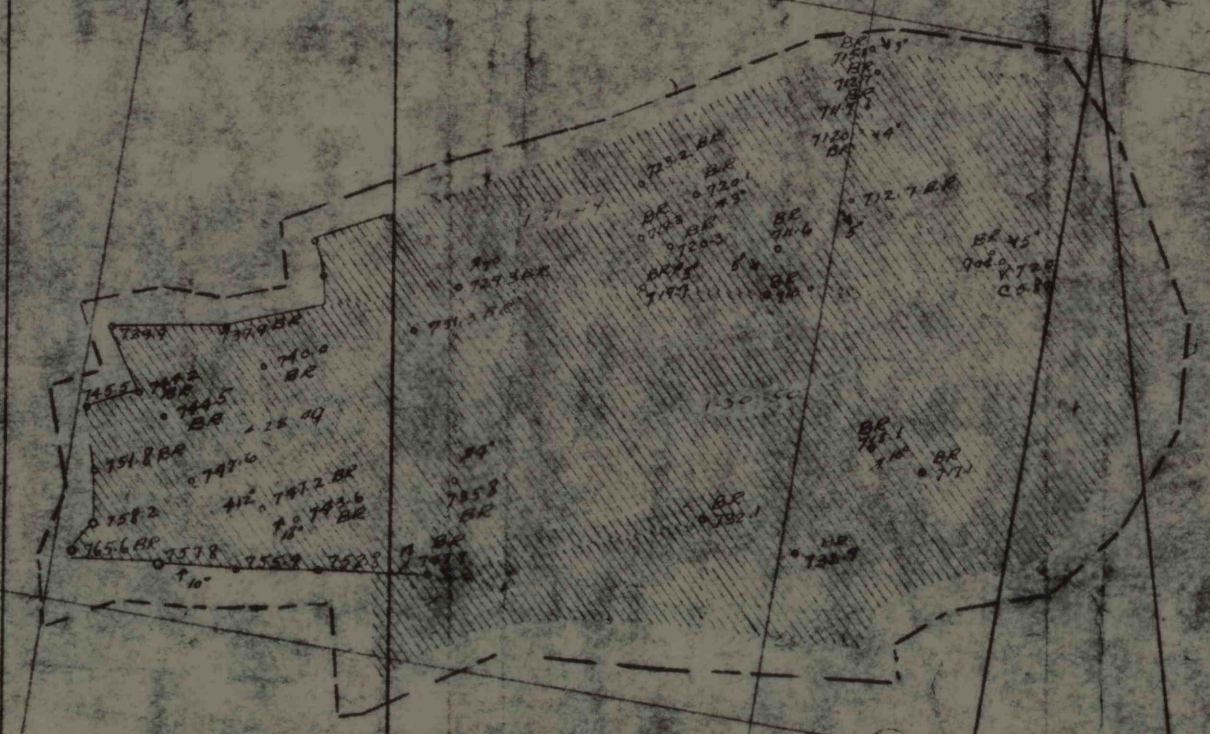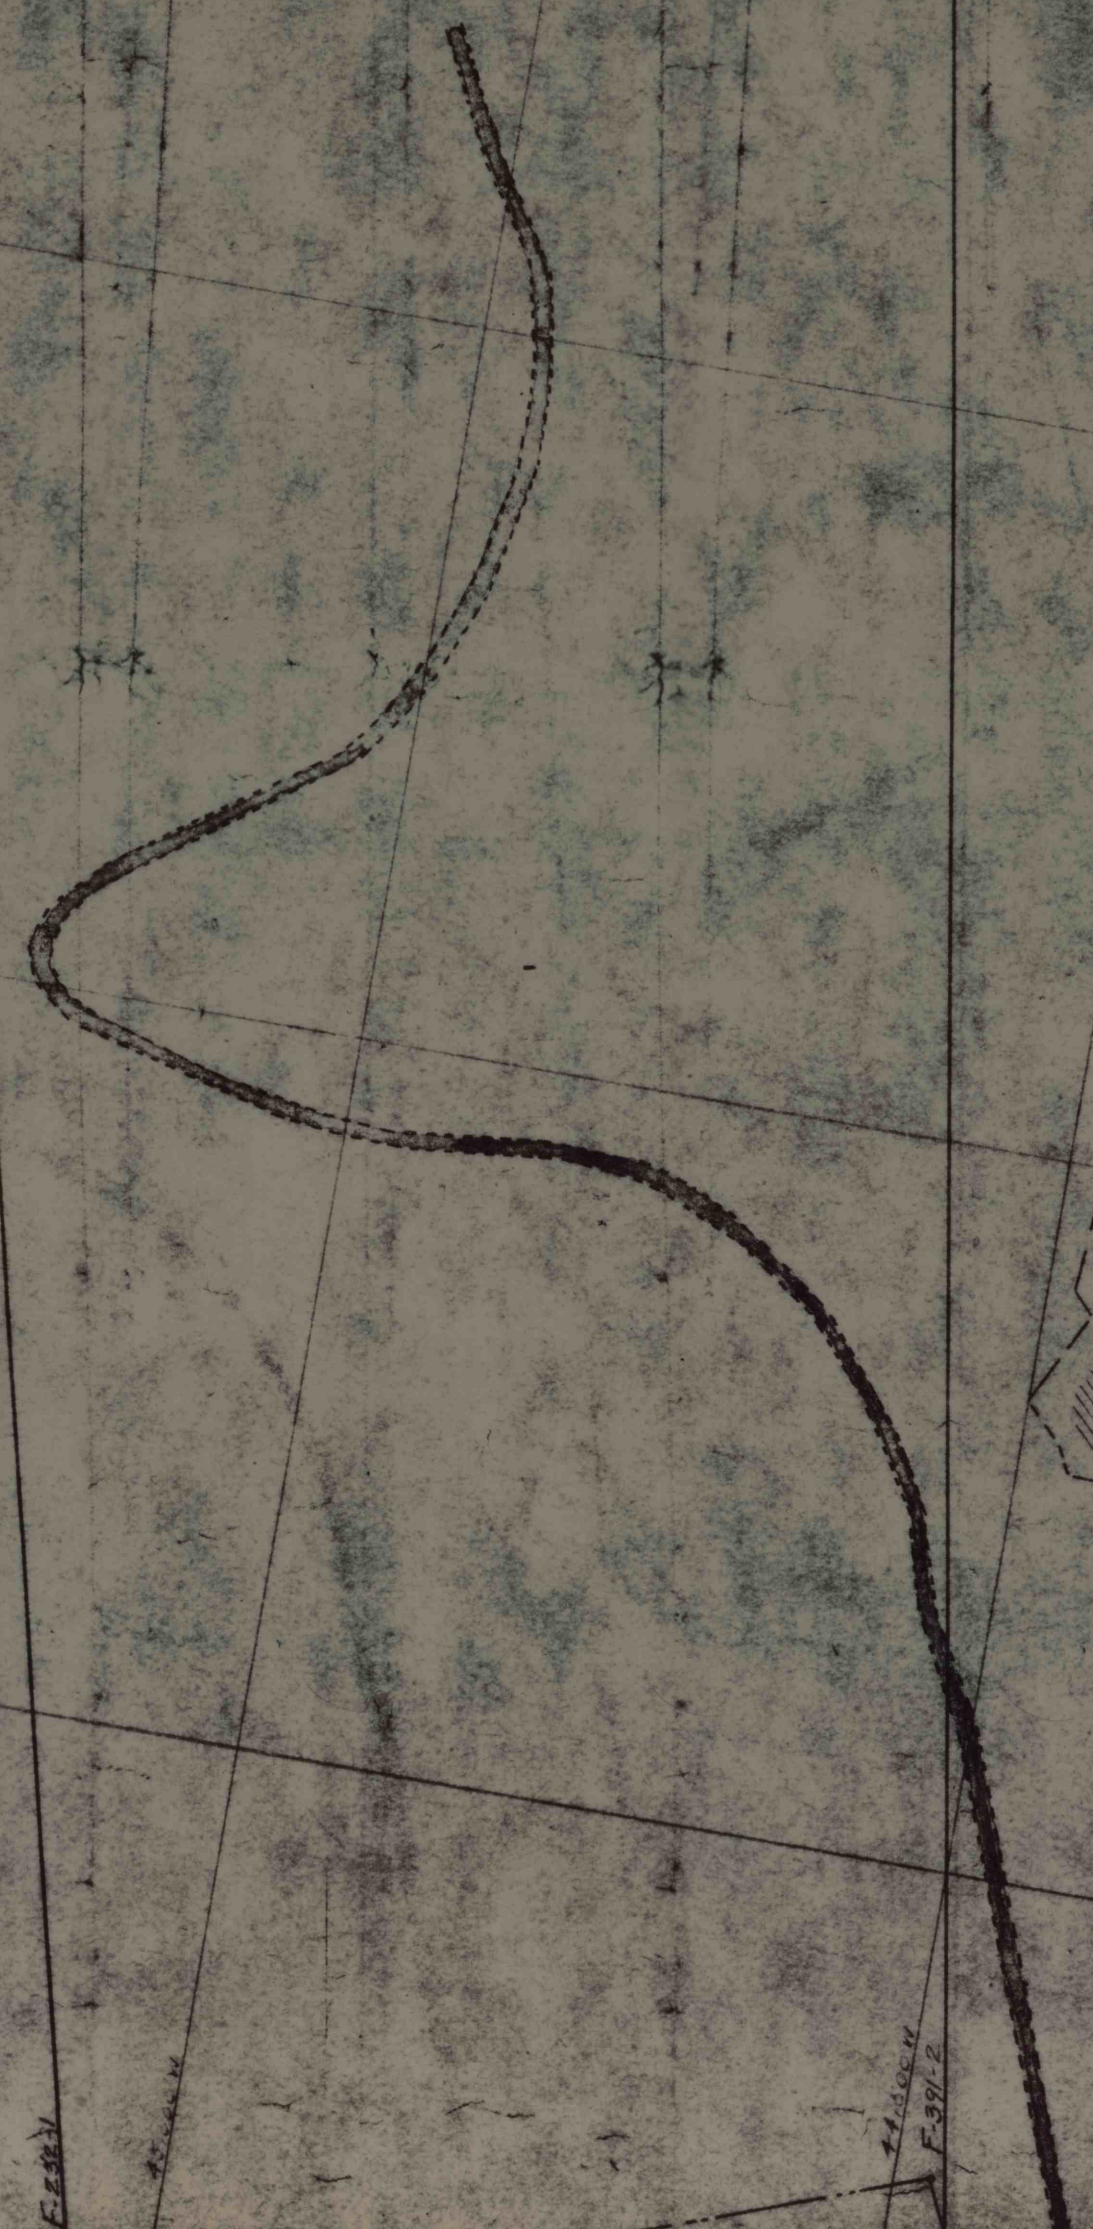

DDM 197  
DDM 199  
DDM 200  
DDM 201