



SEE NO. 4
NO. 5

ABBOTT VEIN

14

13

11

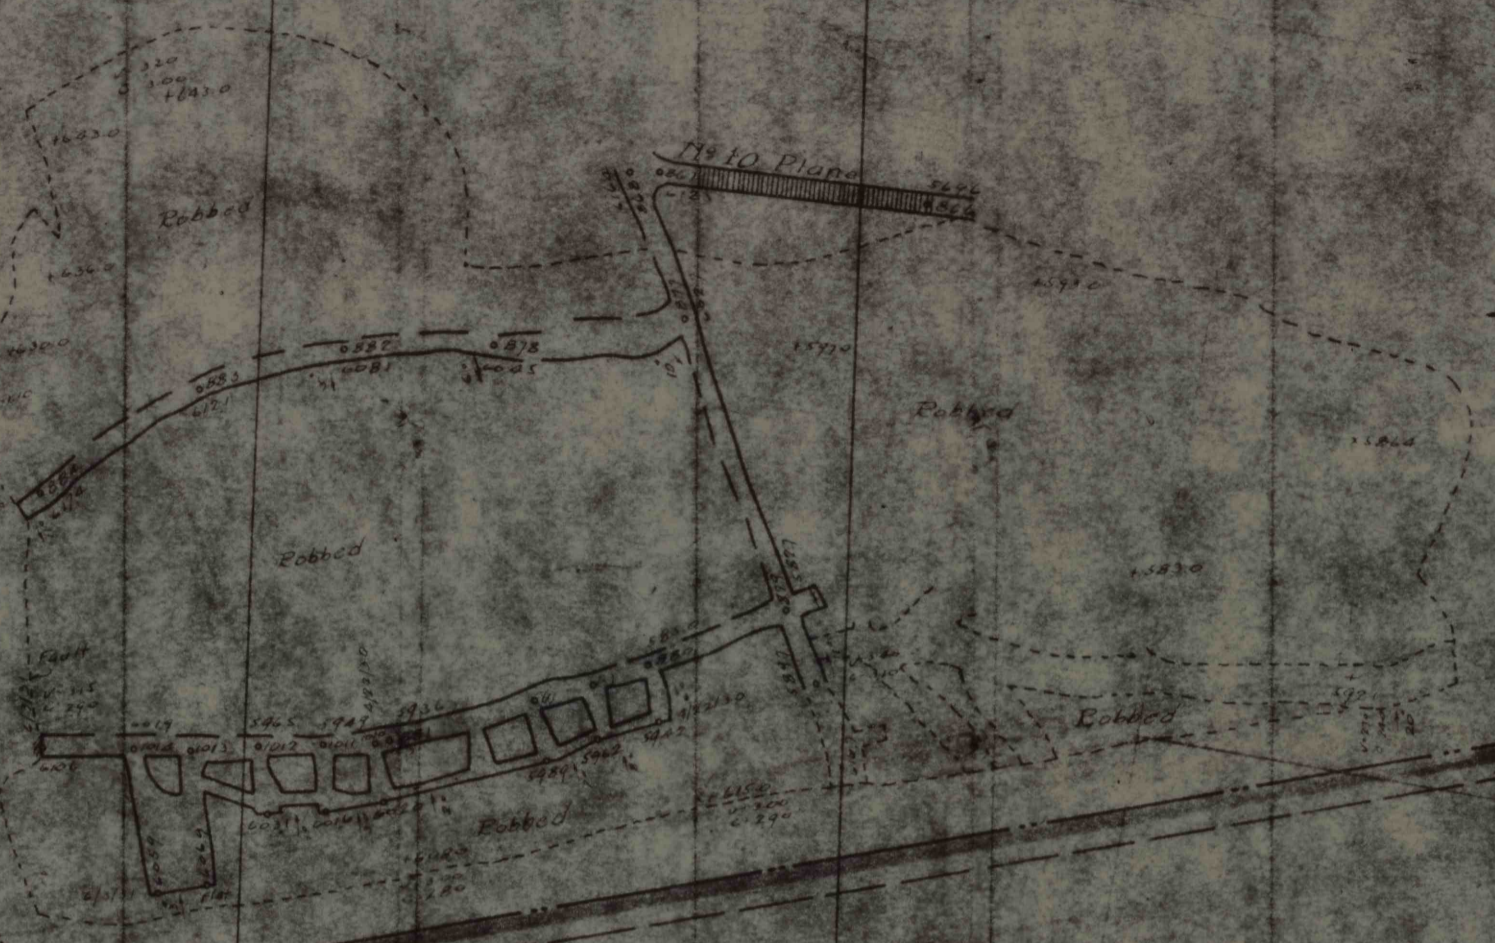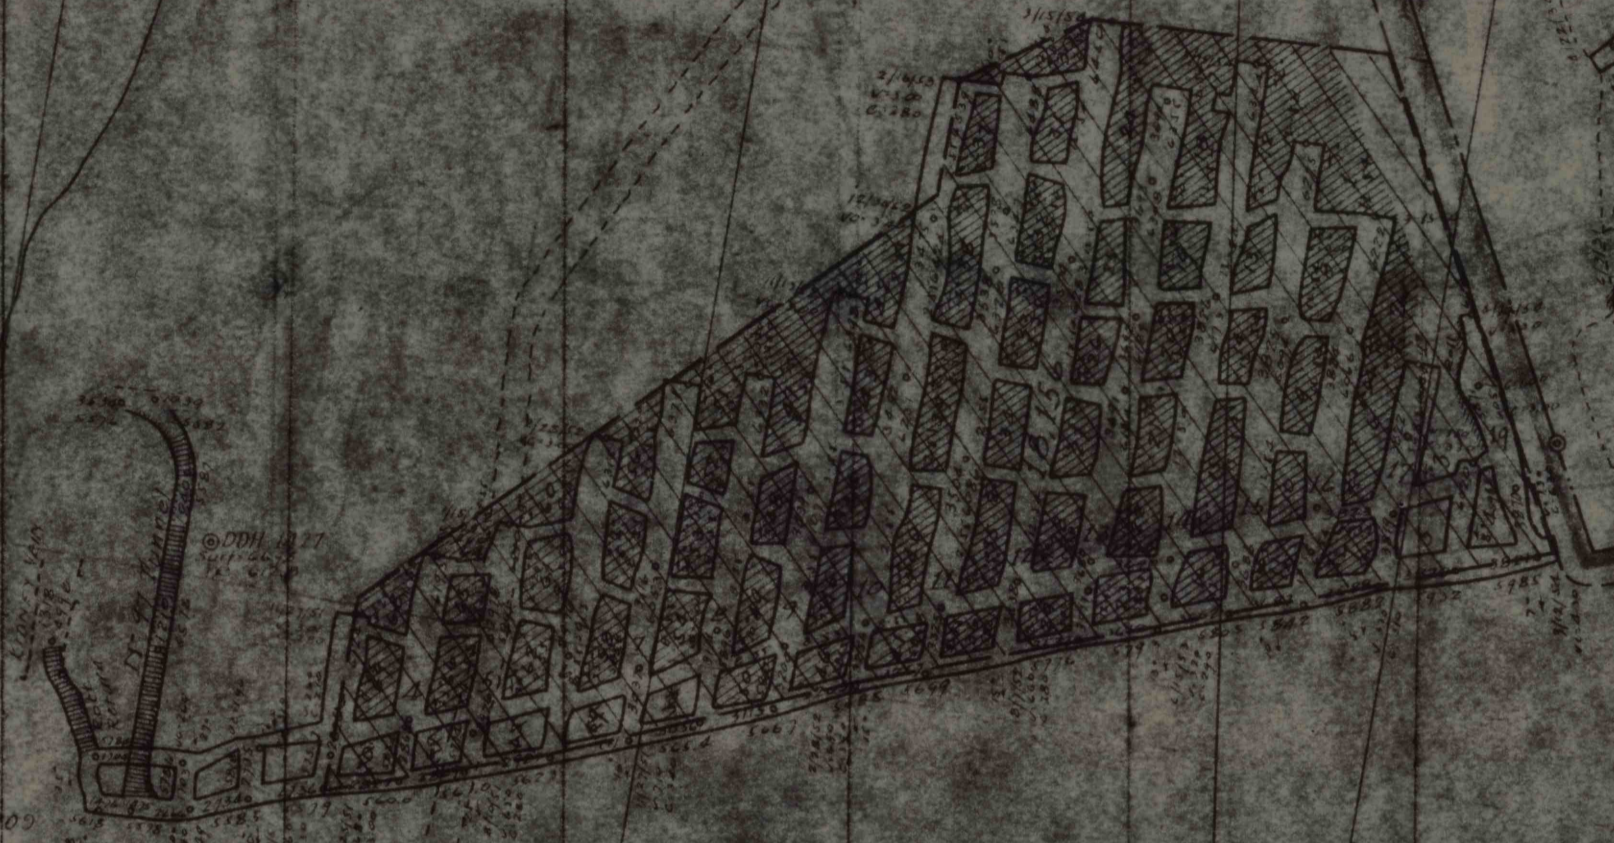

Abandoned By Auth. Of 1922

SEE NO. 4
NO. 5